
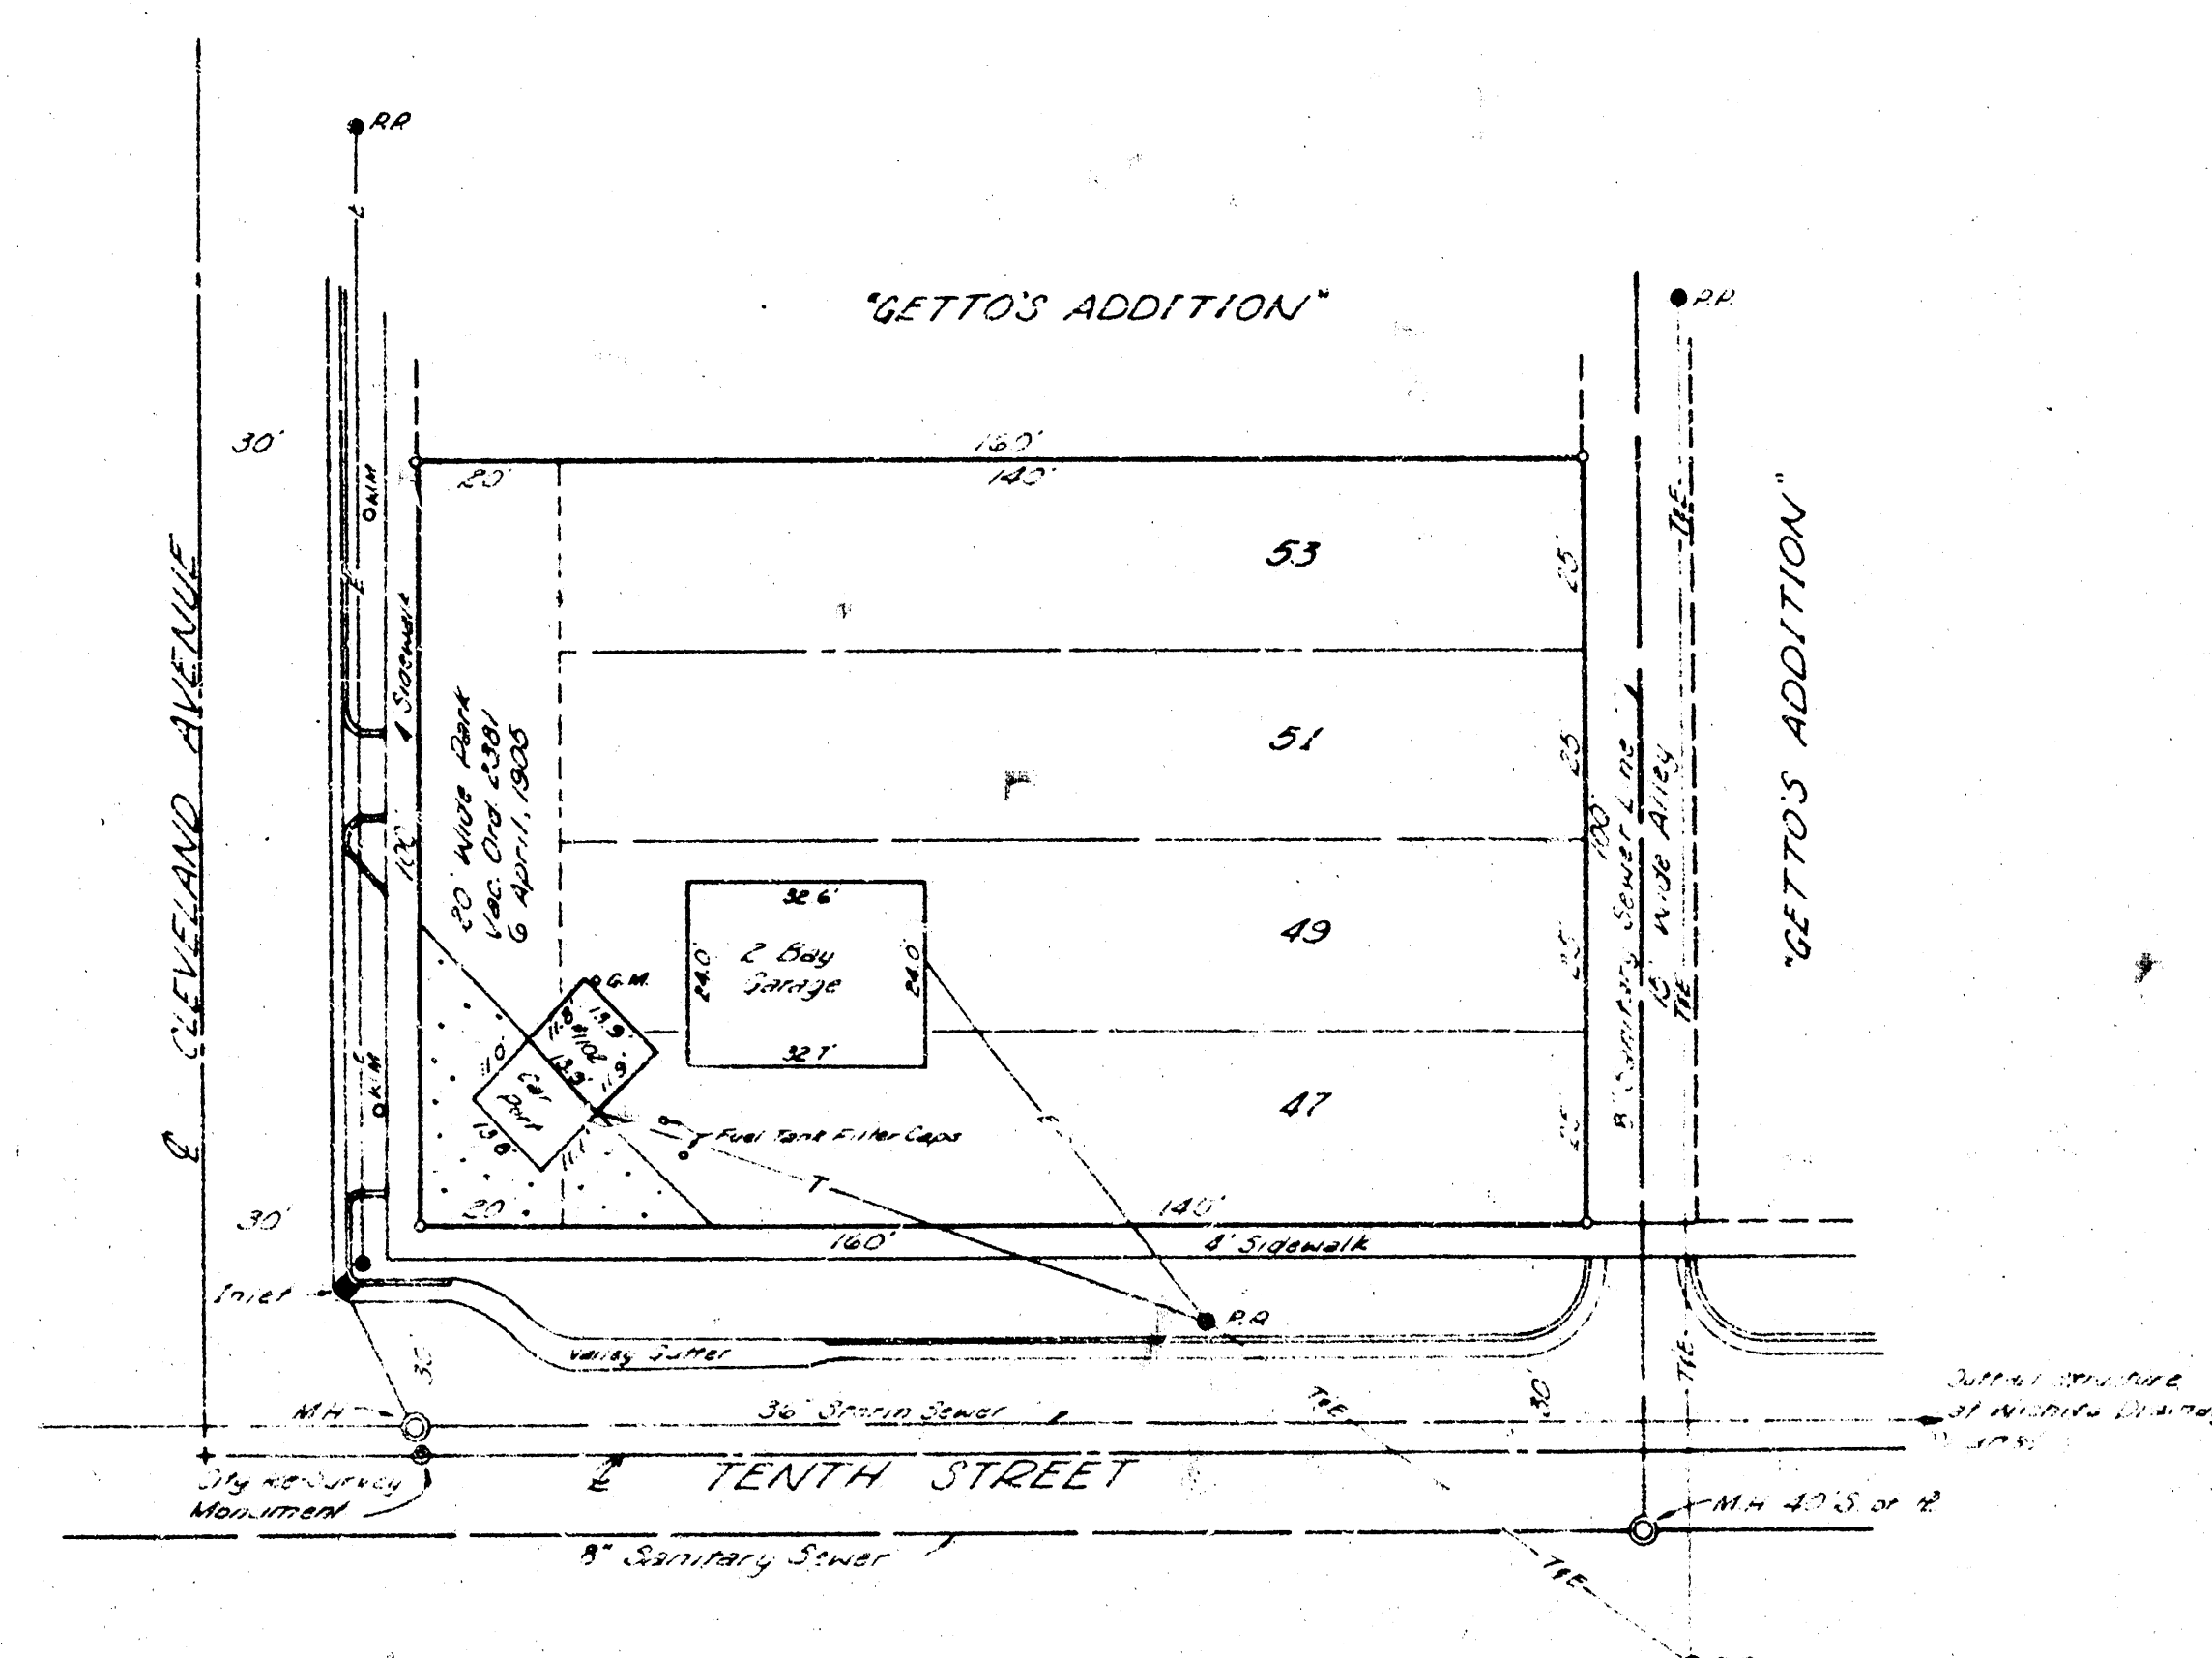


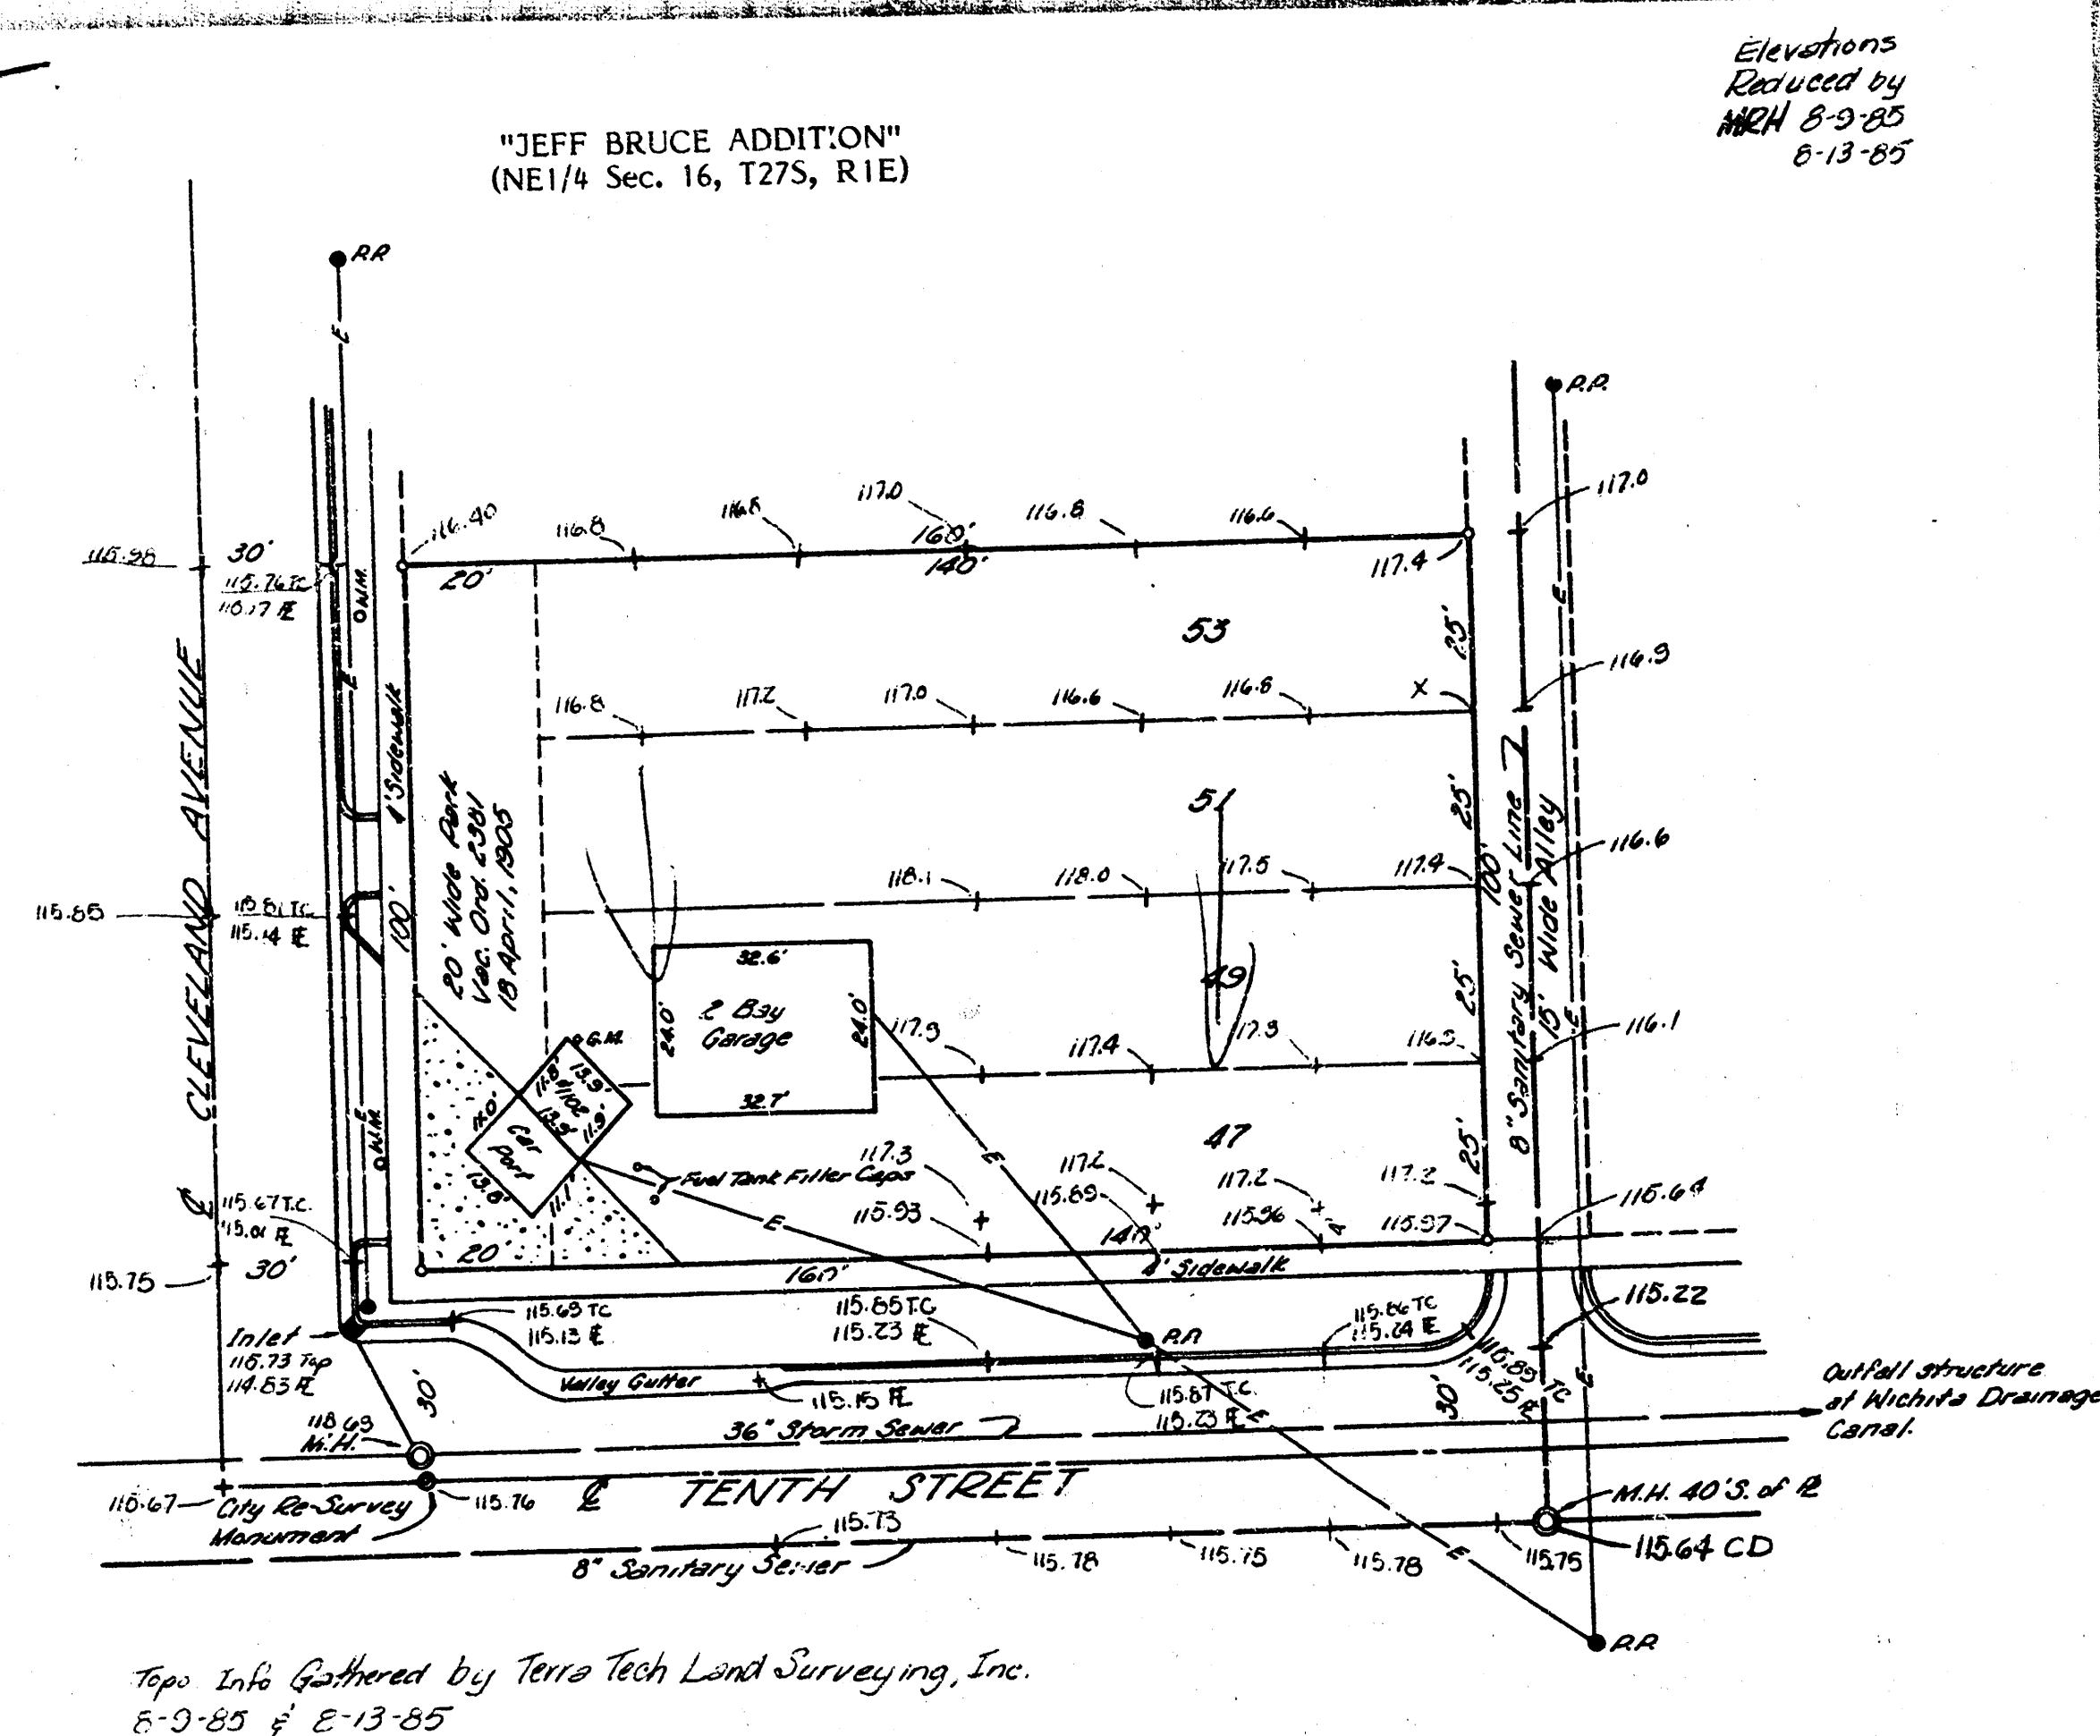

VICINITY MAP OF:
"JEFF BRUCE ADDITION"
WICHITA, SEDGWICK COUNTY, KANSAS
(NE 1/4 SEC. 16, T27S, R1E)
ASSOCIATED ZONING CASE Z-2658

OWNER/SUBDIVIDER:

JEFF BRUCE
1102 CLEVELAND
WICHITA, KANSAS 67214
TELE. 264-9698

LEGAL DESCRIPTION:

LOTS 47, 49, 51, 53 AND THE VACATED 20' WIDE PARK
ADJOINING ON THE WEST, ON CLEVELAND AVENUE, IN
"GETTO'S ADDITION" TO THE CITY OF WICHITA, KANSAS.

TERRA TECH
LAND SURVEYING, INC.

245 West Dewey
Wichita, Kansas 67202-3607
(316) 267-0744 / 267-2348

PRELIMINARY
FOR INFORMATION ONLY

SHD AUG 13 1985

FILMED FROM THE BEST
AVAILABLE COPY.....