


CARPENTERS LOCAL UNION NO. 201 ADDITION
(Drainage)

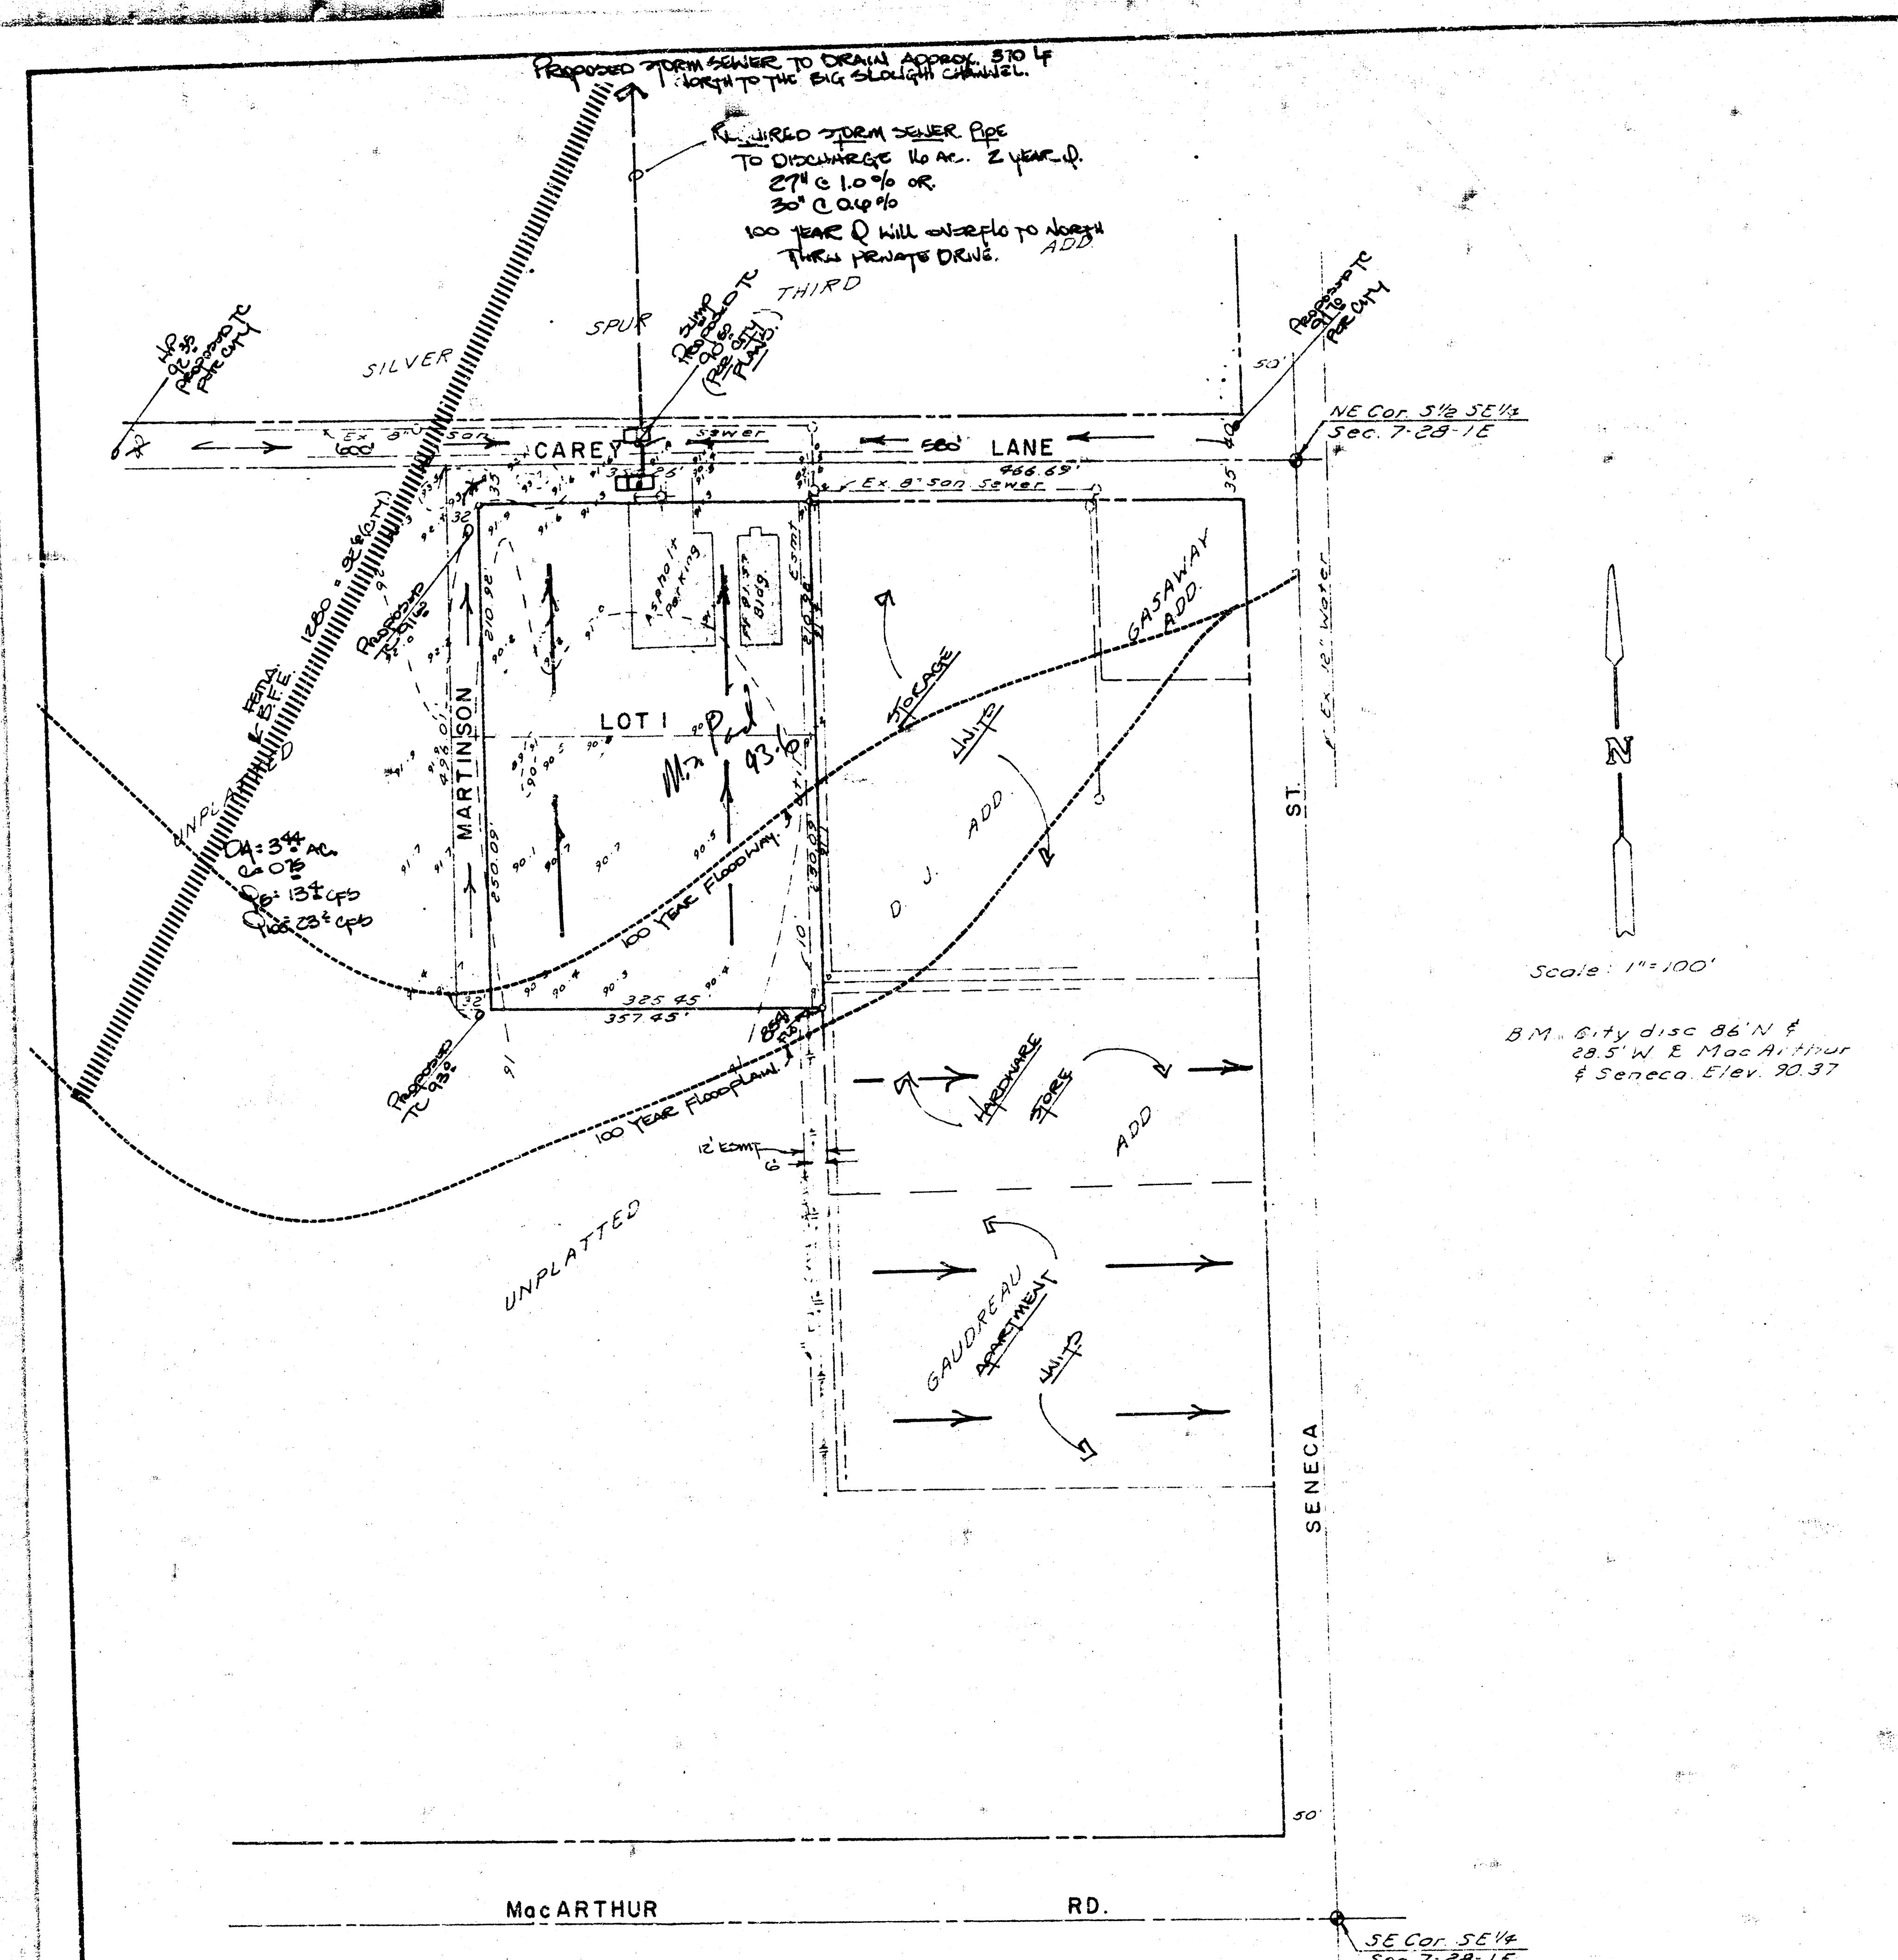

Scale: 1"=100'

B.M. City disc 86' N &
28.5' W E MacArthur
& Seneca Elev. 90.37

SKETCH PLAT
CARPENTERS LOCAL UNION NO. 201 ADDITION

PART OF SE 1/4 OF SEC. 7-28-1E & A REPLAT OF LOT 1,
REVIVAL ROAD BAPTIST CHURCH ADD.

DRAINAGE PLAN

Apr. 1, 1985

ED BAUGHMAN COMPANY, P.A.
SURVEYING & ENGINEERING

FILMED FROM THE BEST
AVAILABLE COPY....