


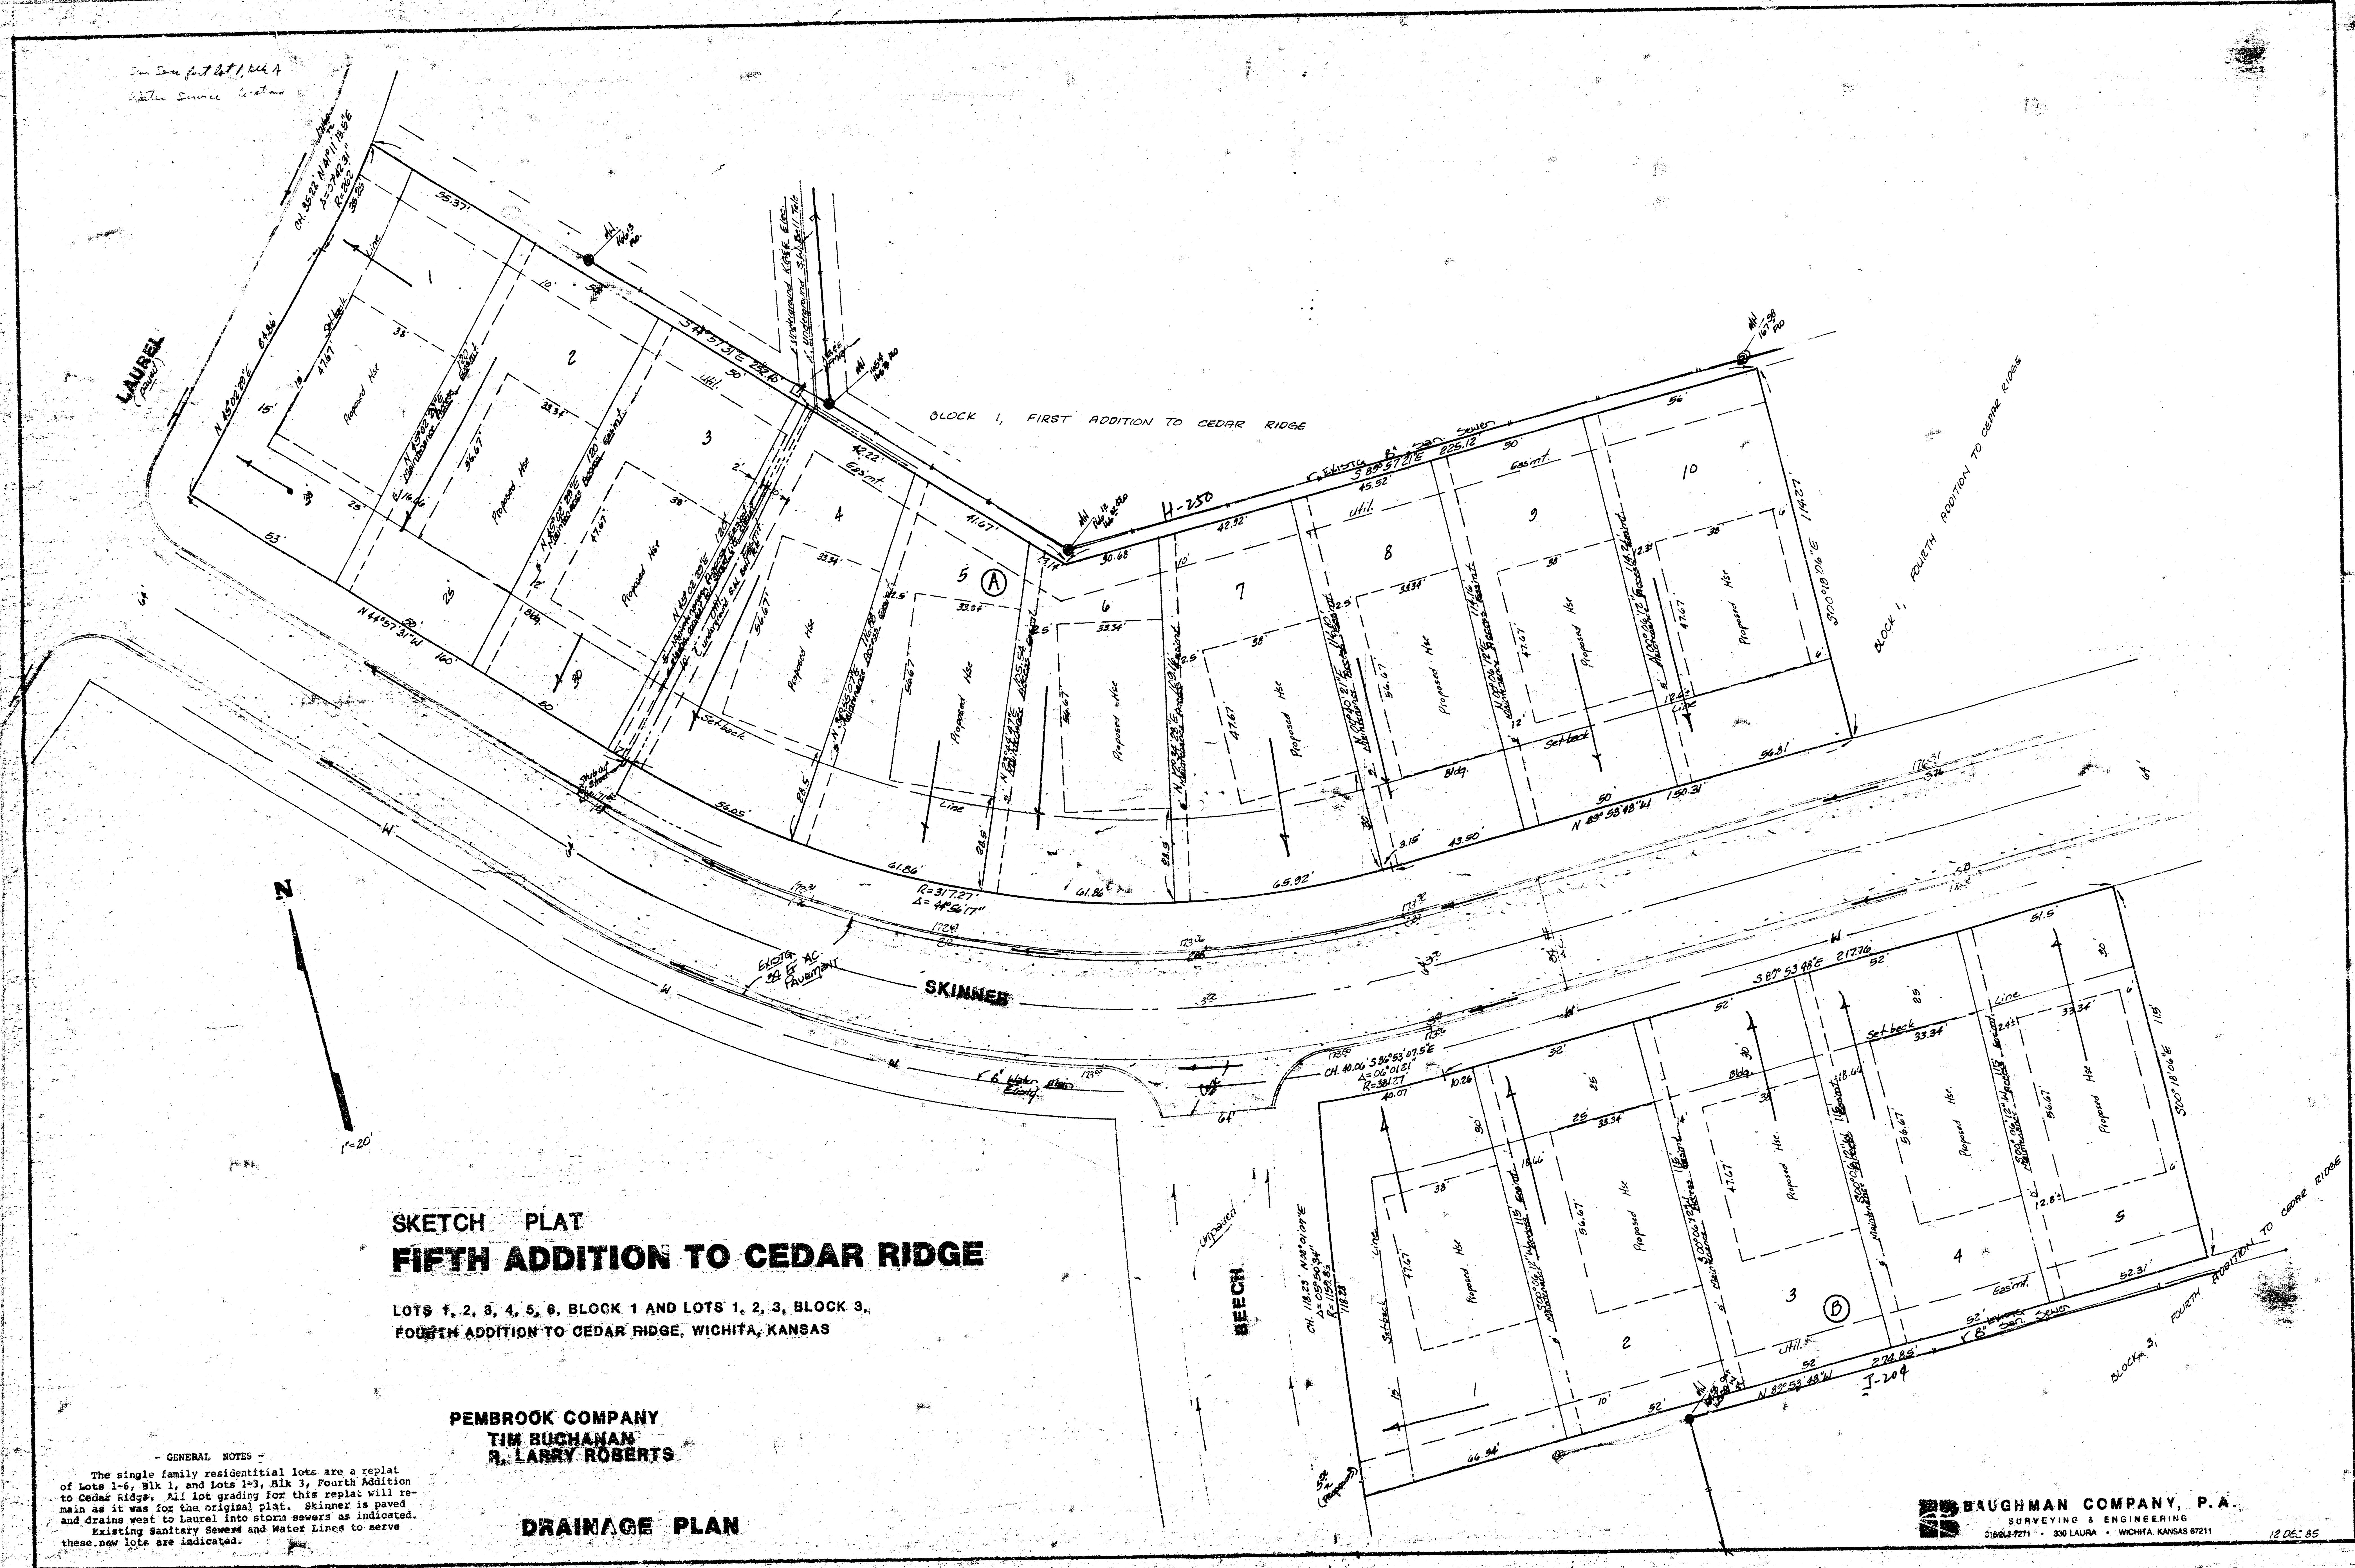

SKETCH PLAT
FIFTH ADDITION TO CEDAR RIDGE

LOTS 1, 2, 8, 4, 5, 6, BLOCK 1 AND LOTS 1, 2, 3, BLOCK 3,
FOURTH ADDITION TO CEDAR RIDGE, WICHITA, KANSAS

PEMBROOK COMPANY
TIM BUCHANAN
LARRY ROBERTS

DRAINAGE PLAN

GENERAL NOTES
The single family residential lots are a replat of Lots 1-6, Blk 1, and Lots 1-3, Blk 3, Fourth Addition to Cedar Ridge. All lot grading for this replat will remain as it was for the original plat. Skinner is paved and drains west to Laurel into storm sewers as indicated. Existing Sanitary Sewers and Water Lines to serve these new lots are indicated.

BAUGHMAN COMPANY, P.A.
SURVEYING & ENGINEERING
318 S. LAURA • WICHITA, KANSAS 67211

12 DEC 85