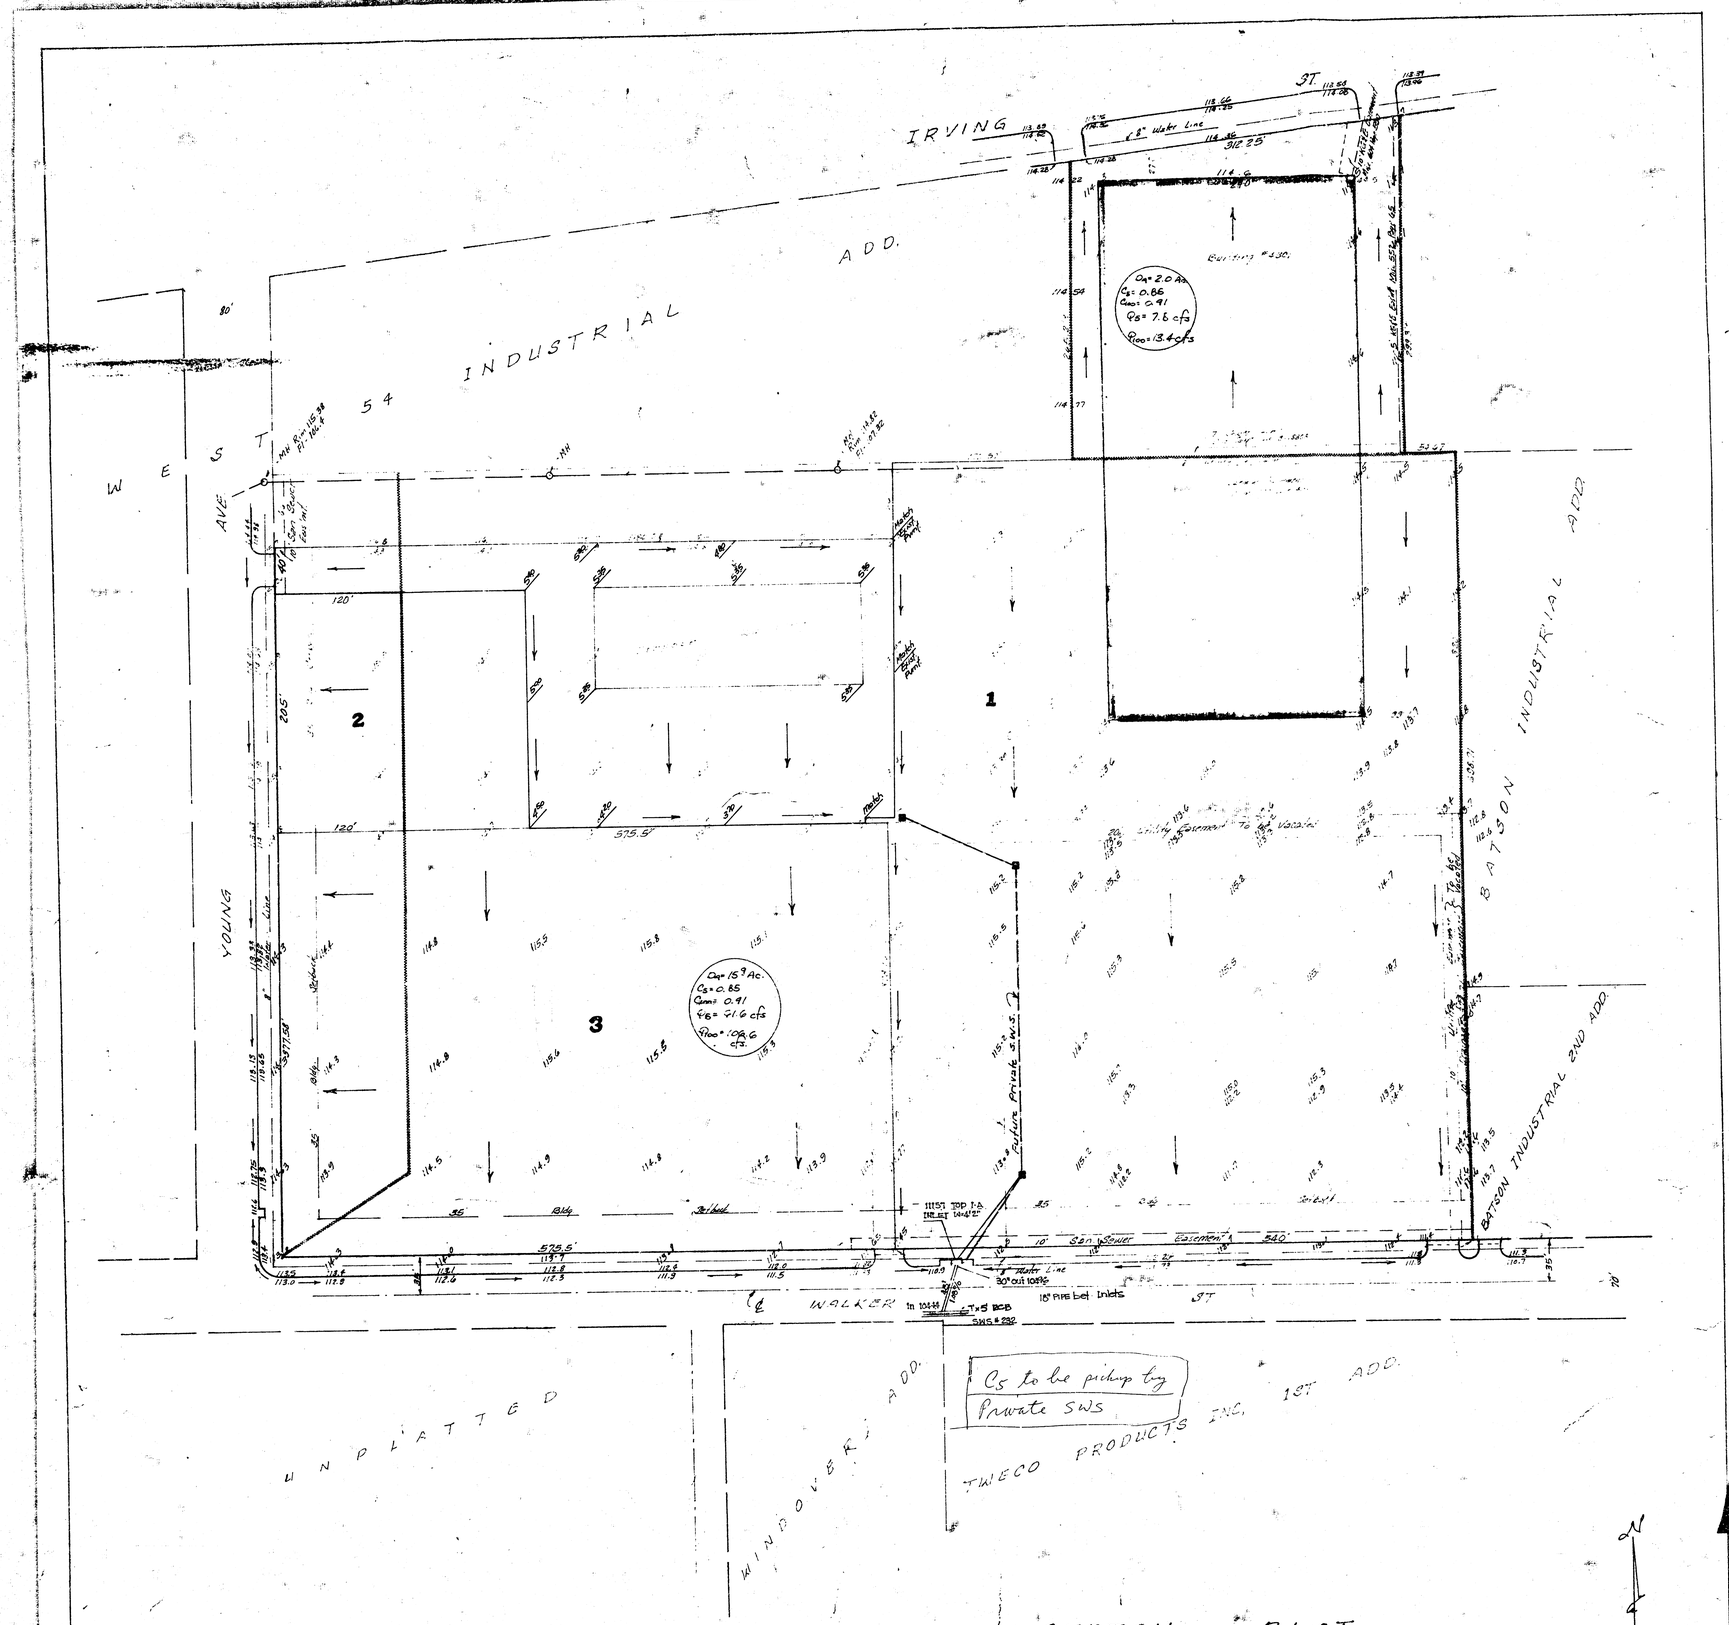


SKETCH PLAT

CHANCE INDUSTRIAL 2ND ADD.

Being a Replat of Lots 5 & 6 Block "A" of 54 Industrial Addition, the North 119.8 feet of the North 320 feet of Lot 4, except the North 66 feet of the West 580 feet thereof, Batson Industrial Addition and Lots 1-2-3-4-5-6-7 Chance Industrial Park, Wichita, Kansas.

CHANCE PROPERTIES - CITY OF WICHITA **DRAINAGE PLAN** 12/22/81 12-17-81