



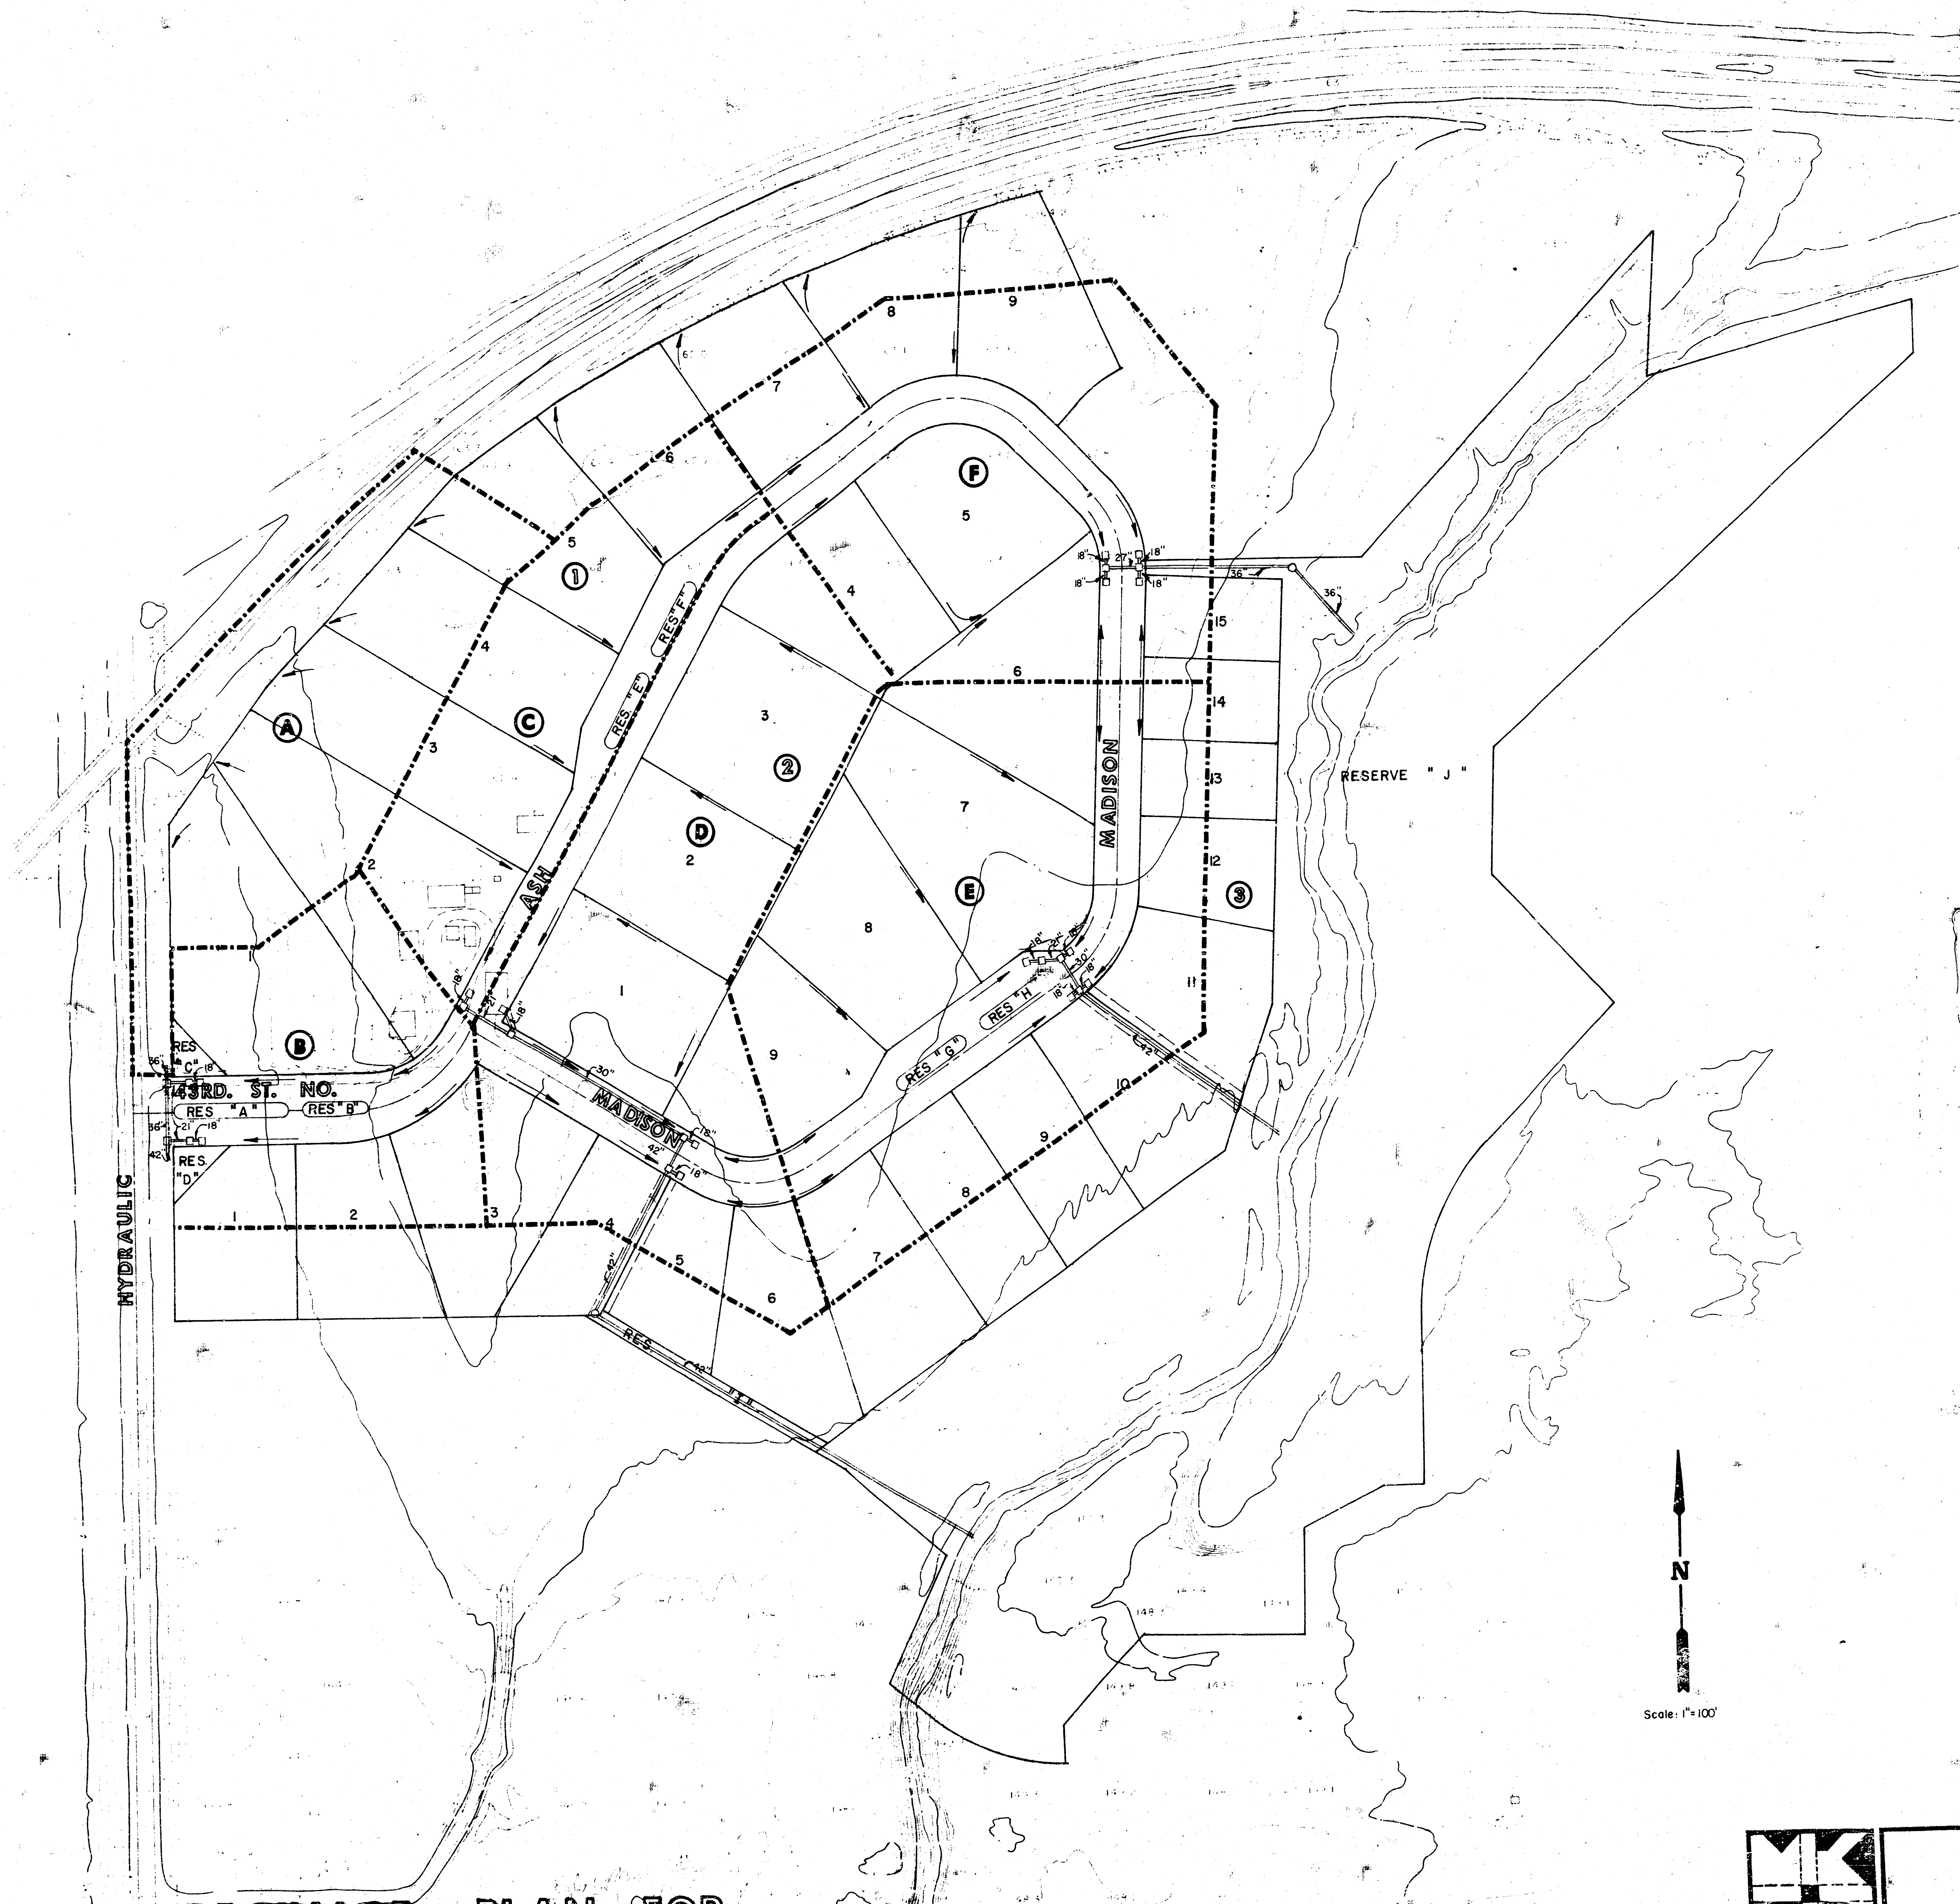

DRAINAGE PLAN FOR CHISHOLM CREEK COMMERCE CENTER

	Drawn by Checked by Date Job No.
	MID-KANSAS ENGINEERING CONSULTANTS PA 240 NORTH ROCK ROAD SUITE 130 WICHITA, KANSAS 67206
	682-6561
	Sheet of

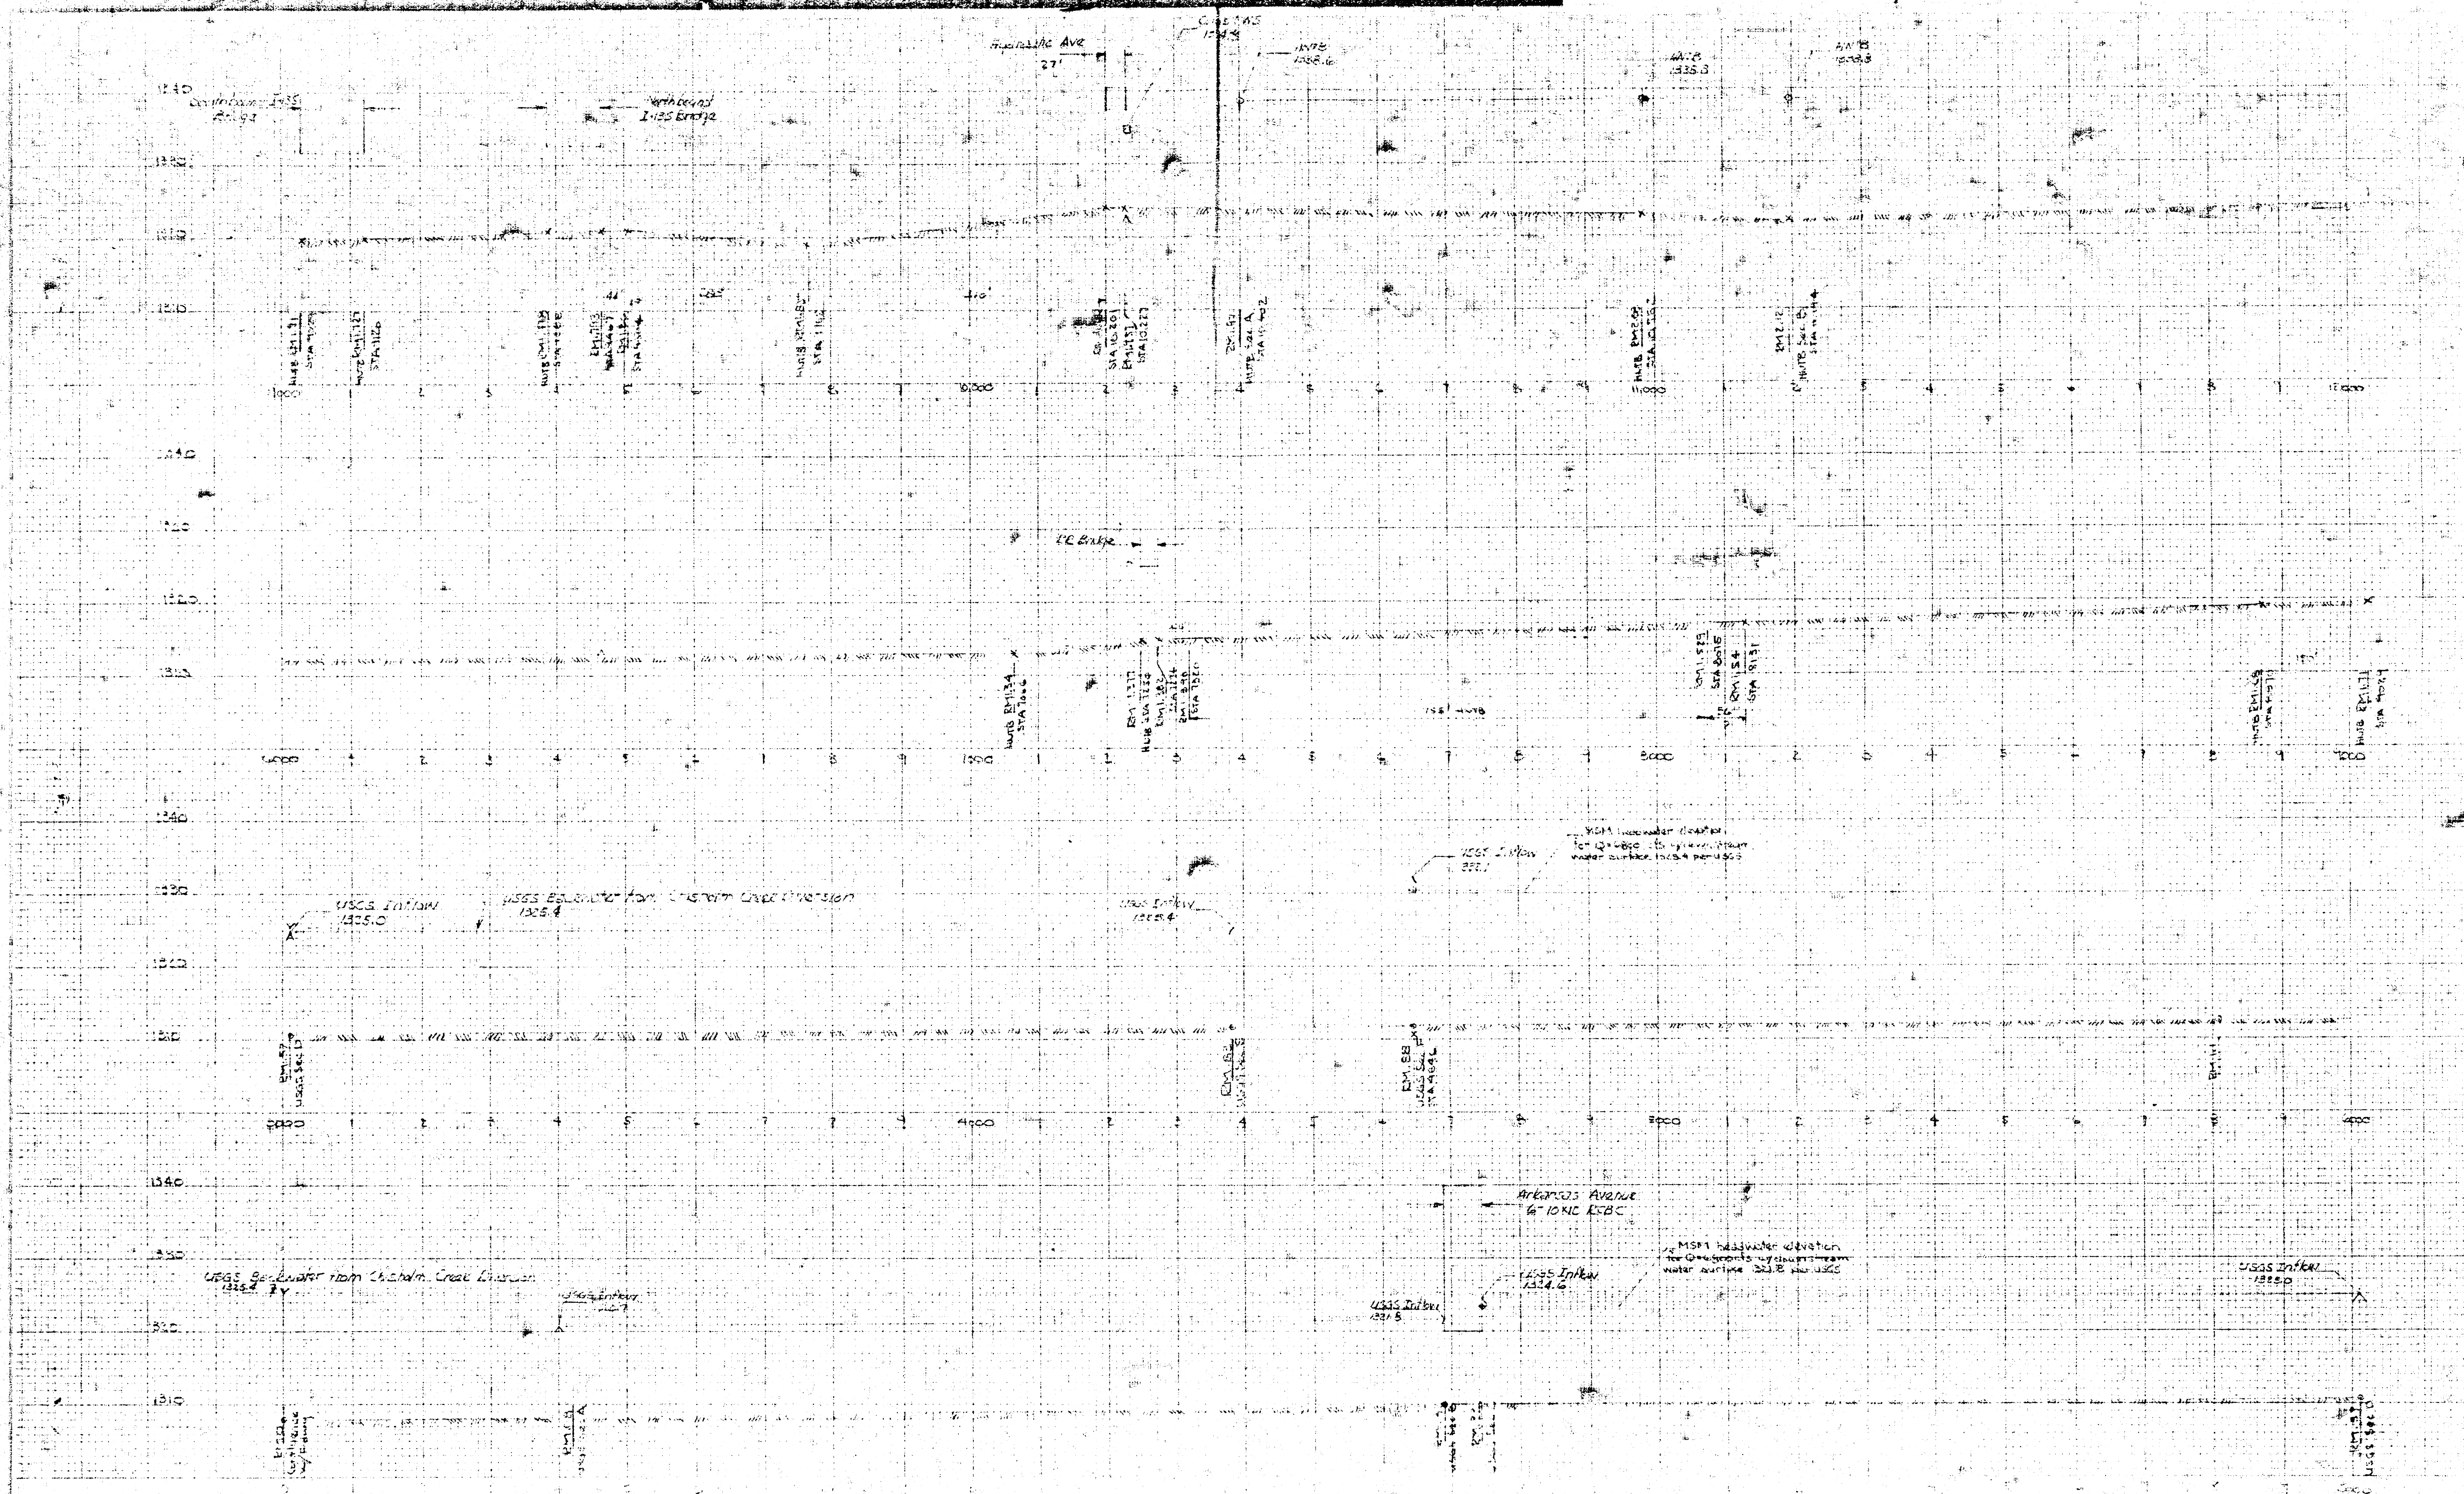

													Proposed Sew. Slope	Pipe Size & Slope	Notes in Sump
STATION	AREA	AREA	T _c	C	L _c	L ₁₀₀	Q _c	Q ₁₀₀	Q ₂	Q ₁₀	Q ₅	Q ₂			
1	1.84 (1.0) TP														
2															
3															





CHISHOLM CREEK COMMERCE CENTER
(DRAINAGE)

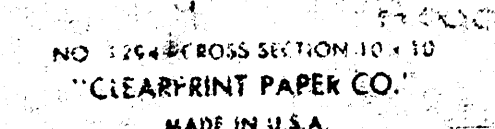


FILMED FROM THE BEST
AVAILABLE COPY

CHISHOLM CREEK COMMERCE CENTER
(DRAINAGE)

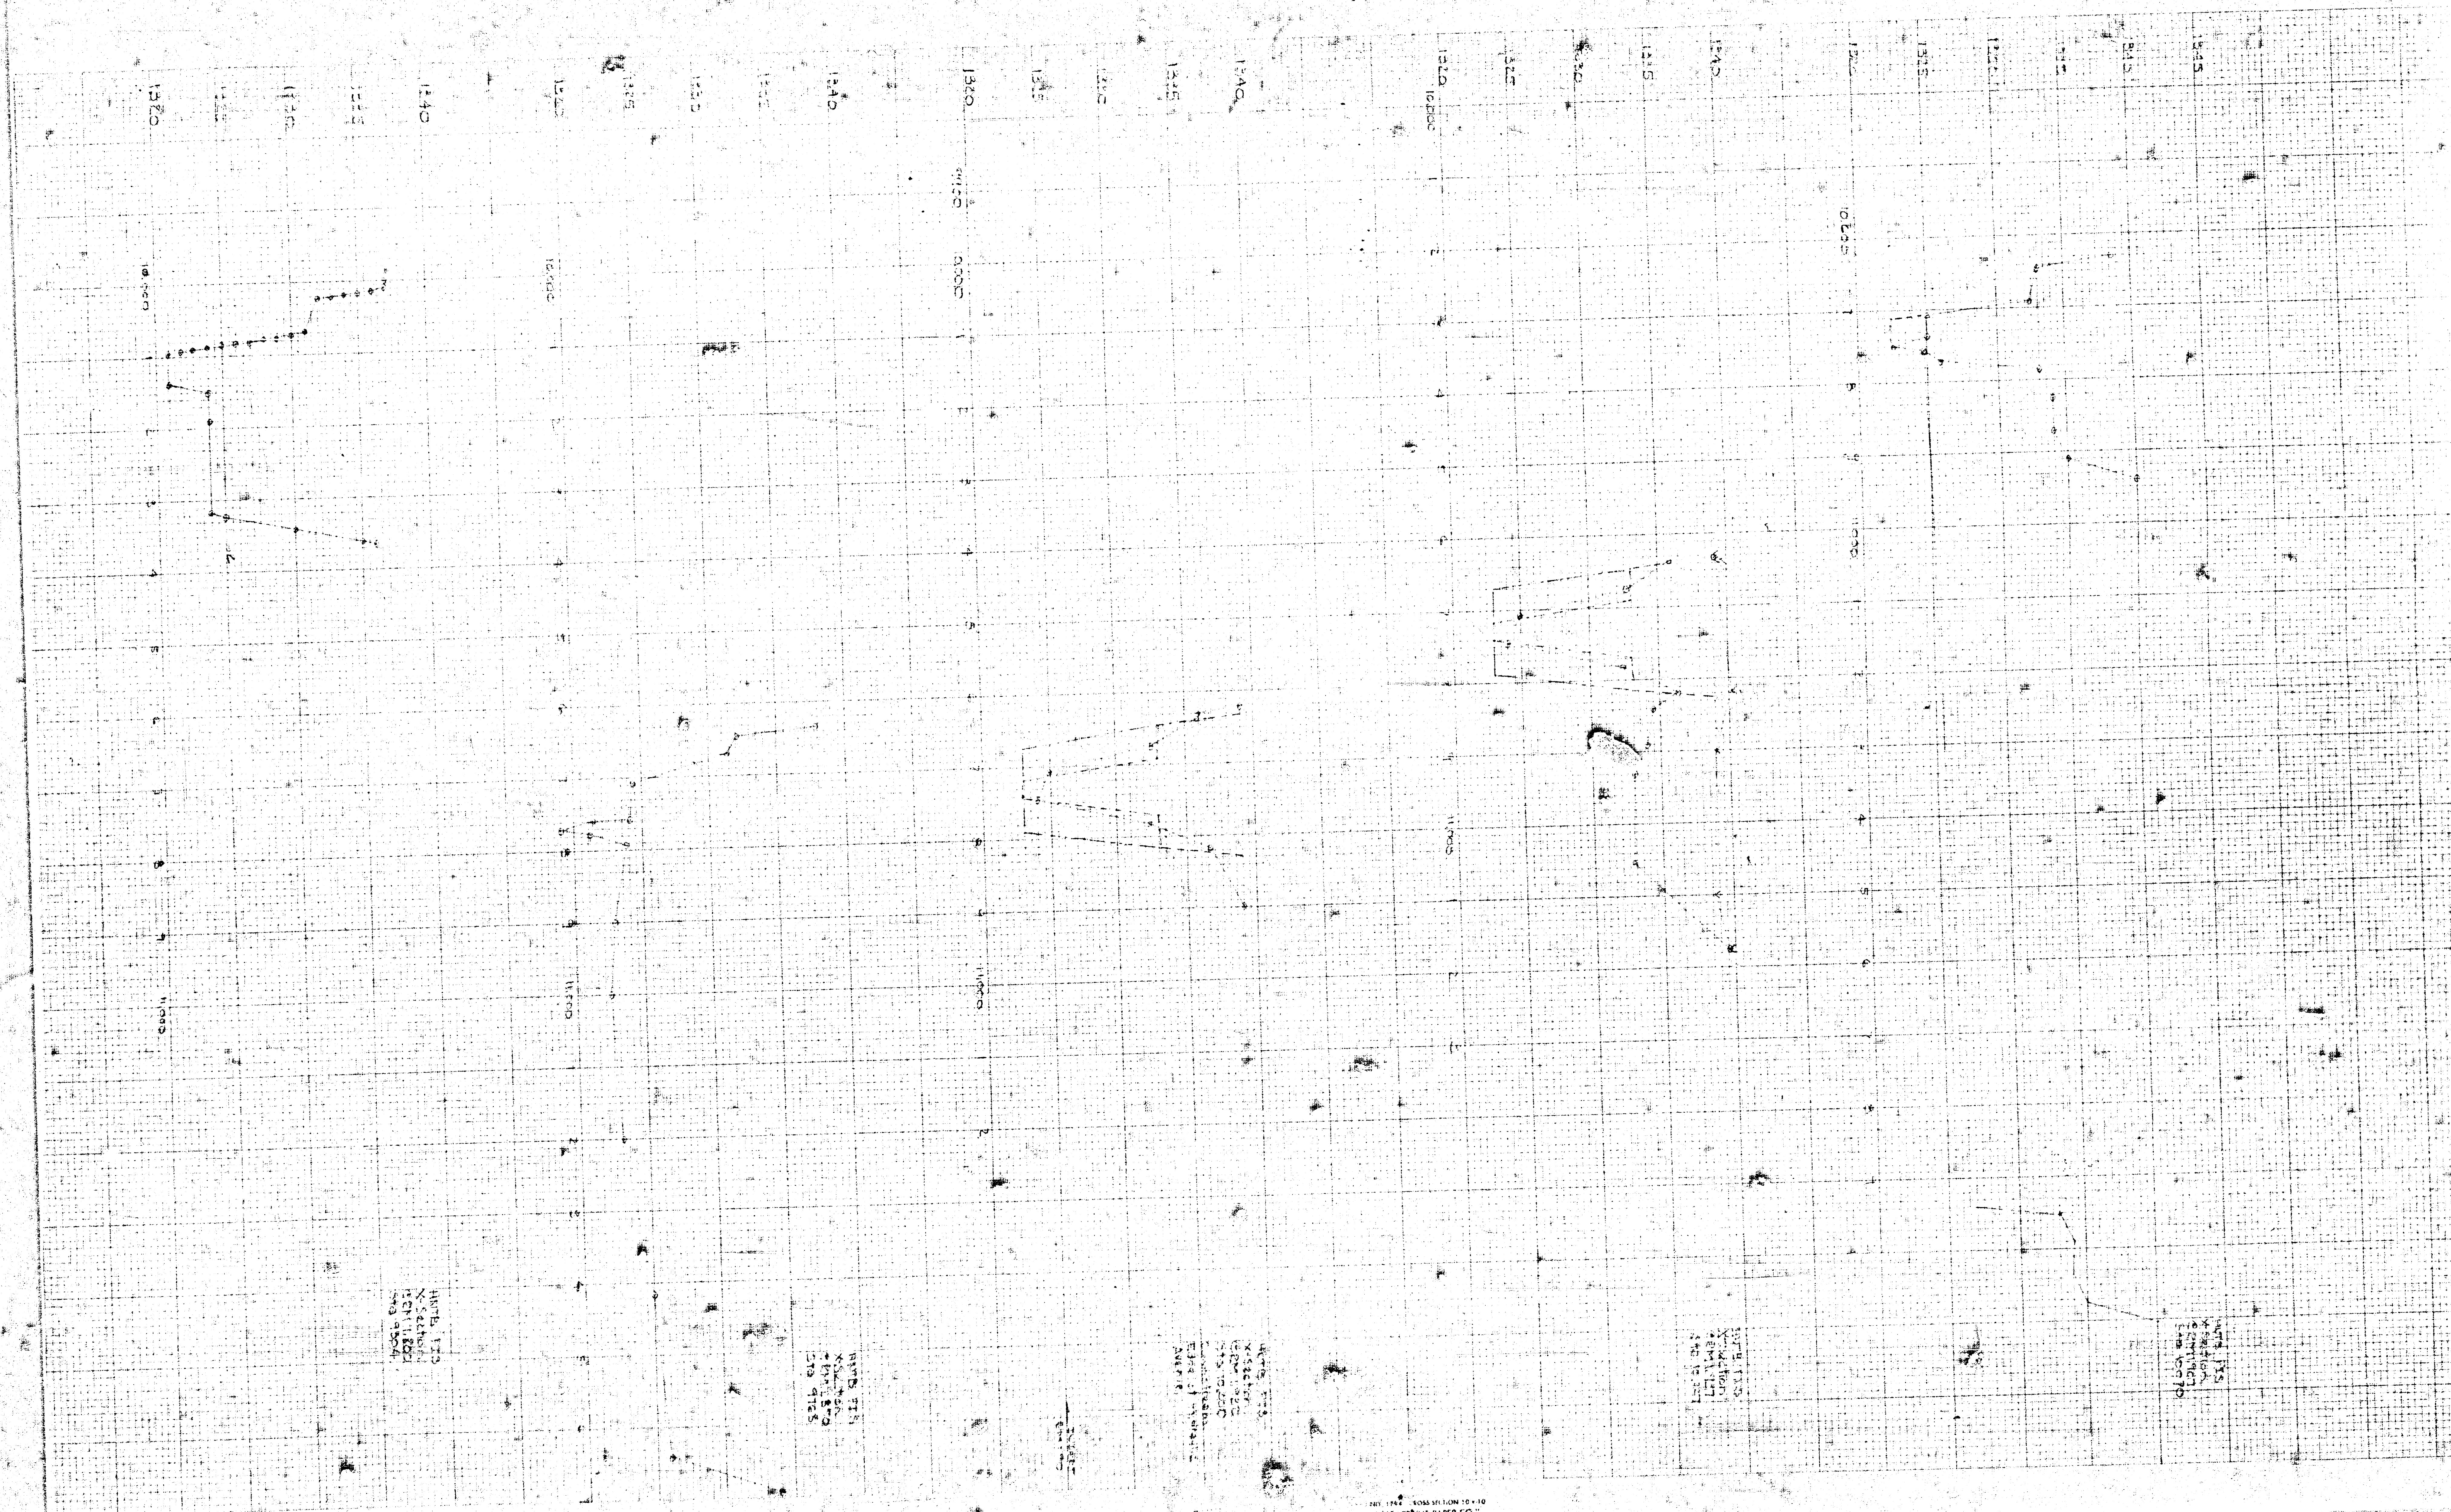


7-11-68
7-11-68

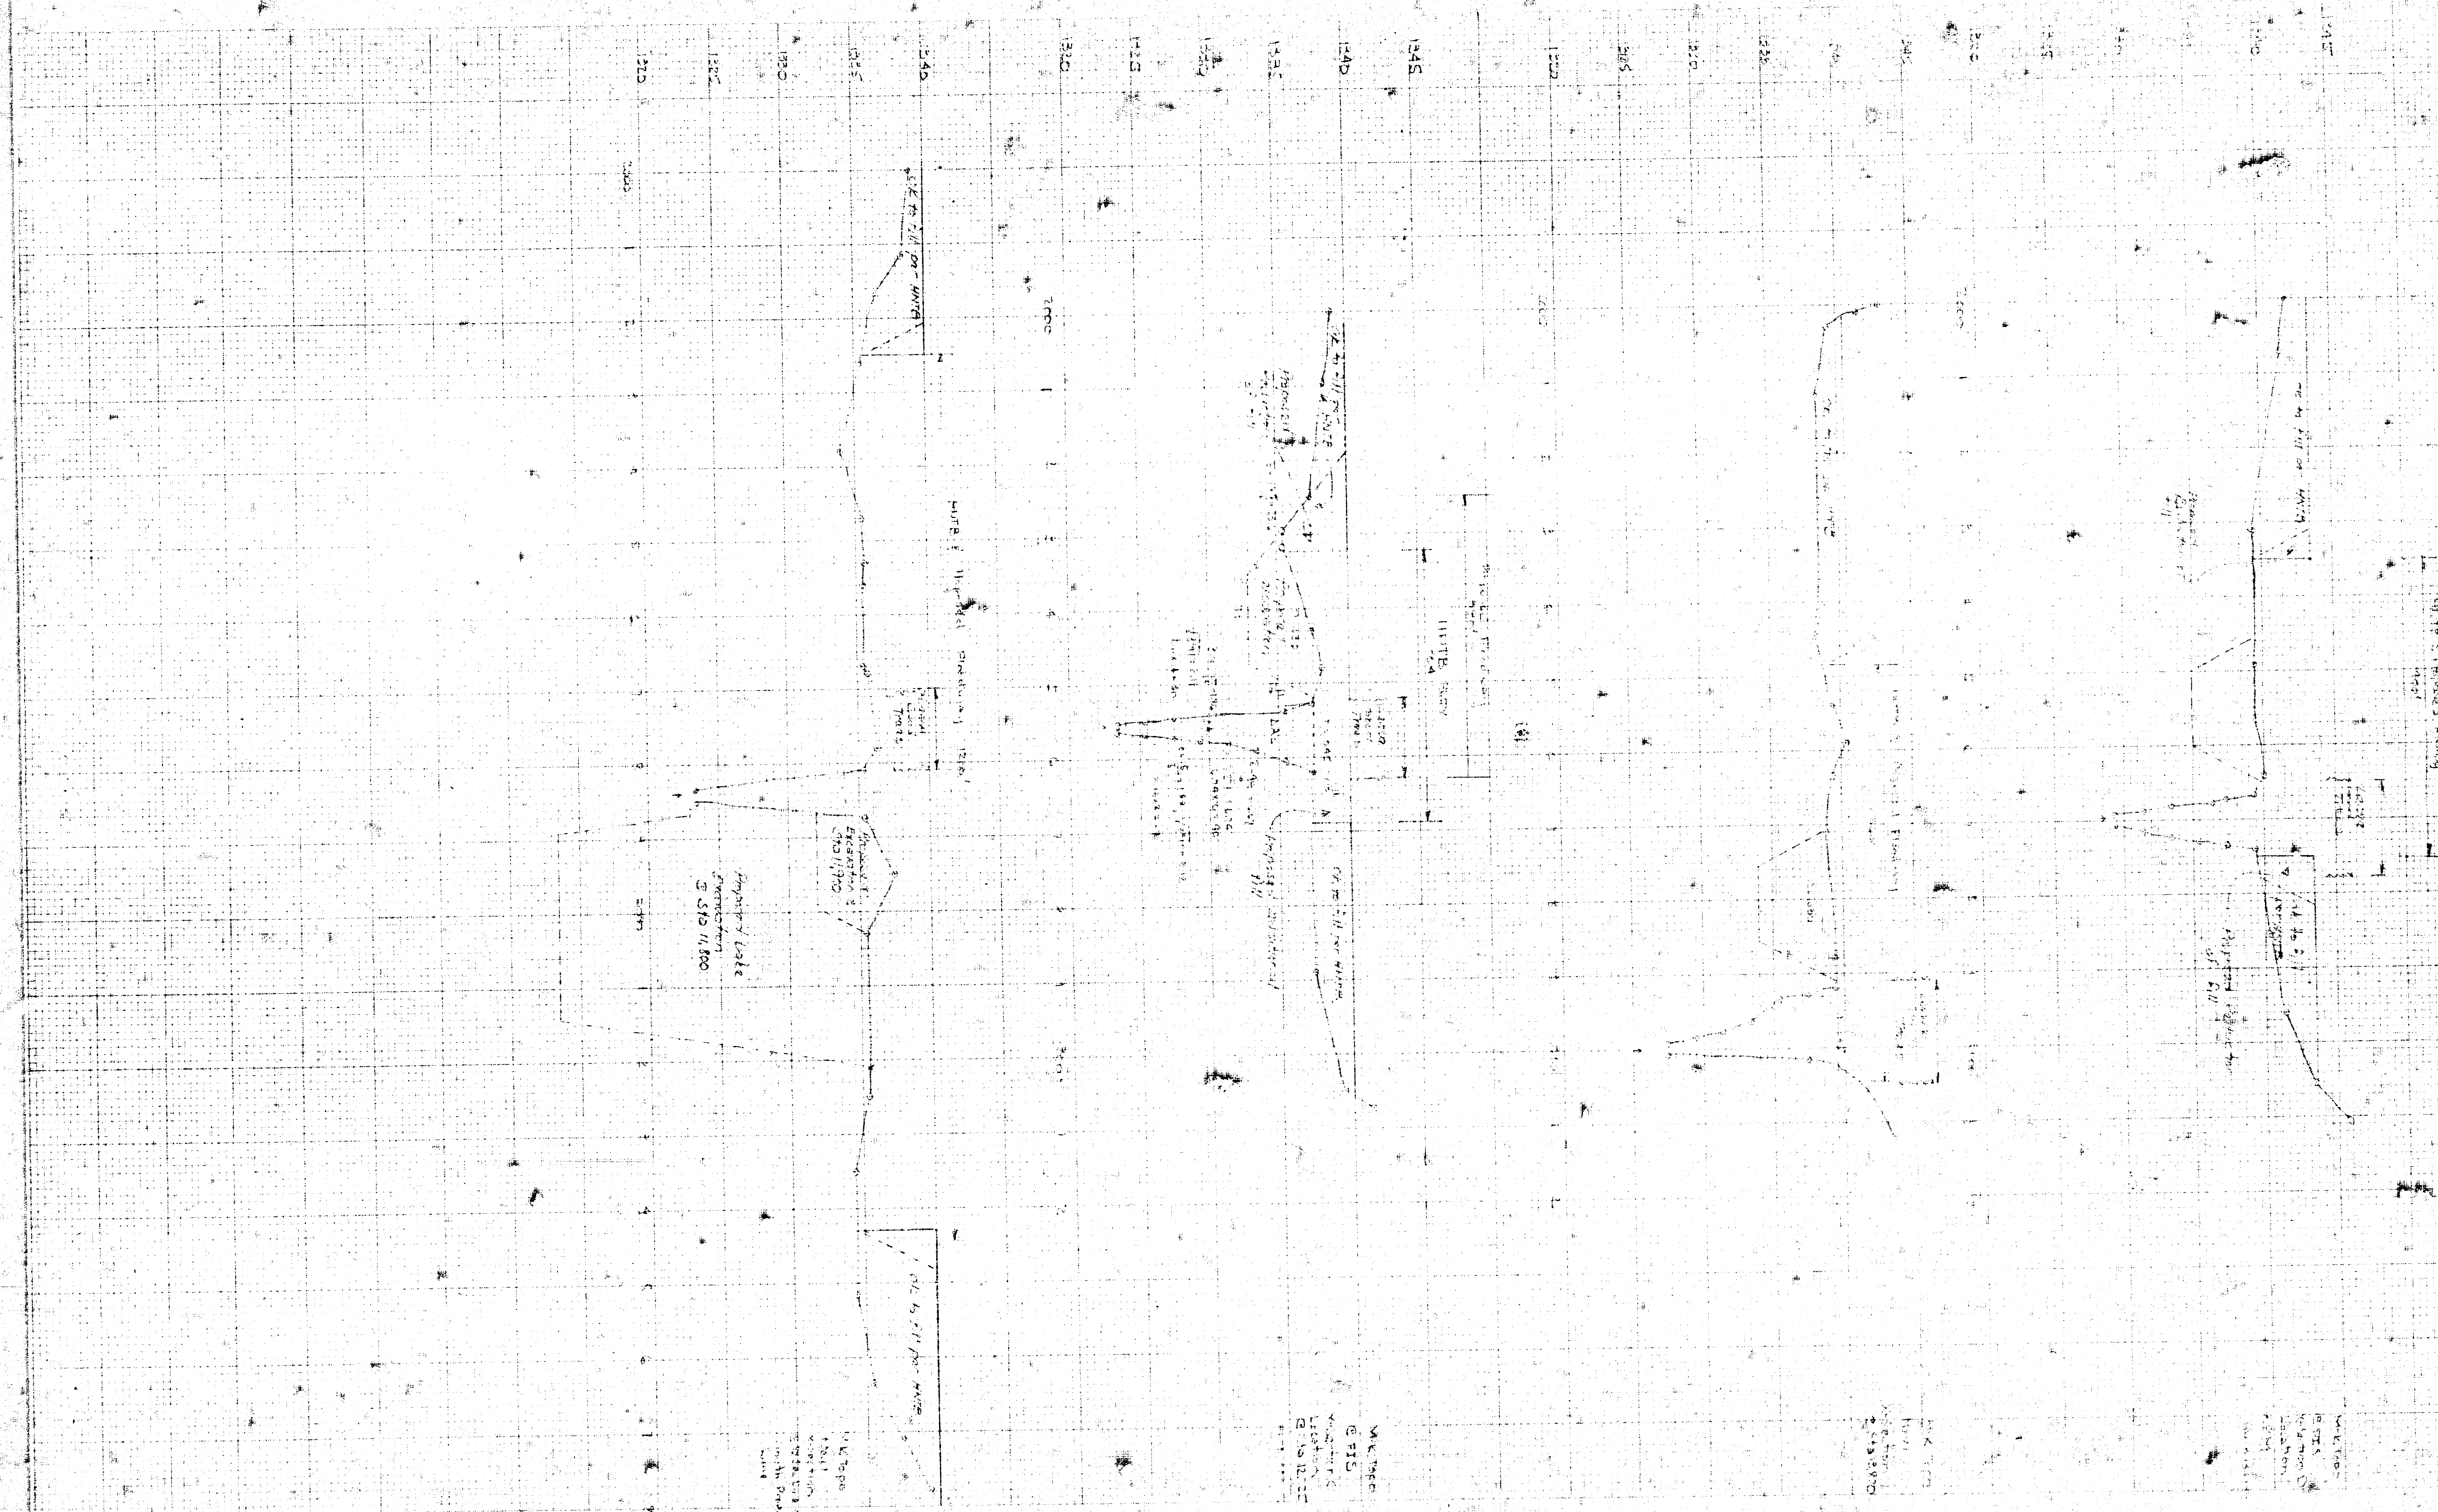

FILMED FROM THE BEST
AVAILABLE COPY

CHISHOLM CREEK COMMERCE CENTER
(DRAINAGE)

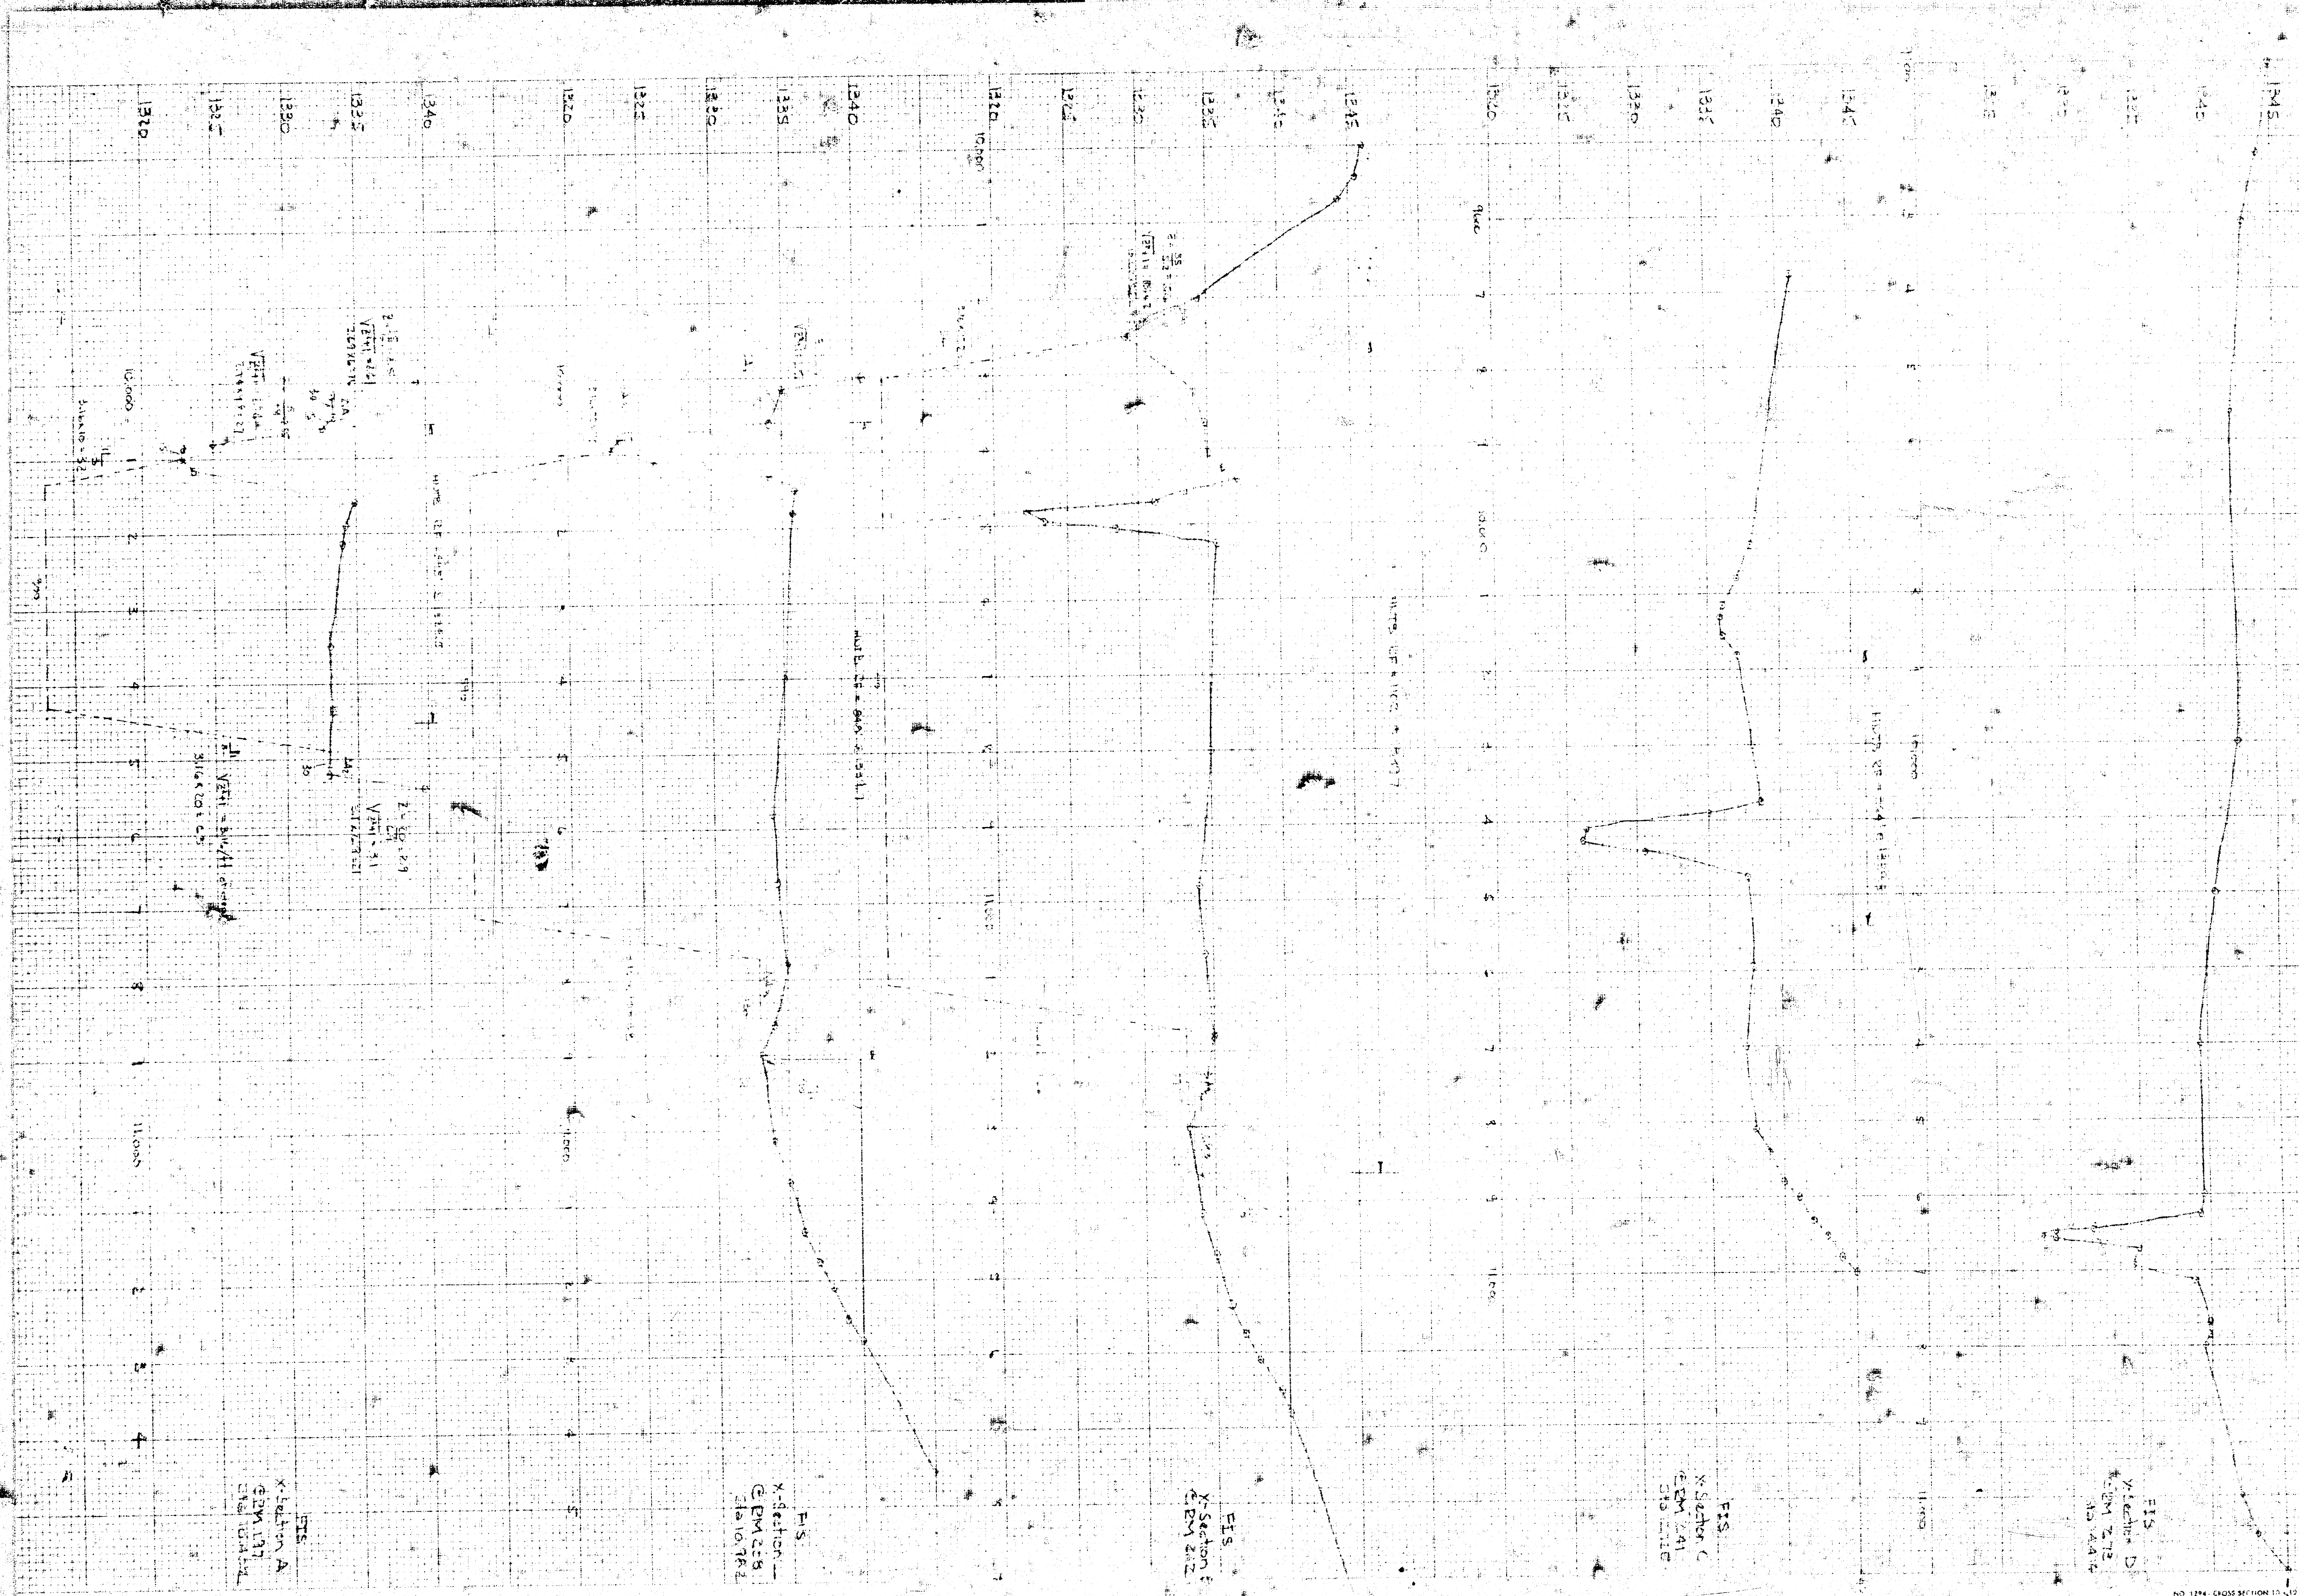

**FILMED FROM THE BEST
AVAILABLE COPY.....**