


COMOTARA VILLAGES 2ND ADDITION
(Drainage)

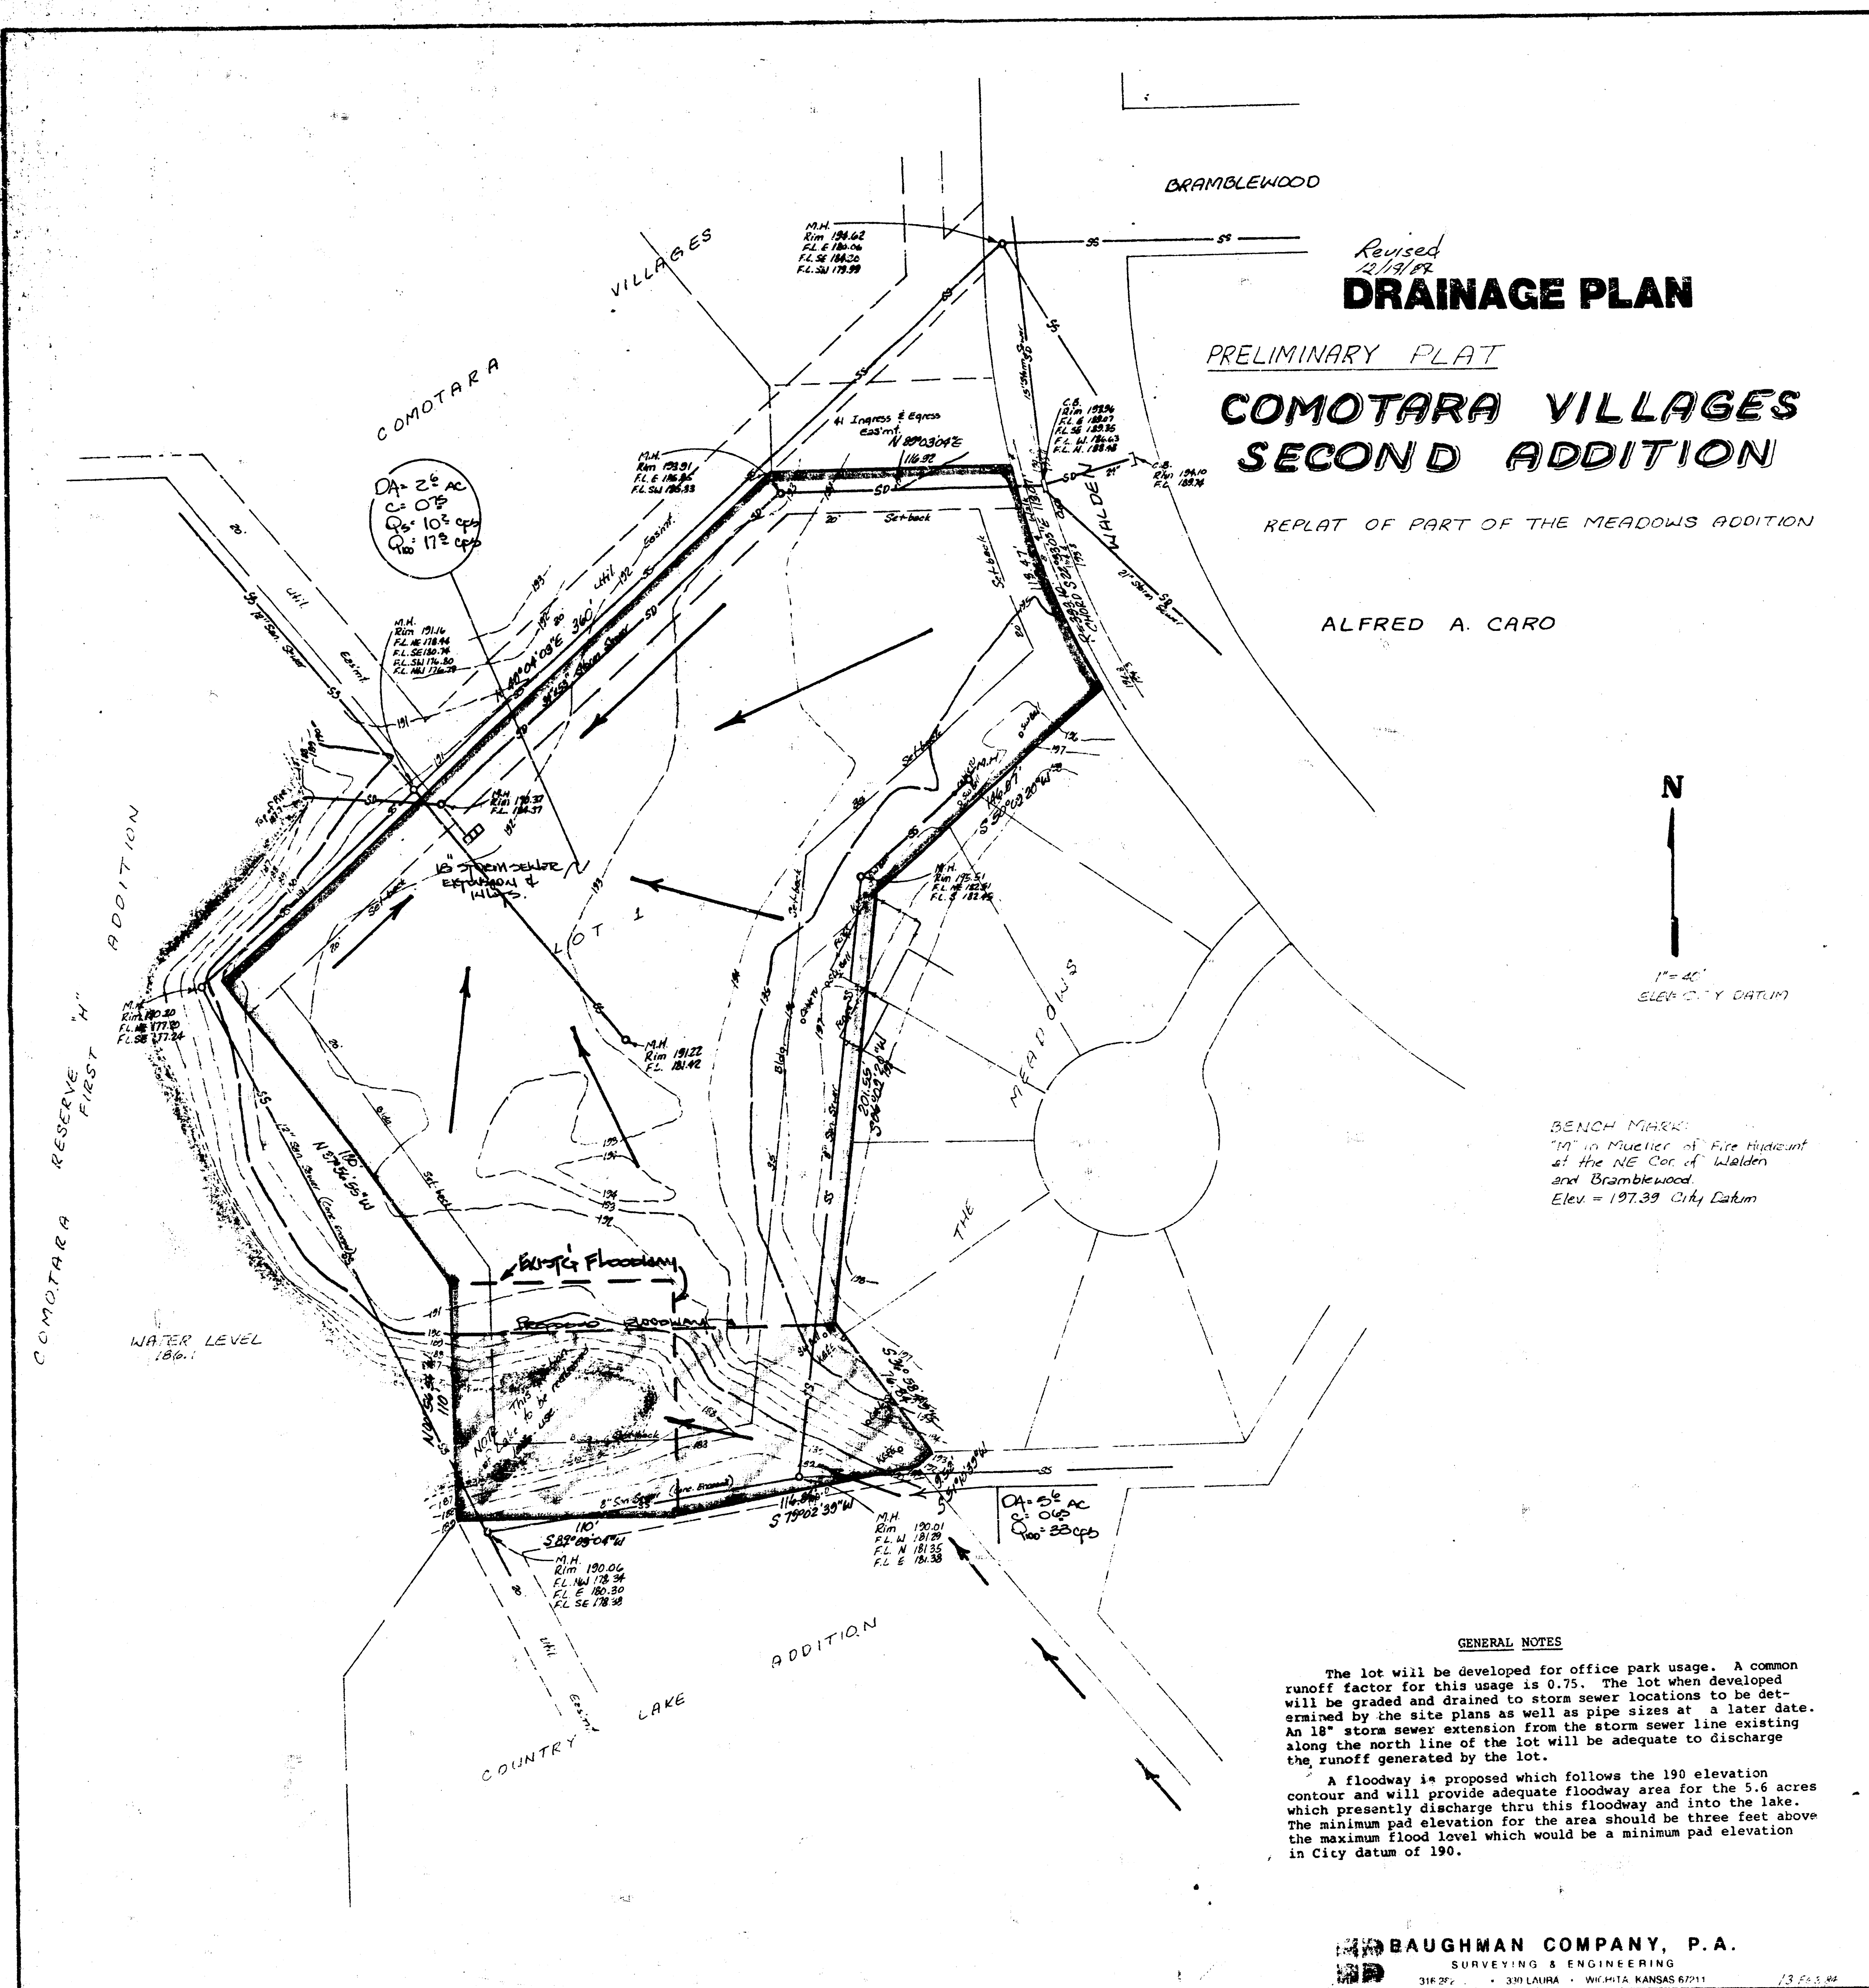

FILMED FROM THE BEST
AVAILABLE COPY