


CORRIGAN ADDITION
(DRAINAGE)

[illegible]

KNIFE:
BRIAN E & MARY ANN CORRIGAN
6314 LEGION
WICHITA, KS. 67204

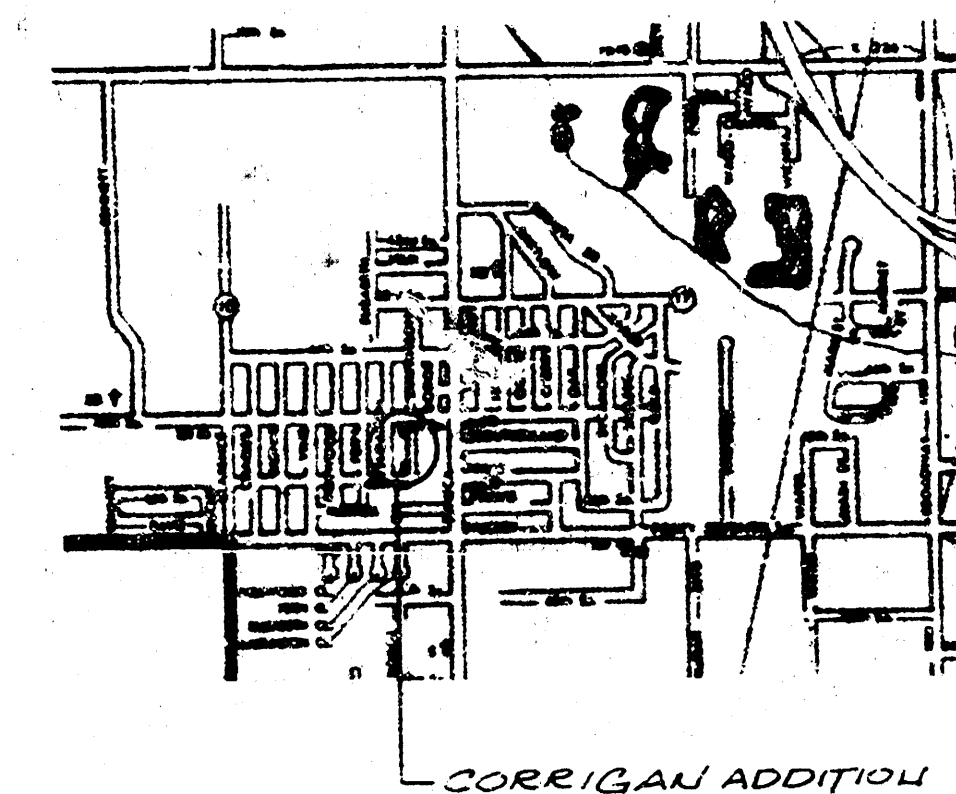

UTILITIES:
OVERHEAD ELECTRIC AND UNDERGROUND
TELEPHONE LOCATED IN IL UTILITY
FURNISHMENT BLOCK 21 PURCELL'S 11TH ADDITION

SAN SEWER
MANHOLE #1 - RING 8725

OUT - EAST	73.73
IN - WEST	73.77
IN - NORTH	75.27
IN - SOUTH	75.36

WALSHOLE #3 RING 86.57
NACHOLE UNDER FENCE UNABLE TO
OPEN

WALSHOLE #3 RING 84.66
NOT SHOWN OUT-LOOK 82.18
63 E SOUTH IN - EAST 82.37
WALSHOLE #3

TOPOGRAPHIC SURVEY - 5/27/83
BENCH MARK - CITY DISC. 47TH ST 30 E SENECA
ELEV = 87.34'

PREPARED BY:
AIR CAPITOL LAND SURVEYORS
210 W. 21st St
Wichita, KS 67203

FILMED FROM THE BEST
AVAILABLE COPY