
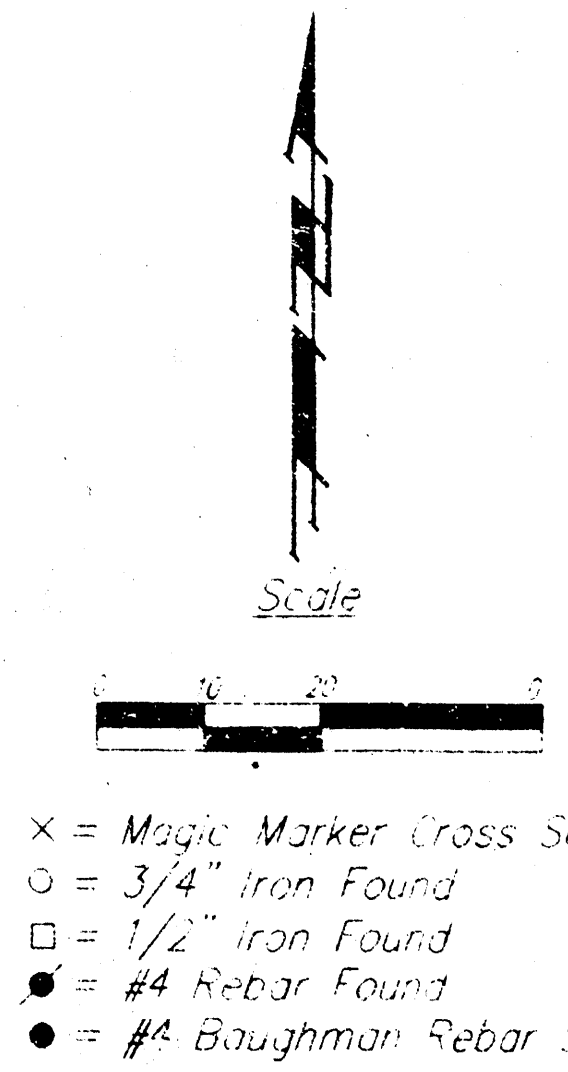


DRAINAGE PLAN

DANVILLE ADDITION

WICHITA, SEDGWICK COUNTY, KANSAS

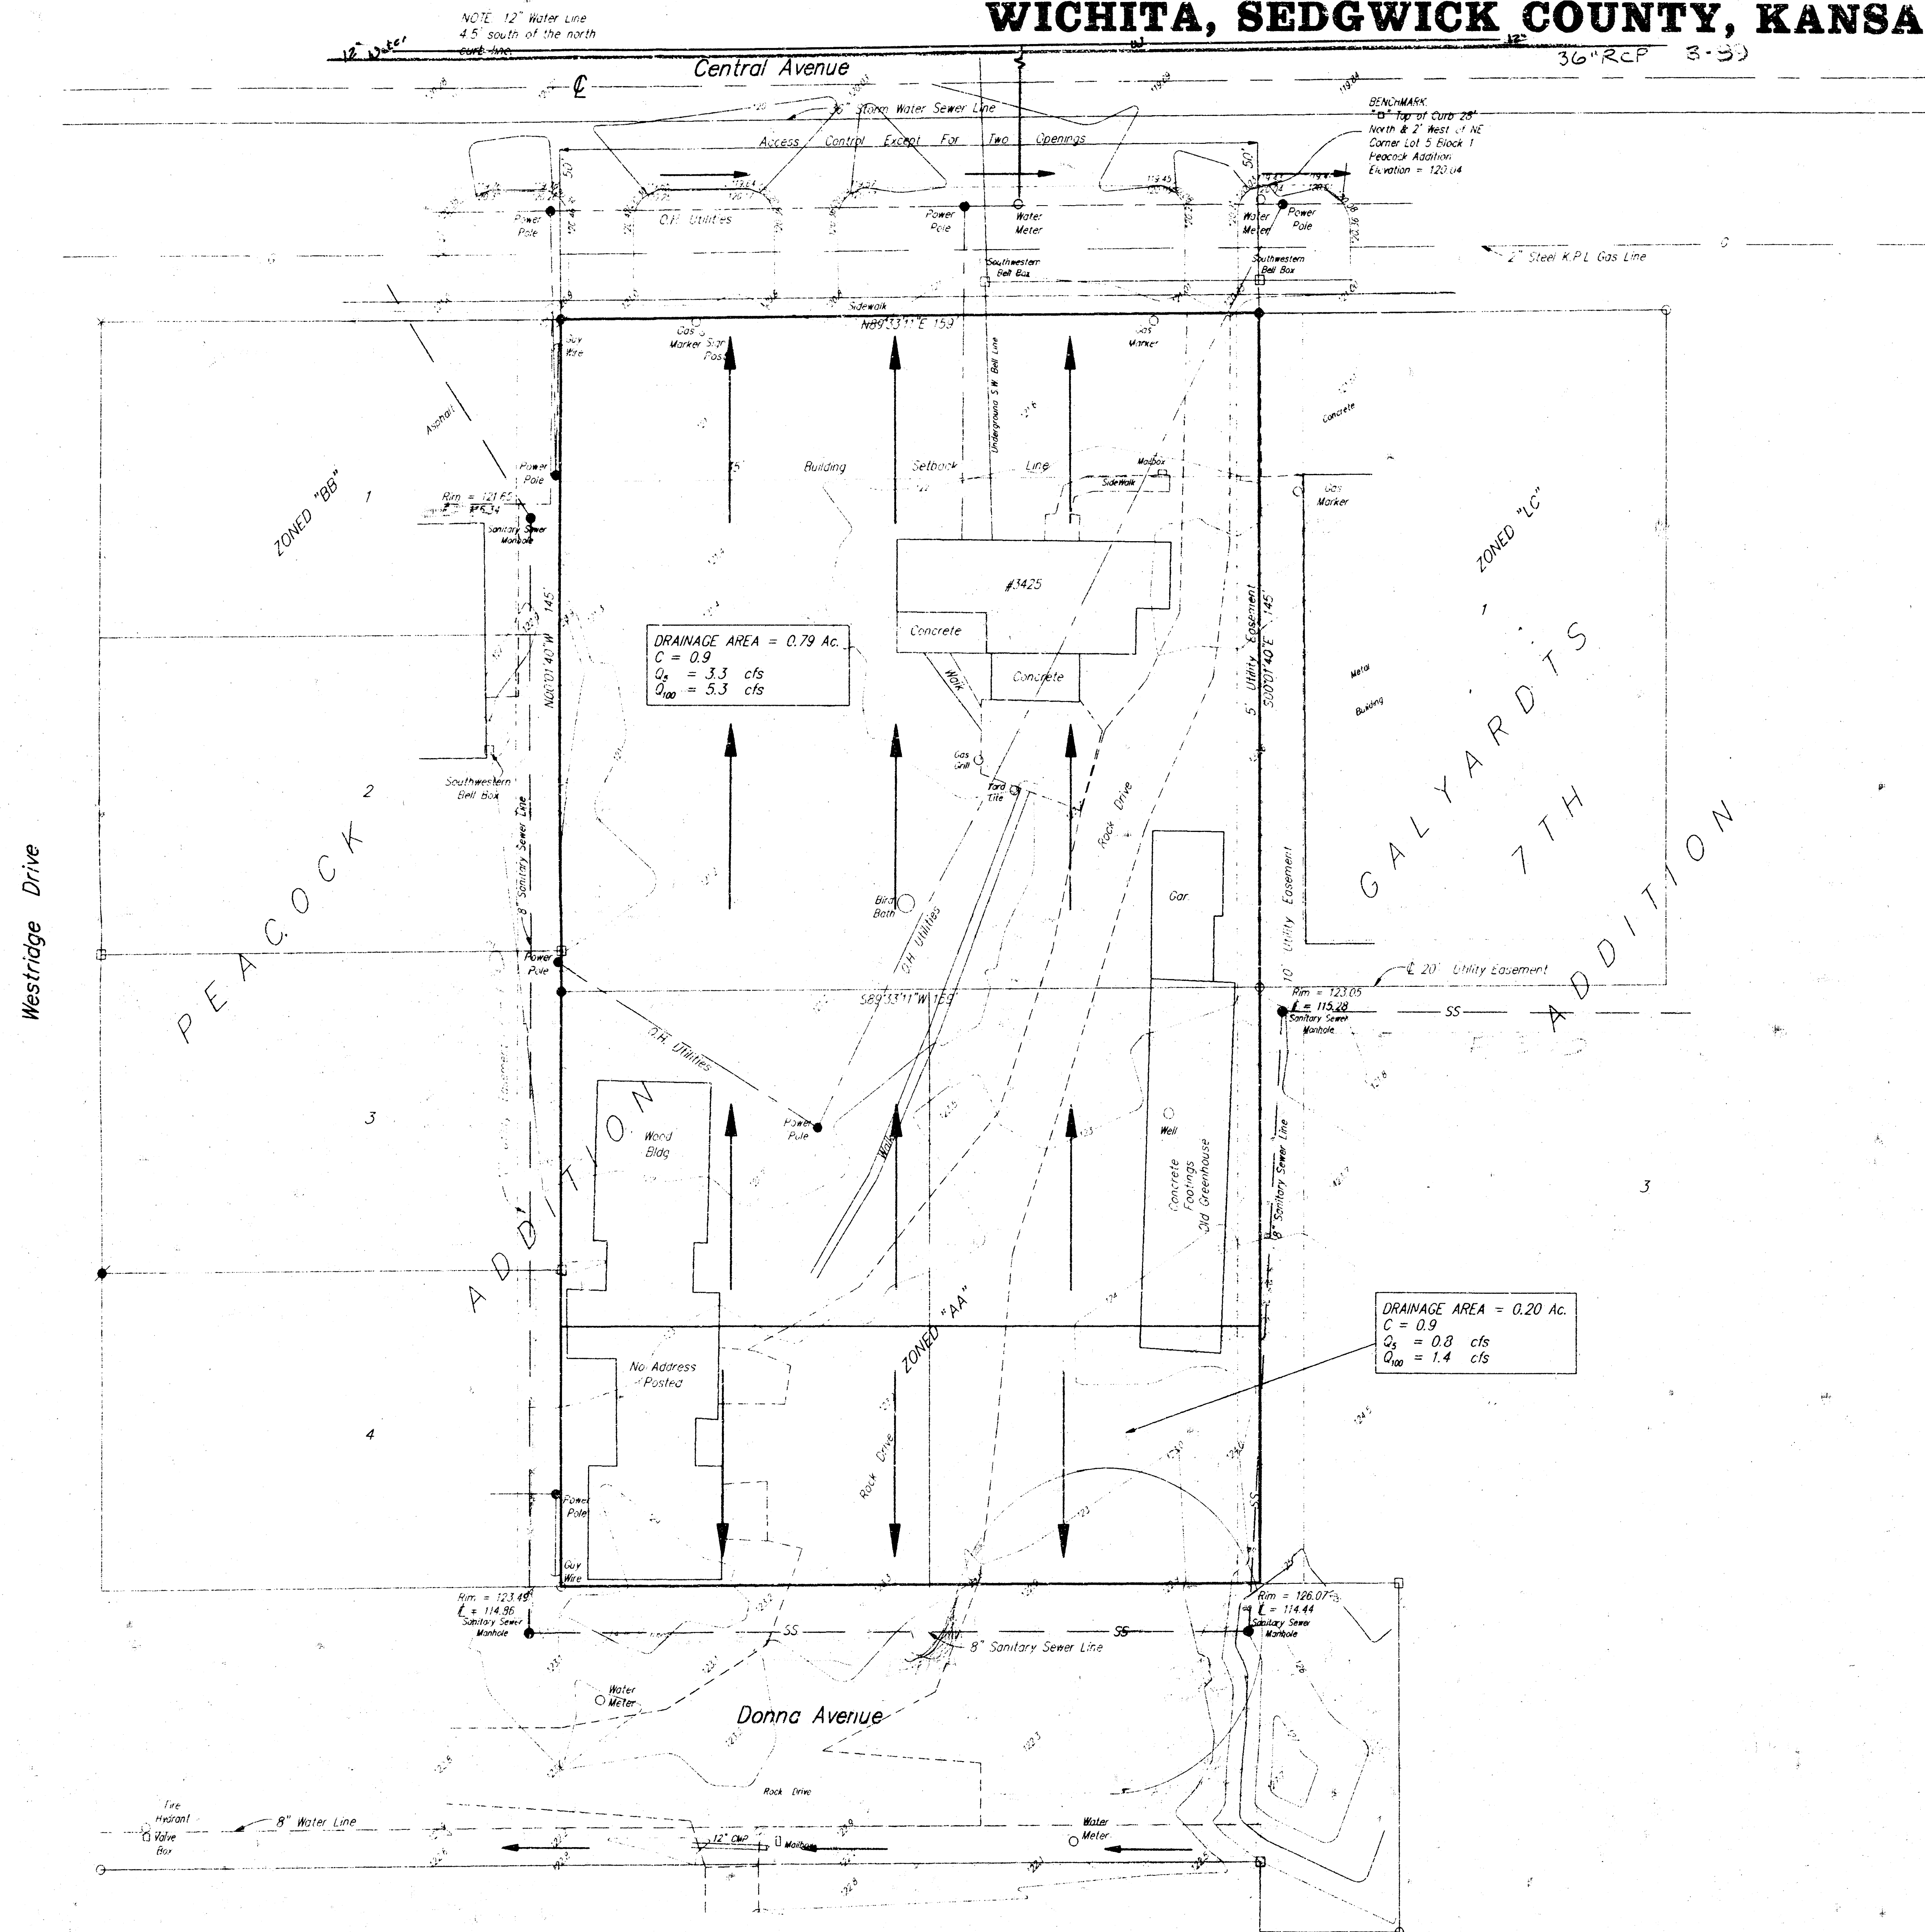

Legal

A Replot of the North 145 feet of Lot 5, Block 1, Peacock Addition to Wichita, Kansas.

Benchmark

City of Wichita Bench Mark 30' south and 42' east of center line of both, Peacock Addition to Wichita, Kansas. Elevation = 121.66 (City Datum)

Owner

Danville Investments, Inc.
Box 965, Wichita, Kansas, 67201
(316)262-2605

