


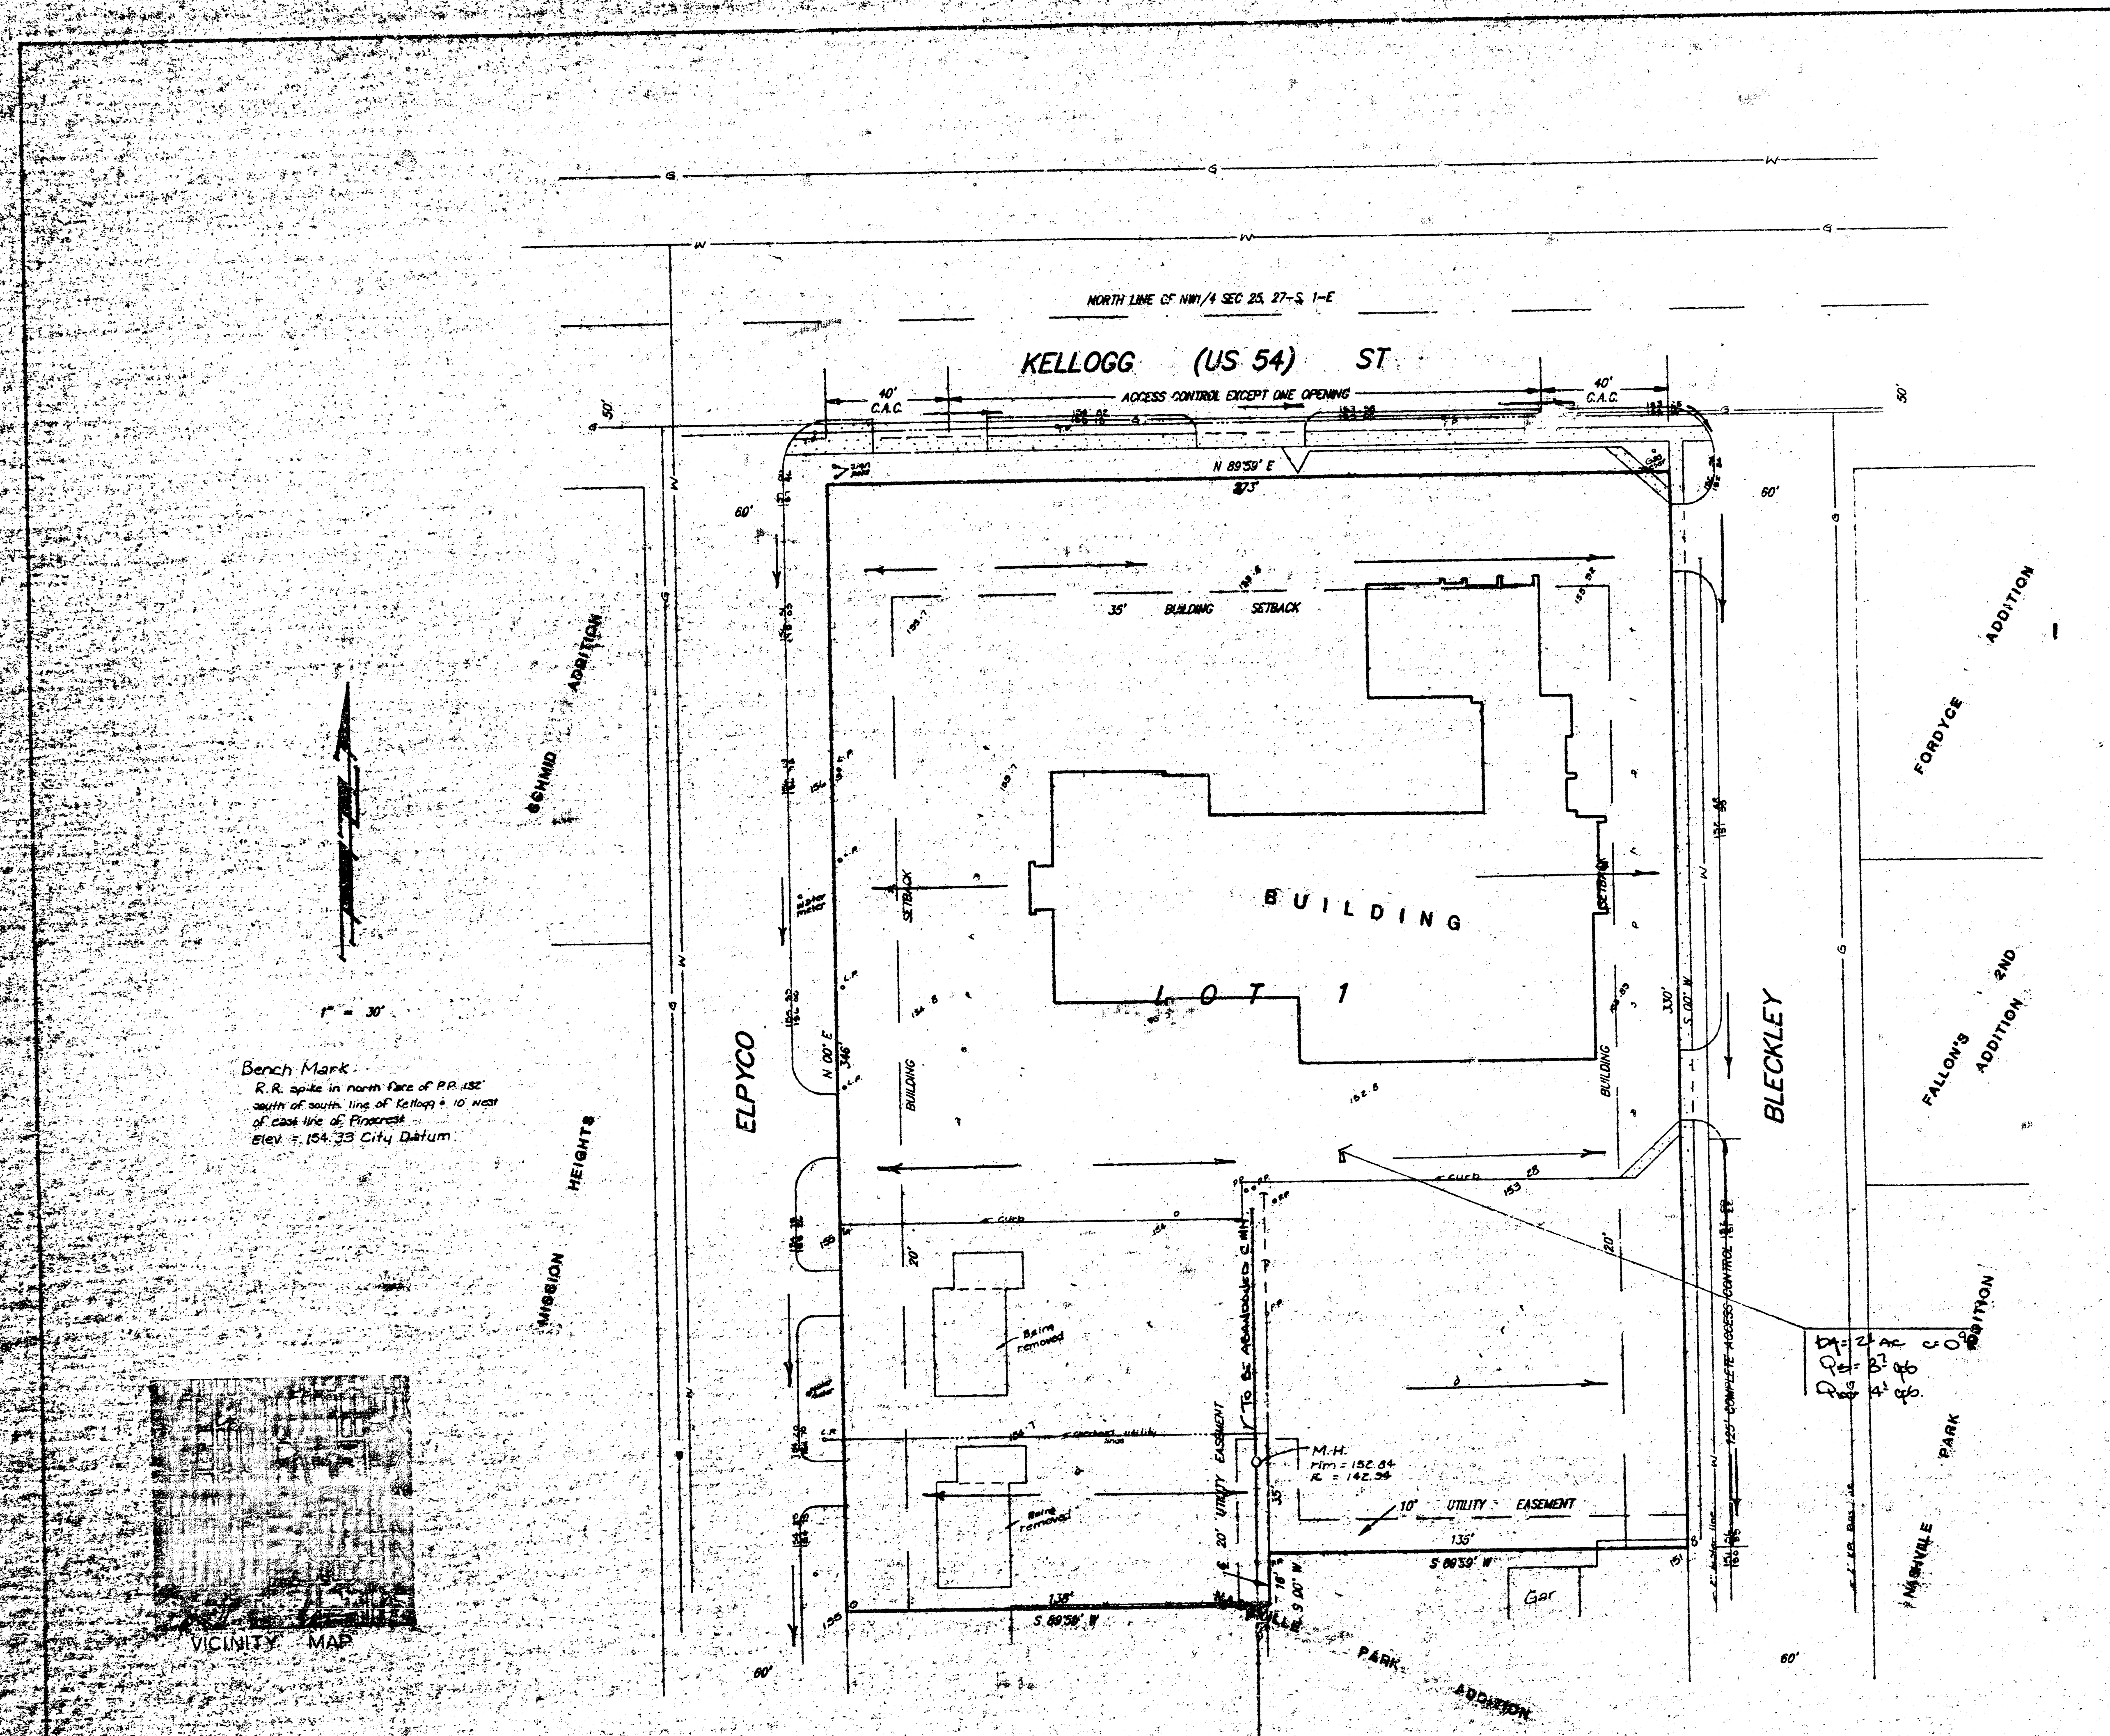

SKETCH PLAT DAVIS-MOORE 7TH ADDITION

WICHITA, SEDGWICK COUNTY, KANSAS.

Lot 1, Davis-Moore 6th Addition, Wichita, Sedgwick County, Kansas
and Lots 10 and 11, Block B, Nashville Park Addition to Wichita,
Kansas.

T. G. DAVIS, JR.

APPROVED
DRAINAGE PLAN

DRAINAGE PLAN

BAUGHMAN COMPANY P. A.
SURVEYING & ENGINEERING
318/262-7271 • 315 ELLIS • WICHITA, KANSAS 67211

21 JAN 91