
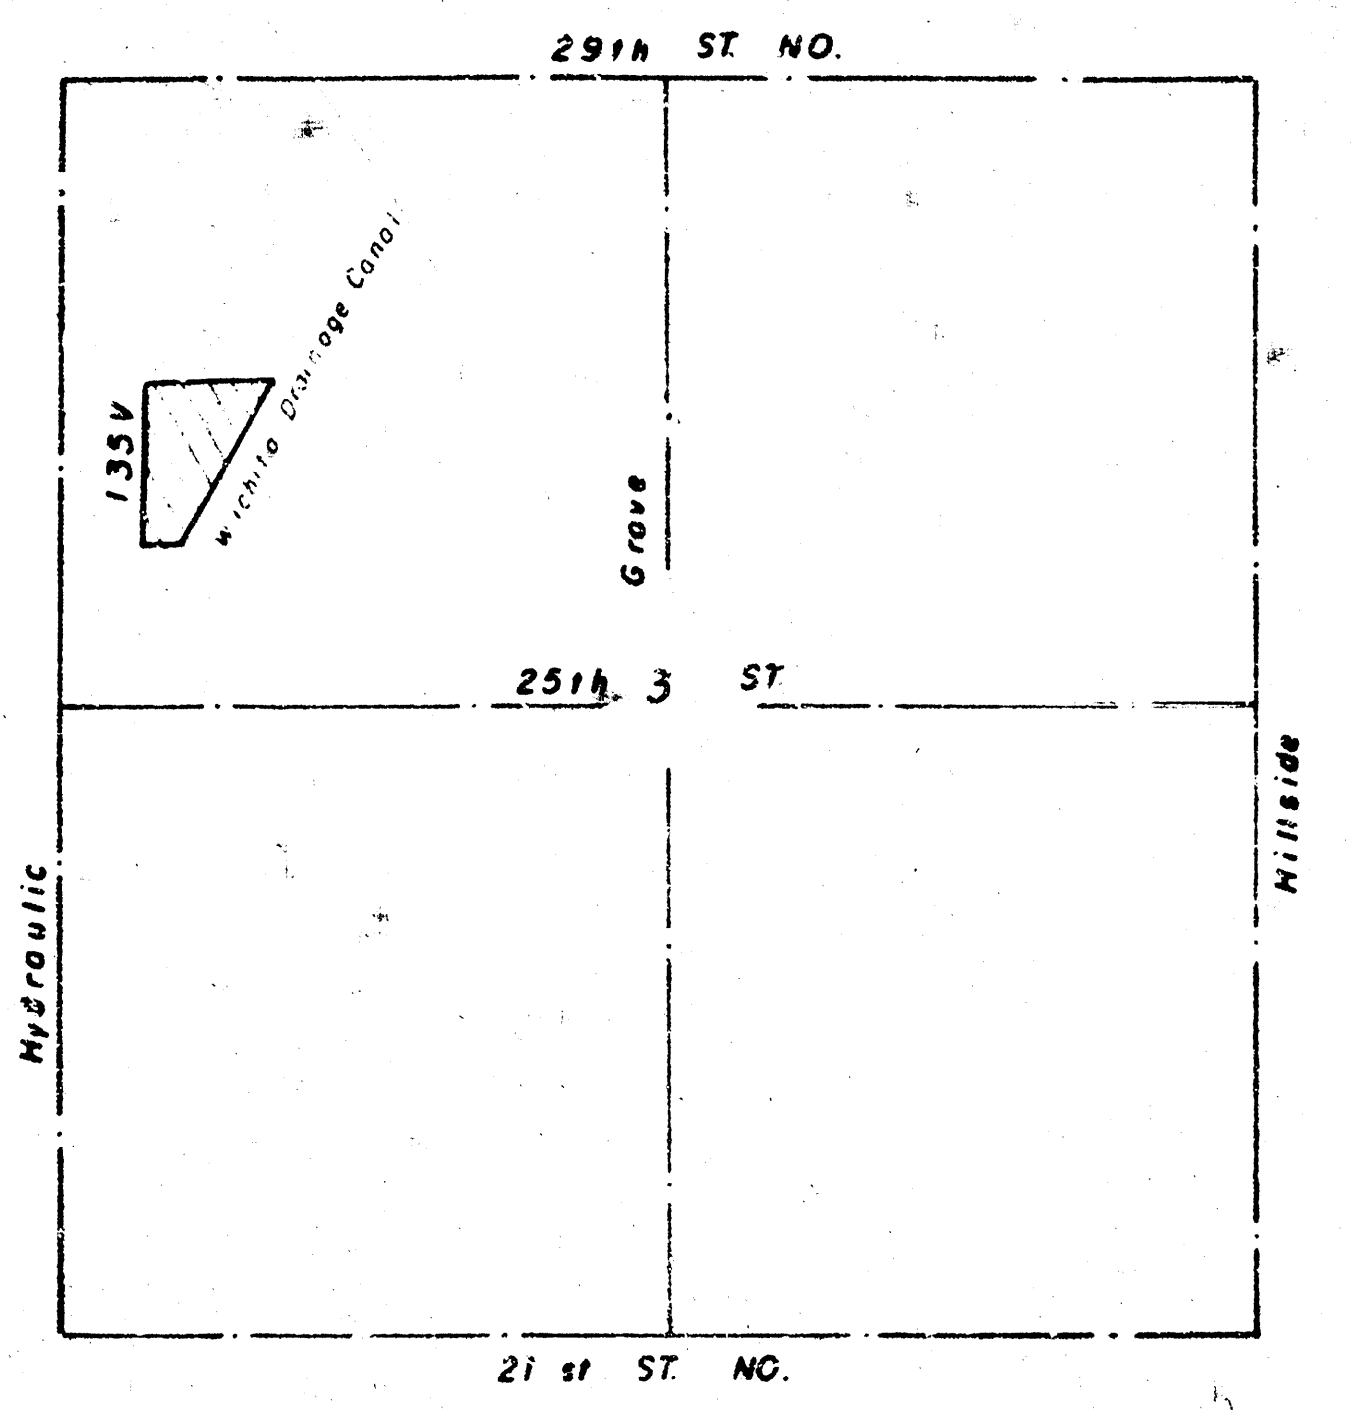


SKETCH PLAT

DEPARTMENT OF TRANSPORTATION 2ND ADDITION

LOT GRADING PLAN

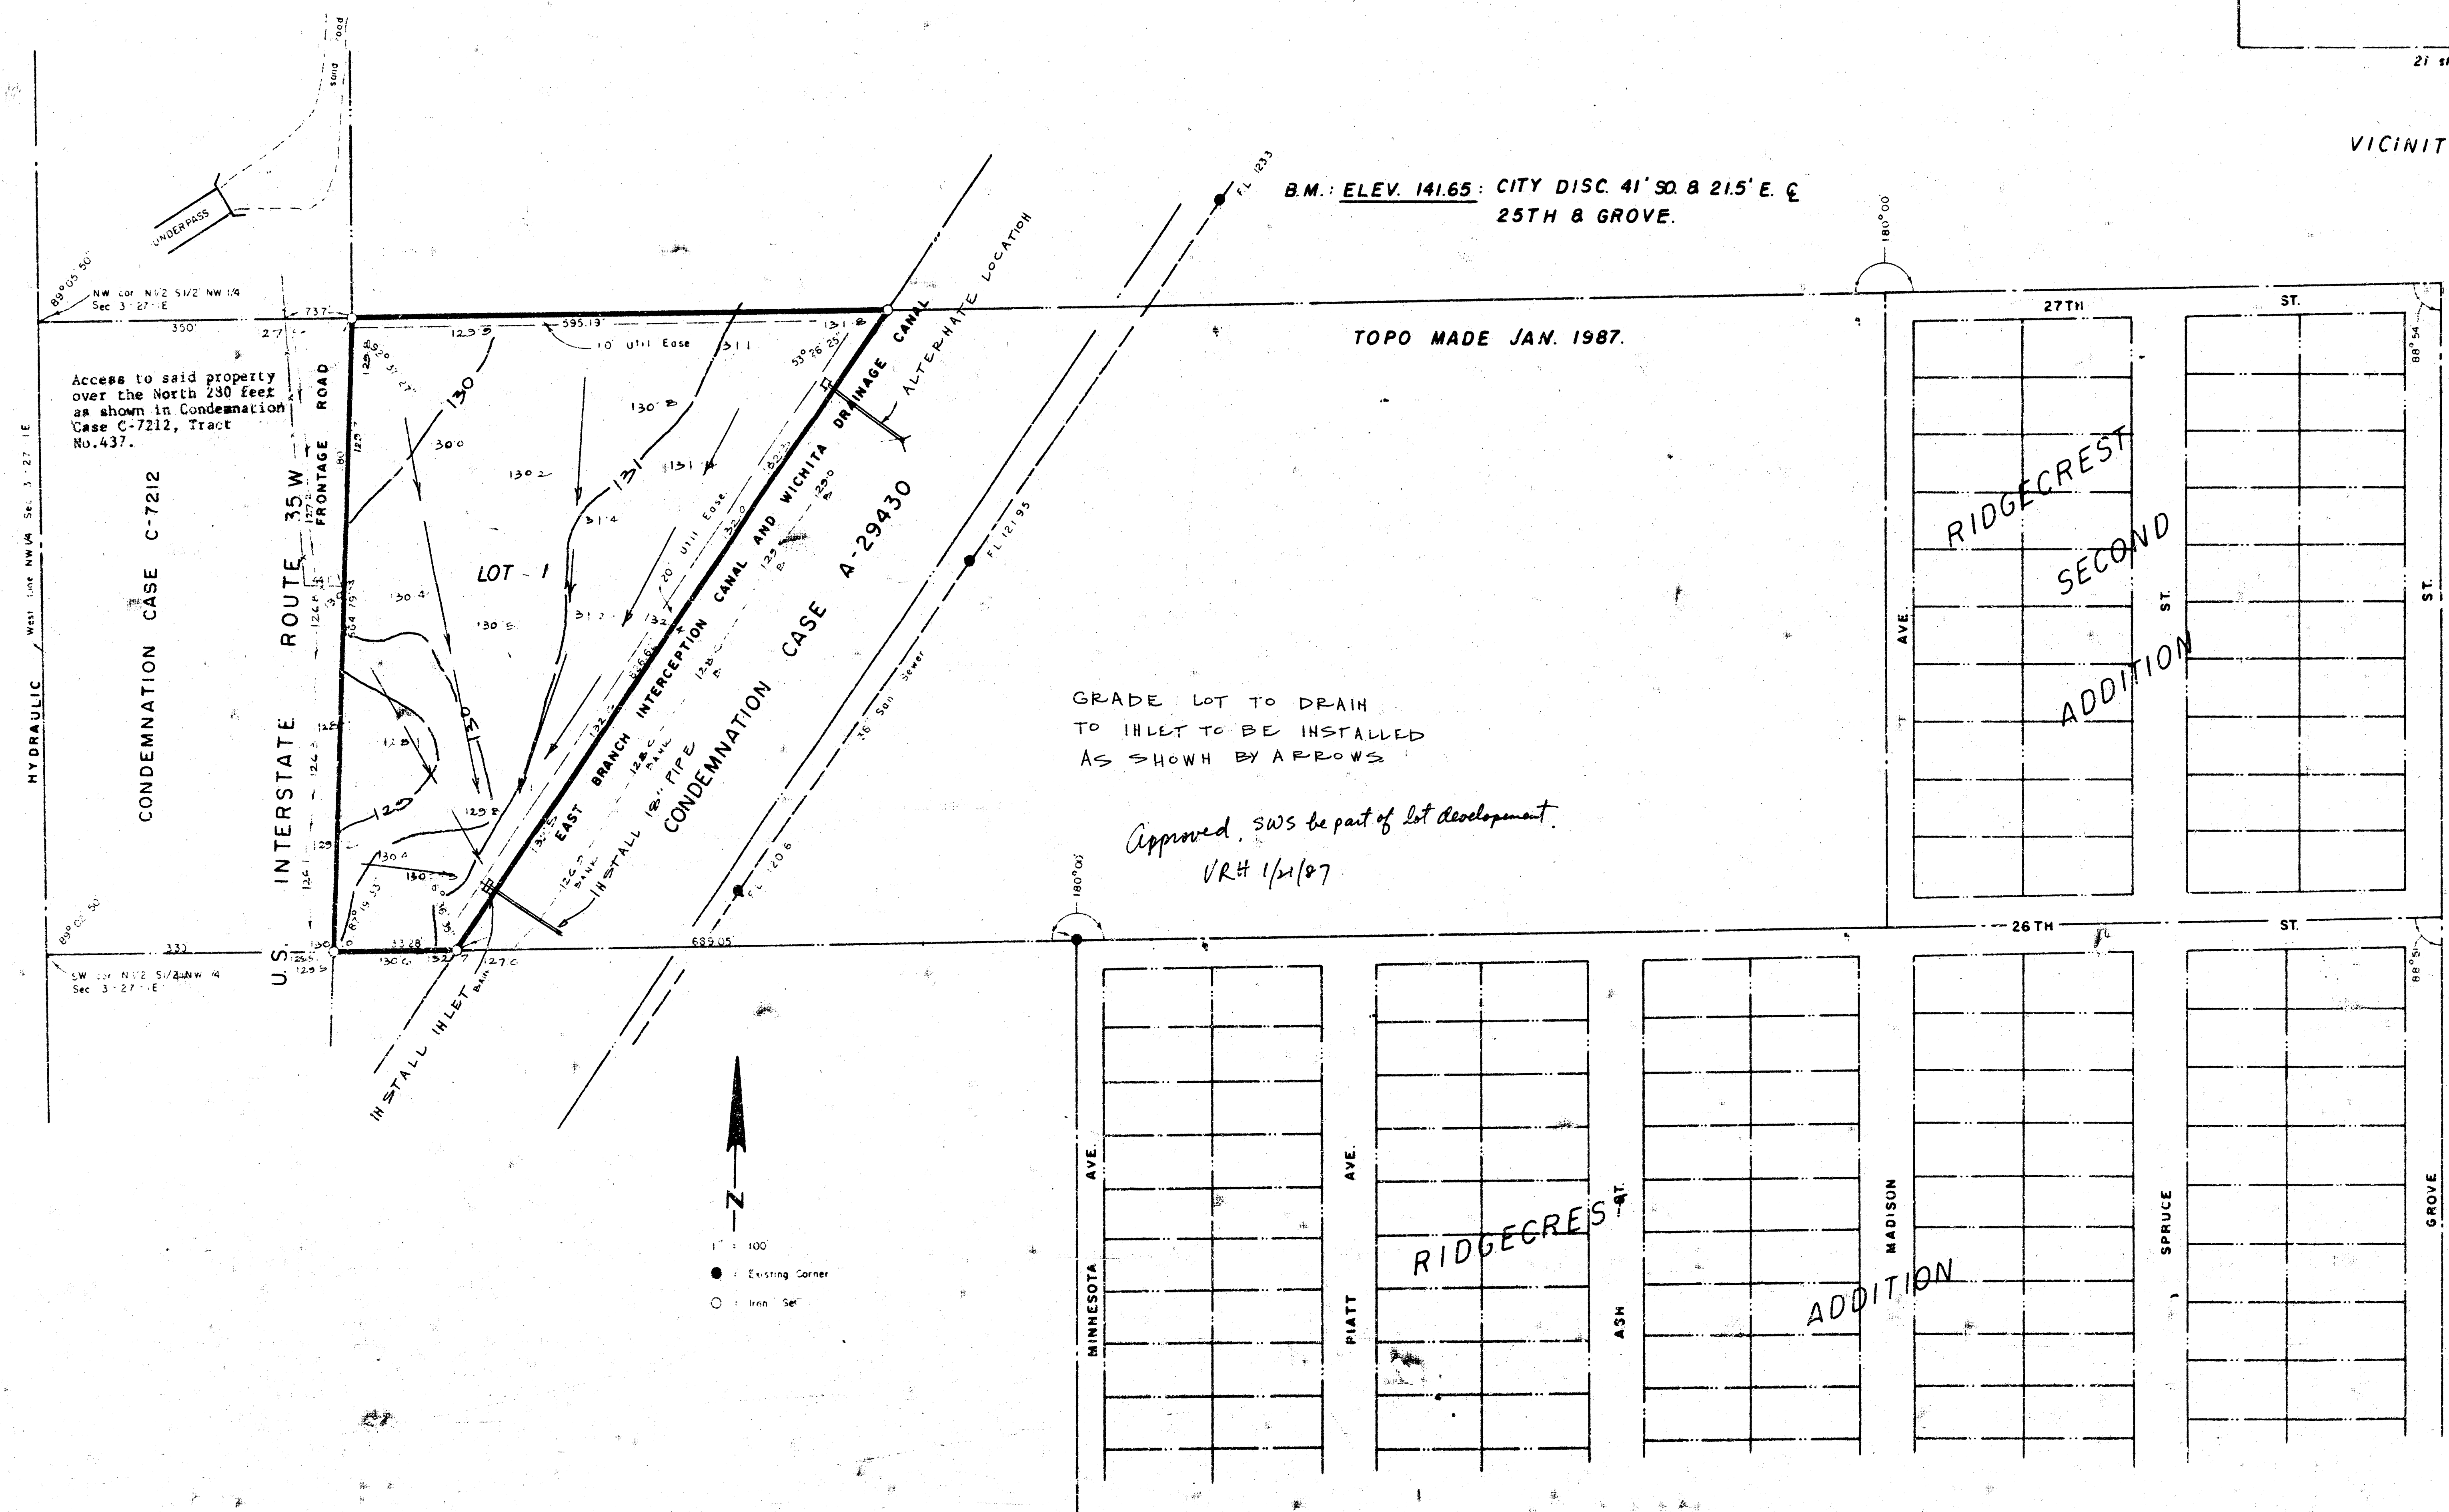

VICINITY MAP

LOWELL D. HIGH
JAN. 16, 1987

FOR
CITY OF WICHITA