


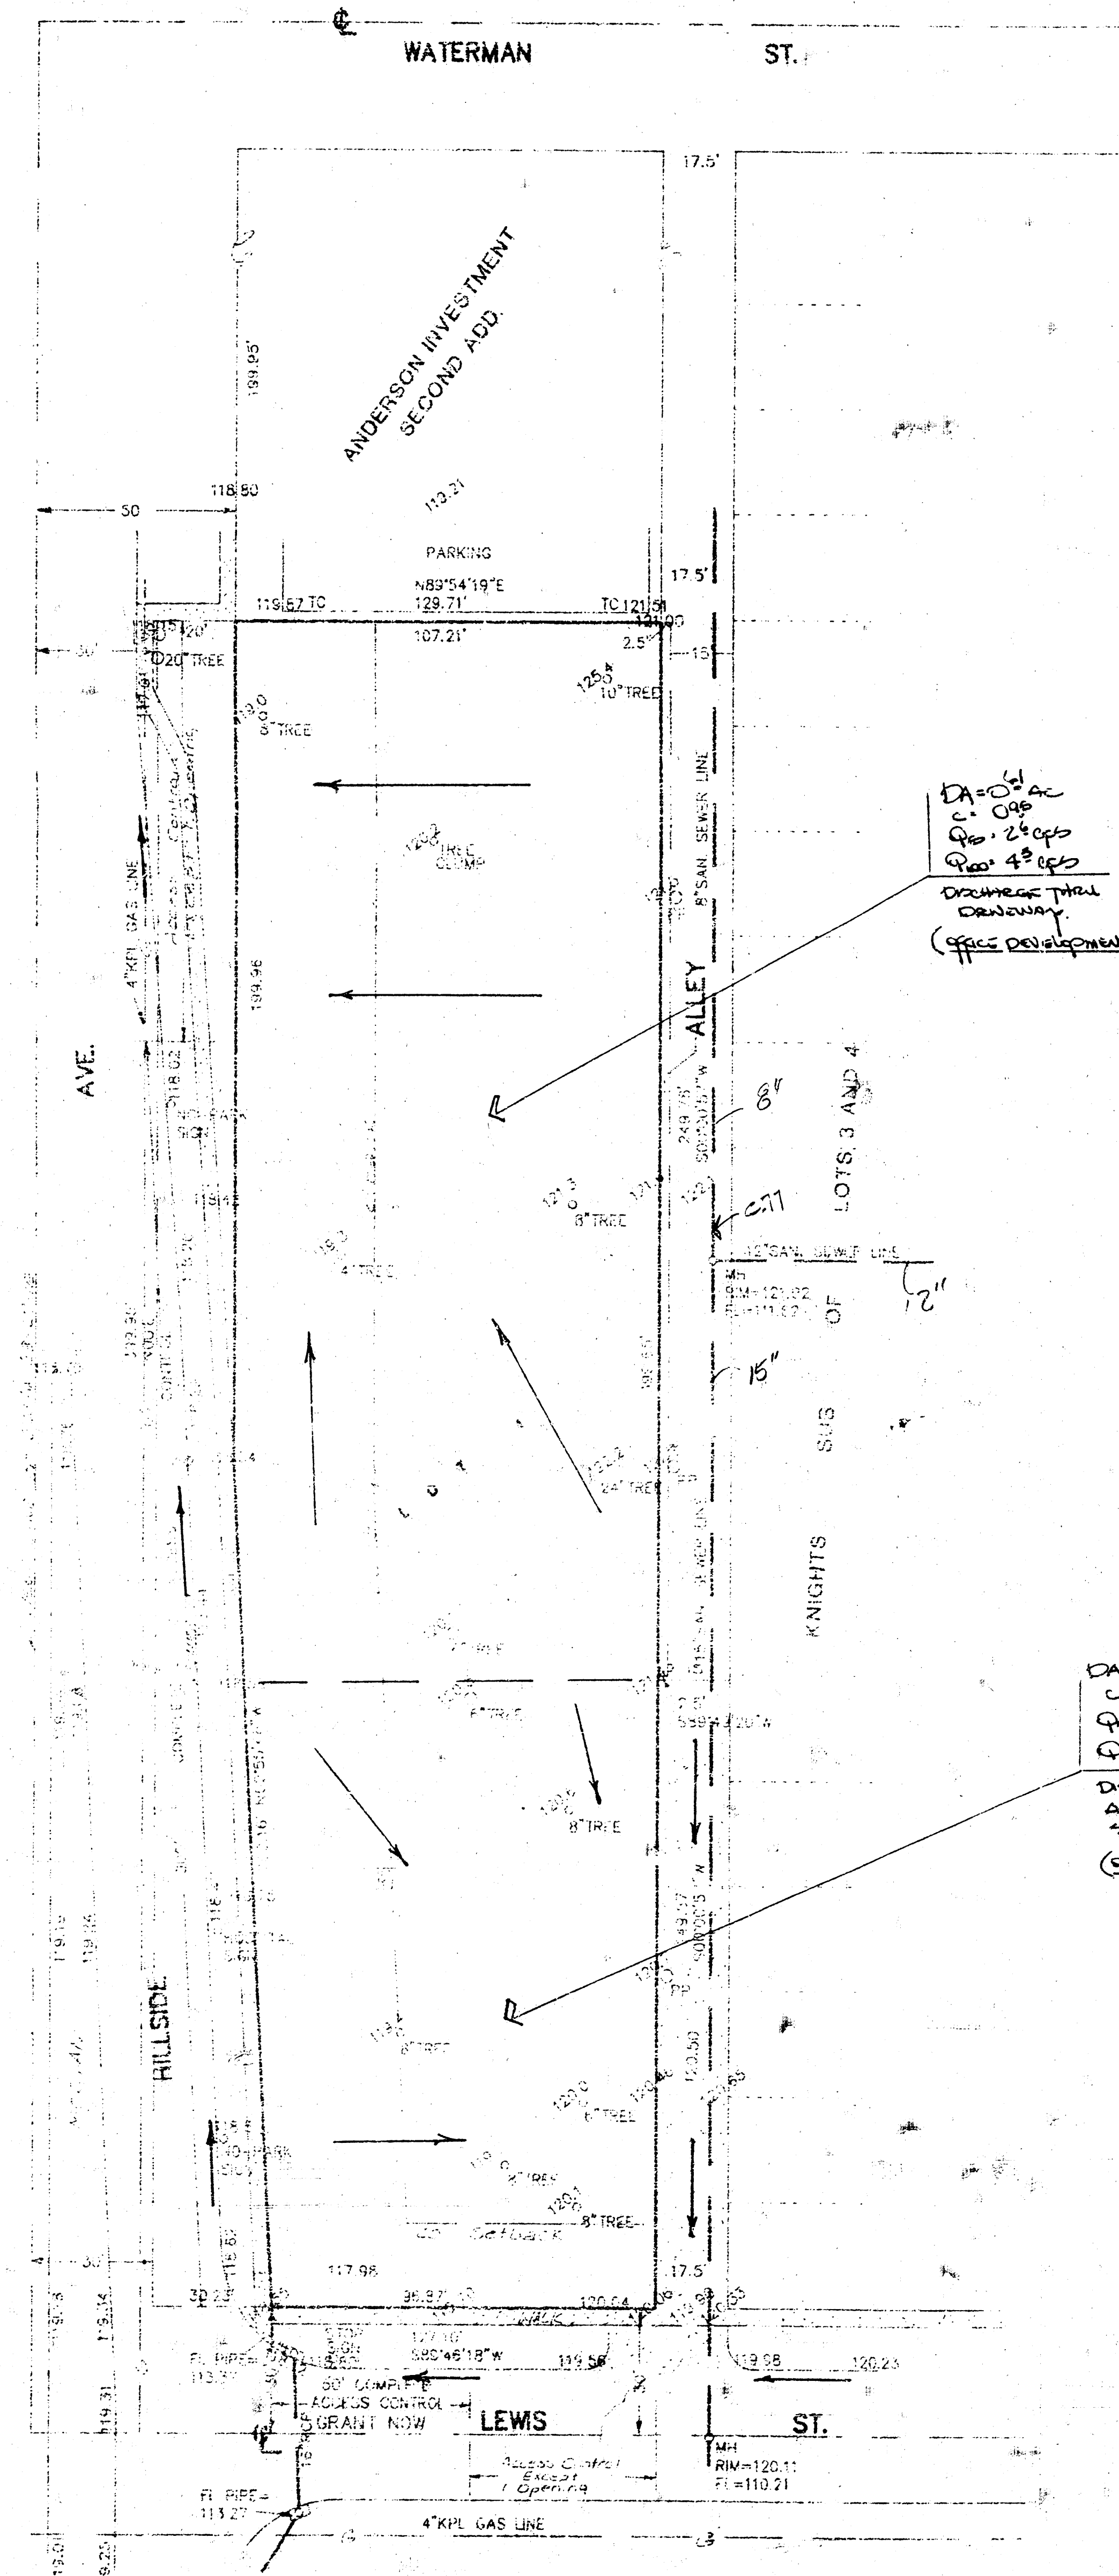

SKETCH PLAT DEPARTMENT OF TRANSPORTATION 3RD ADDITION

REPLAT OF LOTS 17, 19, 21, AND 23, KNIGHTS SUB-DIVISION, OF LOTS 3 AND 4, IN BLOCK 1, GRAND VIEW ADDITION TO WICHITA, KANSAS, TOGETHER WITH LOTS 1, 3, 5, 7, 9, AND 11, RAWLINS AND BROWN'S SUB-DIVISION OF LOTS 5 AND 8, IN BLOCK 1, GRAND VIEW ADDITION TO WICHITA, KANSAS, TOGETHER WITH LOT 1, HERMAN ADDITION, WICHITA, KANSAS.

DEPARTMENT OF TRANSPORTATION
AND CITY OF WICHITA

(OFFICE DEVELOPMENT)

Prove existing storm
sewer can take
all this water & tell
what existing runoff
to to SS is.
And prove won't flood
street
Paved Alley? Brent