

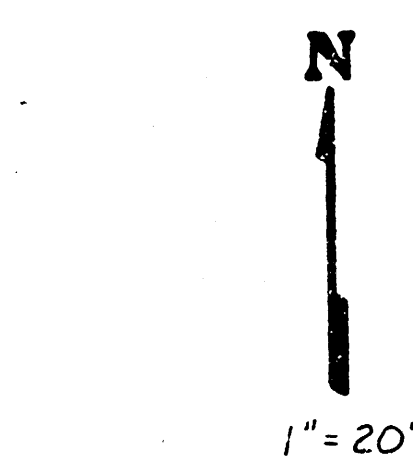


ELIZABETH,S ADDITION

**OWNERS: JULIUS SMITH
LEE LUINSTR**

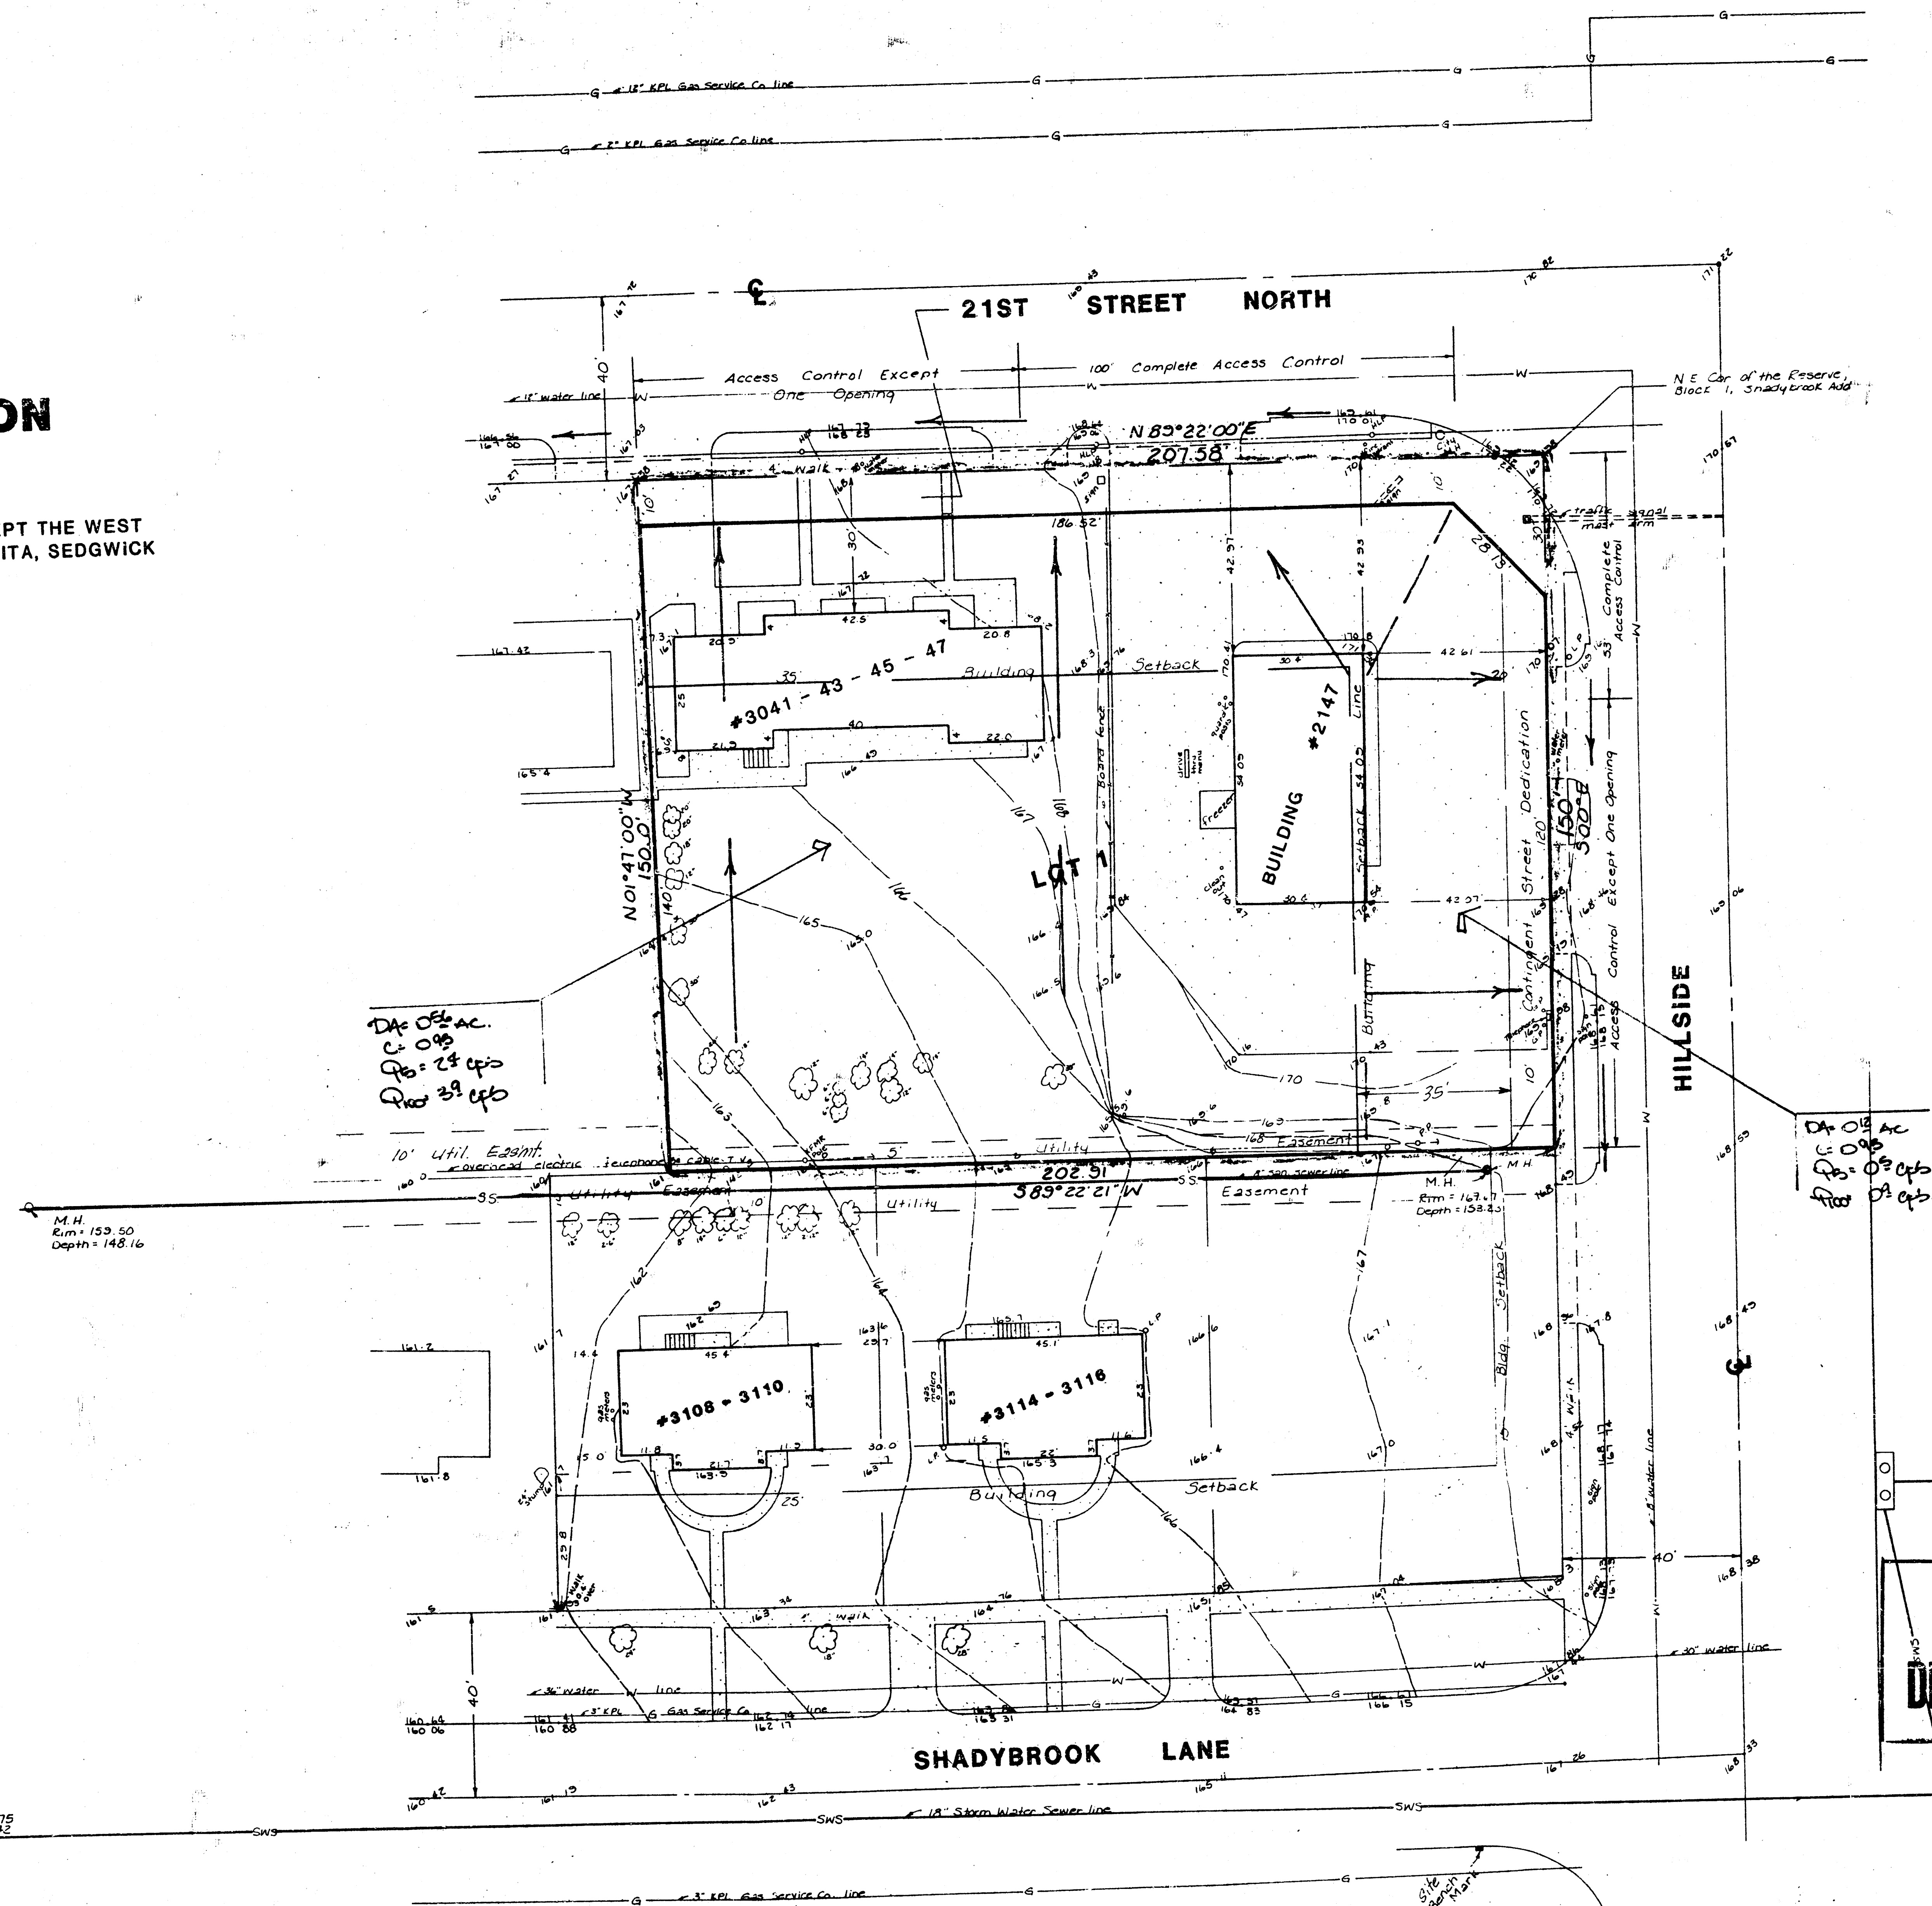

Bench Mark:
 □ cut on top of curb South
 side of Shadybrook & Hillside,
 at end of return.
 Elev. = 167.23 City Datum

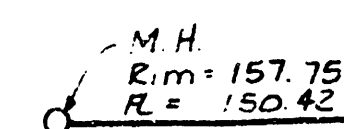

**APPROVED
DRAINAGE PLAN**

DRAINAGE PLAN

Revised MAR 5, 91

ED BAUGHMAN COMPANY, P.A.
SURVEYING & ENGINEERING,
316/262-7271 • 315 ELLIS • WICHITA, KANSAS 67211 12-28-90

FILMED FROM THE BEST AVAILABLE COPY....