


FOUR CORNER PLAN FOR
EVERGREEN 4TH
AN ADDITION TO WICHITA, SEDGWICK COUNTY, KANSAS

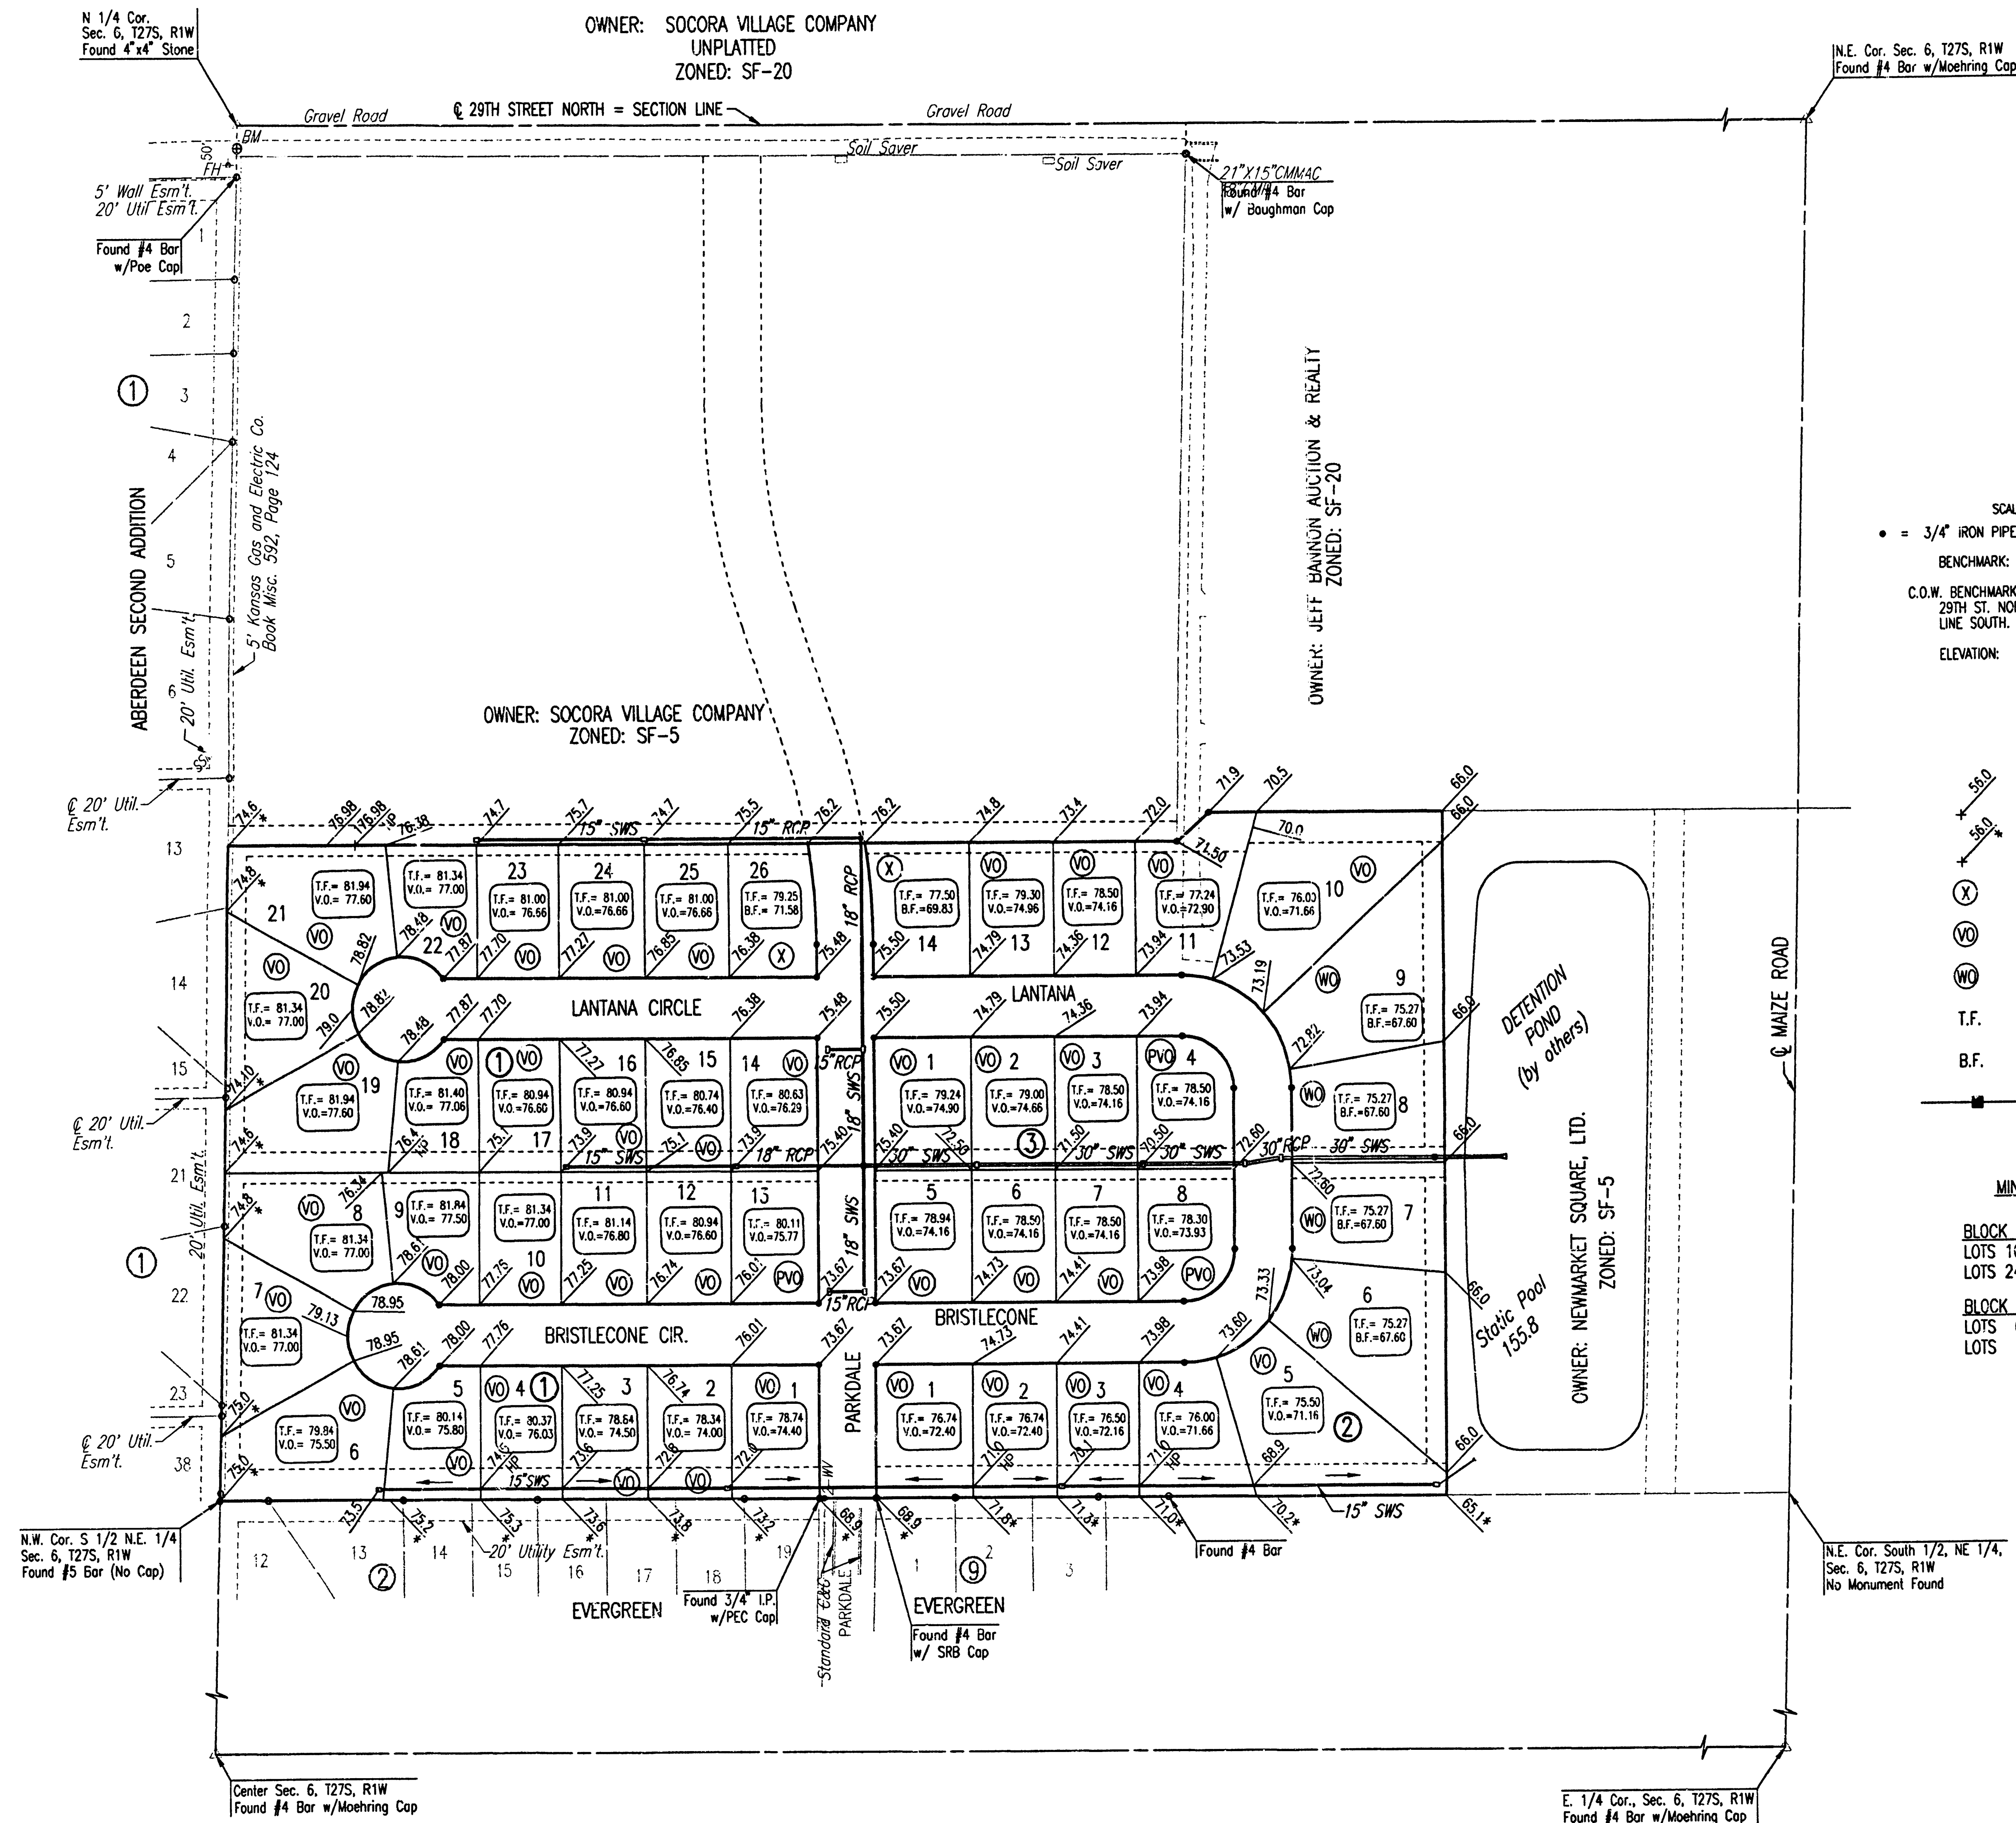


SCALE: 1"=100'
• = 3/4" IRON PIPE W/PEC CAP UNLESS OTHERWISE NOTED
BENCHMARK:
C.O.W. BENCHMARK - 0.5 MILES WEST OF MAZE ROAD, ON
29TH ST. NORTH, SOUTH RIGHT-OF-WAY, ON POLE
LINE SOUTH.
ELEVATION: 178.29 CITY DATUM

- LEGEND**
- SPOT ELEVATION
 - MATCH EXISTING ELEVATION
 - STD. BASEMENT
 - VIEW-OUT BASEMENT
 - WALK-OUT BASEMENT
 - T.F. TOP OF FOUNDATION
 - B.F. BASEMENT FLOOR
 - STORM SEWER AND INLET

MINIMUM OPENING

BLOCK 1	
LOTS 10-17	170.40
LOTS 24-26	171.90
BLOCK 2	
LOTS 6-10	162.00
LOTS 11-14	171.90

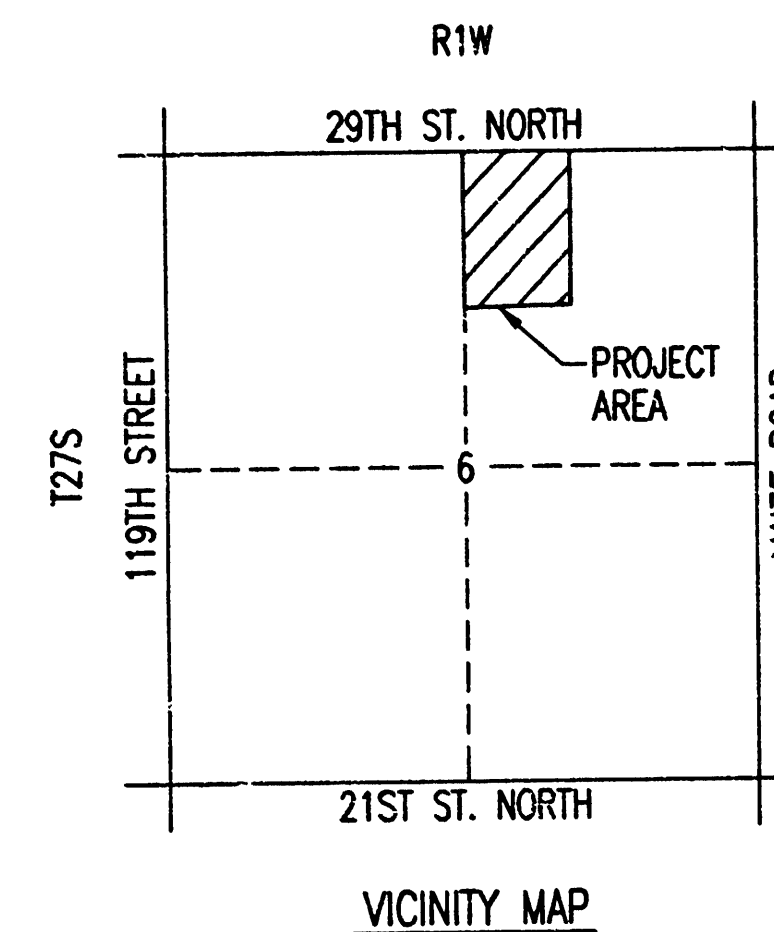

REVISED 12/4/03

Professional Engineering Consultants, P.A.
303 S. TOPEKA • WICHITA, KANSAS 67202
316-262-2691 • FAX 316-262-3003

EVERGREEN 4th

1st REVIEW OCT
ON 8 JUN 2004

Revised MARKED 8 JUN 2004