


0727

471H

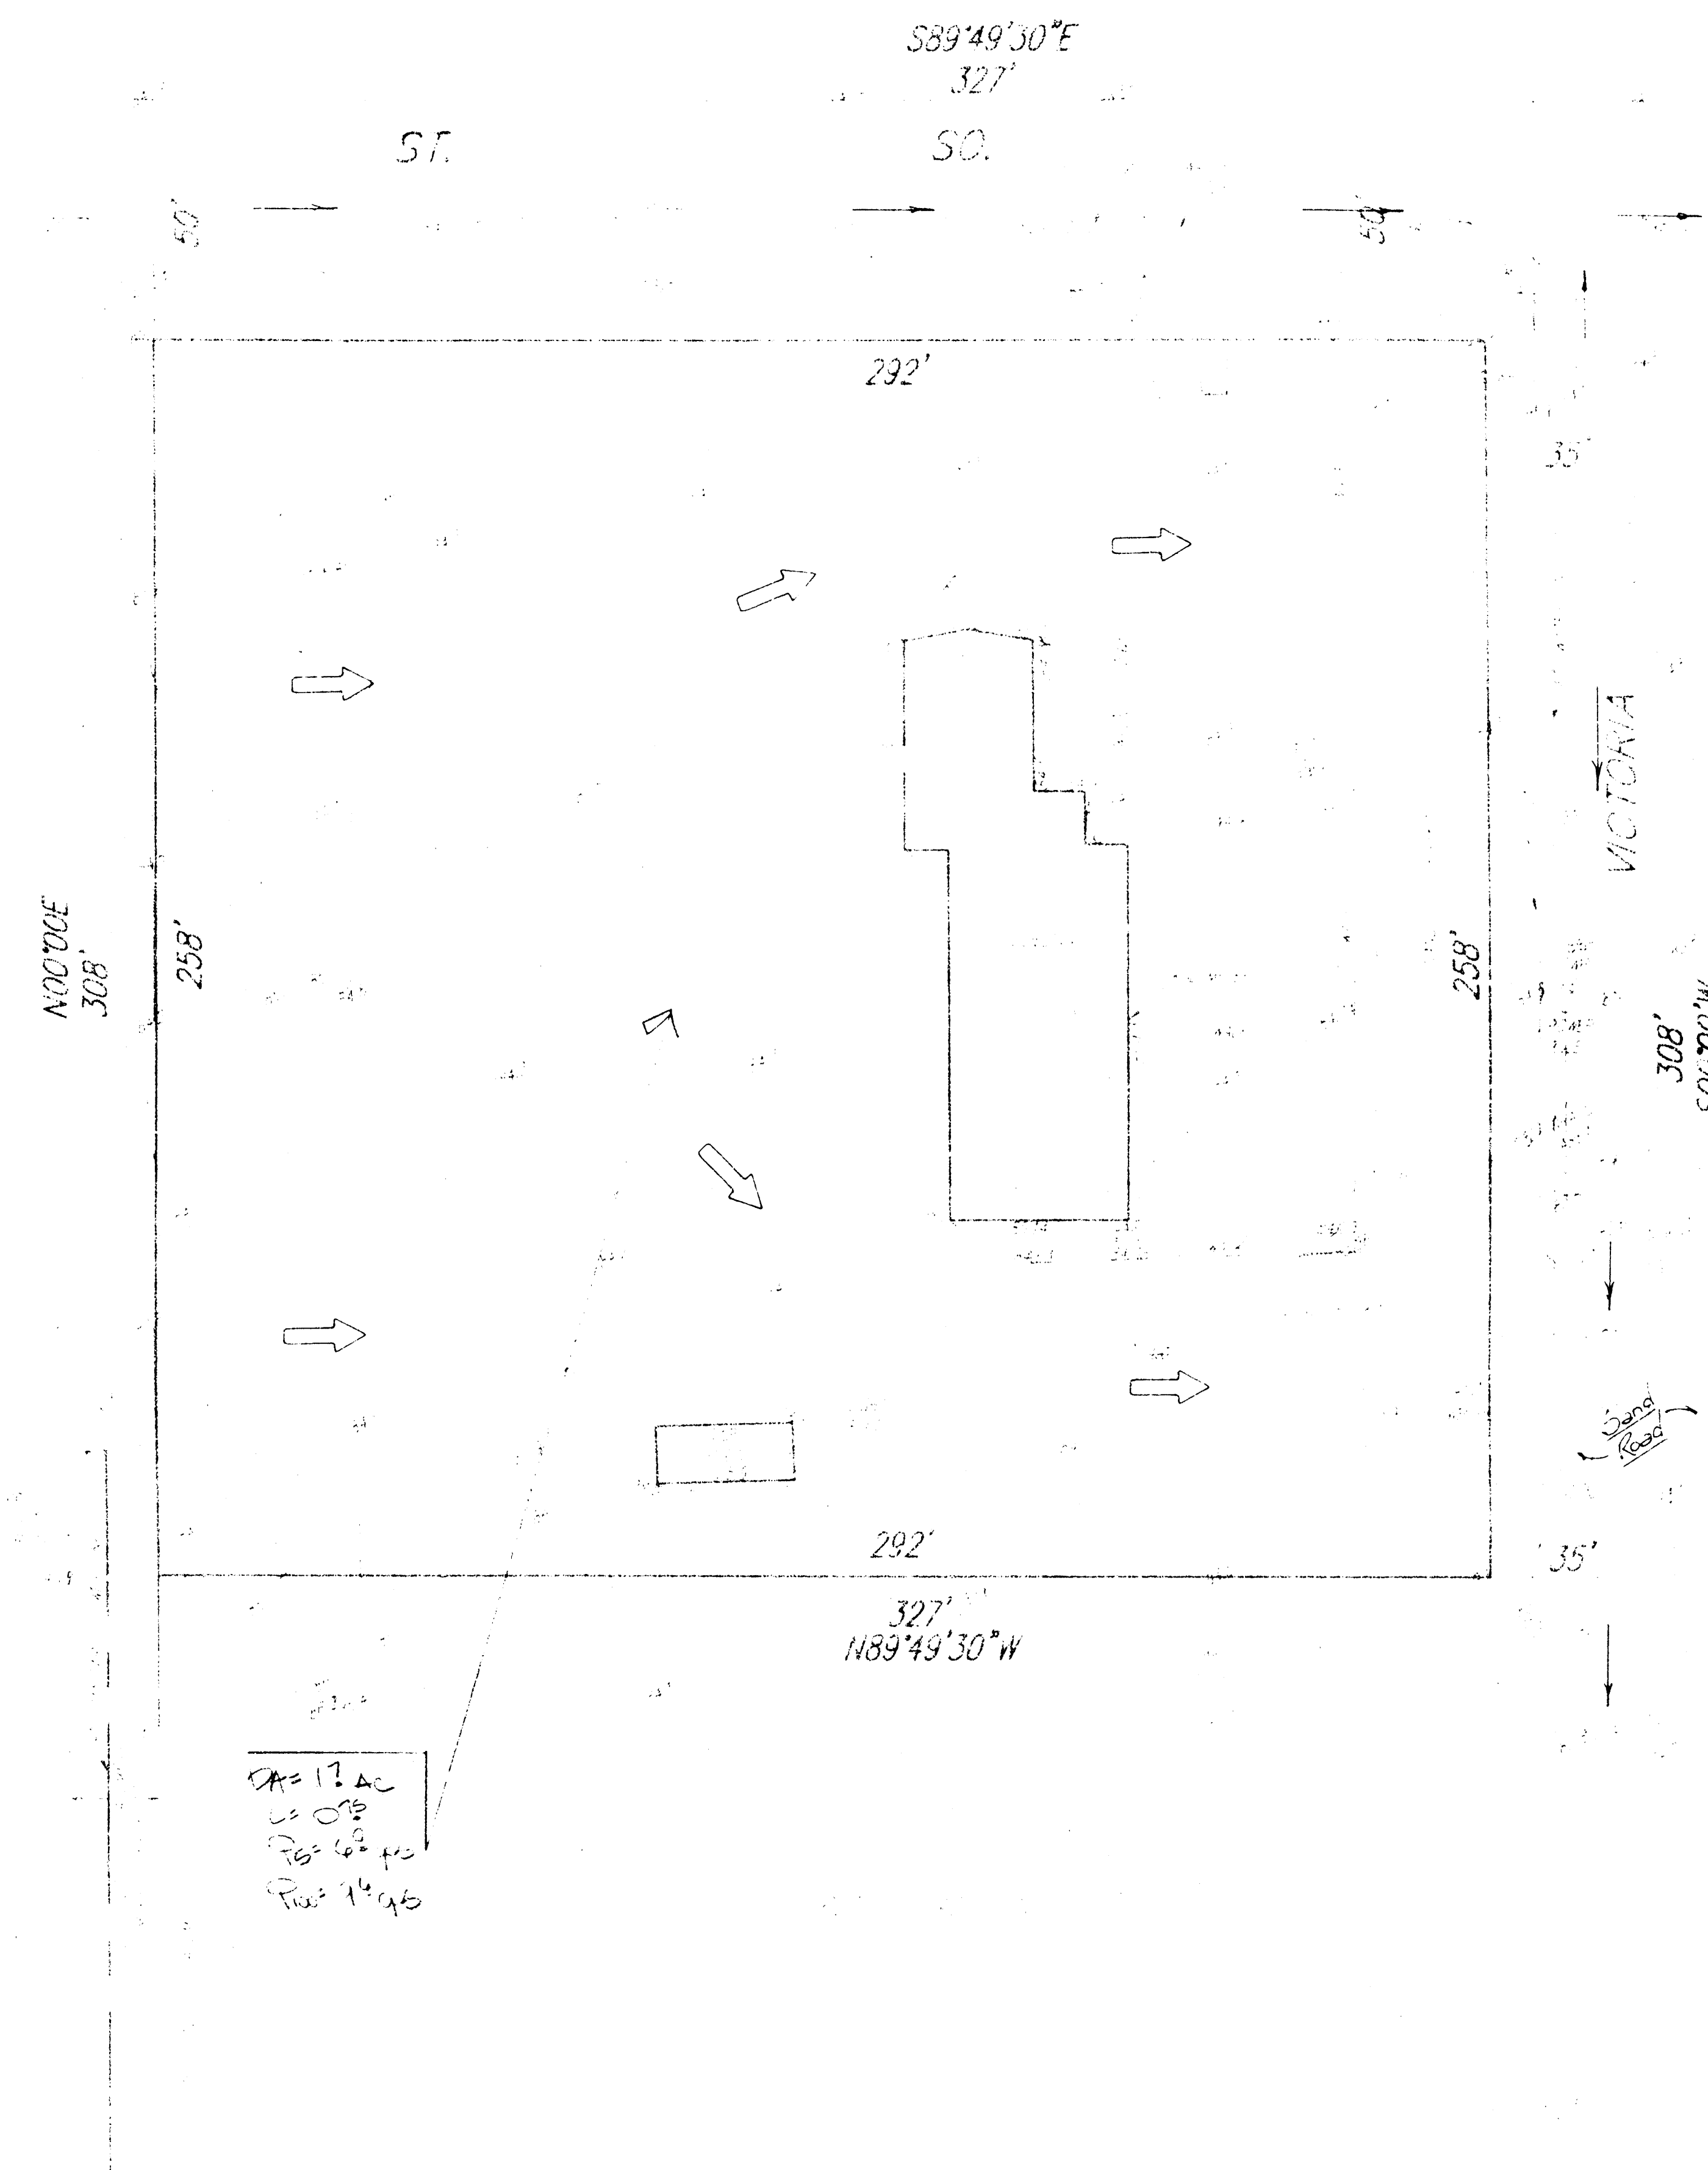

SKETCH PLAT

GOOD SHEPHERD LUTHERAN CHURCH ADDITION

DRAINAGE PLAN

48