
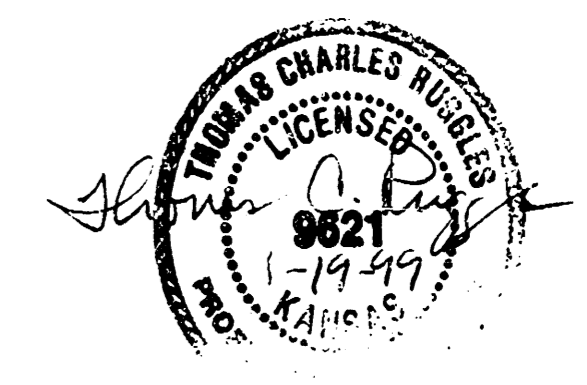


LEGEND

- 162.31 TC PROPOSED TOP OF CURB ELEVATION
- 162.31 PROPOSED GROUND ELEVATION
- 163 PROPOSED CONTOUR
- EXISTING GROUND ELEVATION
- GF 163.18 PROPOSED GARAGE FLOOR ELEVATION
- VO 158.96 PROPOSED VIEW OUT ELEVATION

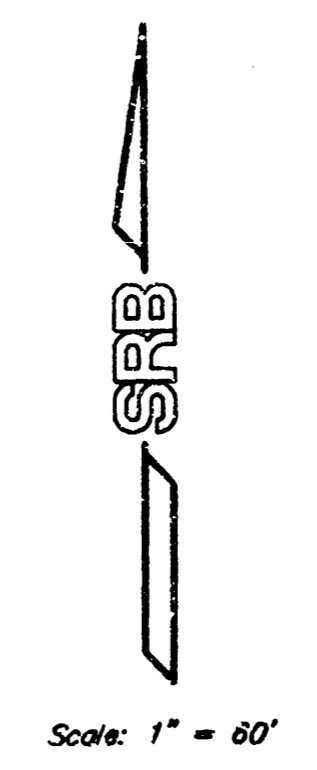

Revised 19 JAN 1999
**REVISED LOT GRADING PLAN FOR
 GRAF-GOLDSTON 2ND ADDITION AND
 PART OF BLOCK 5, GRAF-GOLDSTON ADDITION**

SRB		924 NORTH MAIN WICHITA, KANSAS 67203	316-264-8008 FAX 264-4621	REVISED 1-19-99
SAVOY, RUGGLES & BOHM, P.A. ENGINEERING & SURVEYING				PROJECT NUMBER 1
DRAWN DKD/KWL	DESIGN T.C.R.	REVIEW	DATE Mar. 1, 1996	UTILITY T.C.R.
SRB JOB 139E			DATE 1-19-99	SCALE 1"=60'