

BAUGHMAN COMPANY, P.A.
SURVEYING & ENGINEERING
316 42-7271 • 330 LAURA • WICHITA, KANSAS 67211

CONFIRMATION
MEMO

PROJECT JO HERDT ADDITION DATE 2-6-84
JOB NO. _____
TO Chris Breitenstein
FROM N. Brent Wooten
REFERENCE Final Drainage Plan

Final plat is scheduled for subdivision for Feb. 16, 1984.

The lot will be developed for Light industrial usage with a runoff factor of 0.85 used. The Lot 1 (2.6 acres) will drain east to Victoria St. (unpaved) and south in the existing Victoria ditch approximately 120' to existing ditch inlets (SWS 229) and pipe. Discharge to Victoria presently will be thru drives or flumes as is necessary when developed.

Draw to unpaved st.


To Herdt Addn.

B+C) drain to unpaved st.

OK with O+N?

Do we require guarantee to pave adjacent to plat?

1-5-84
Drainage plan

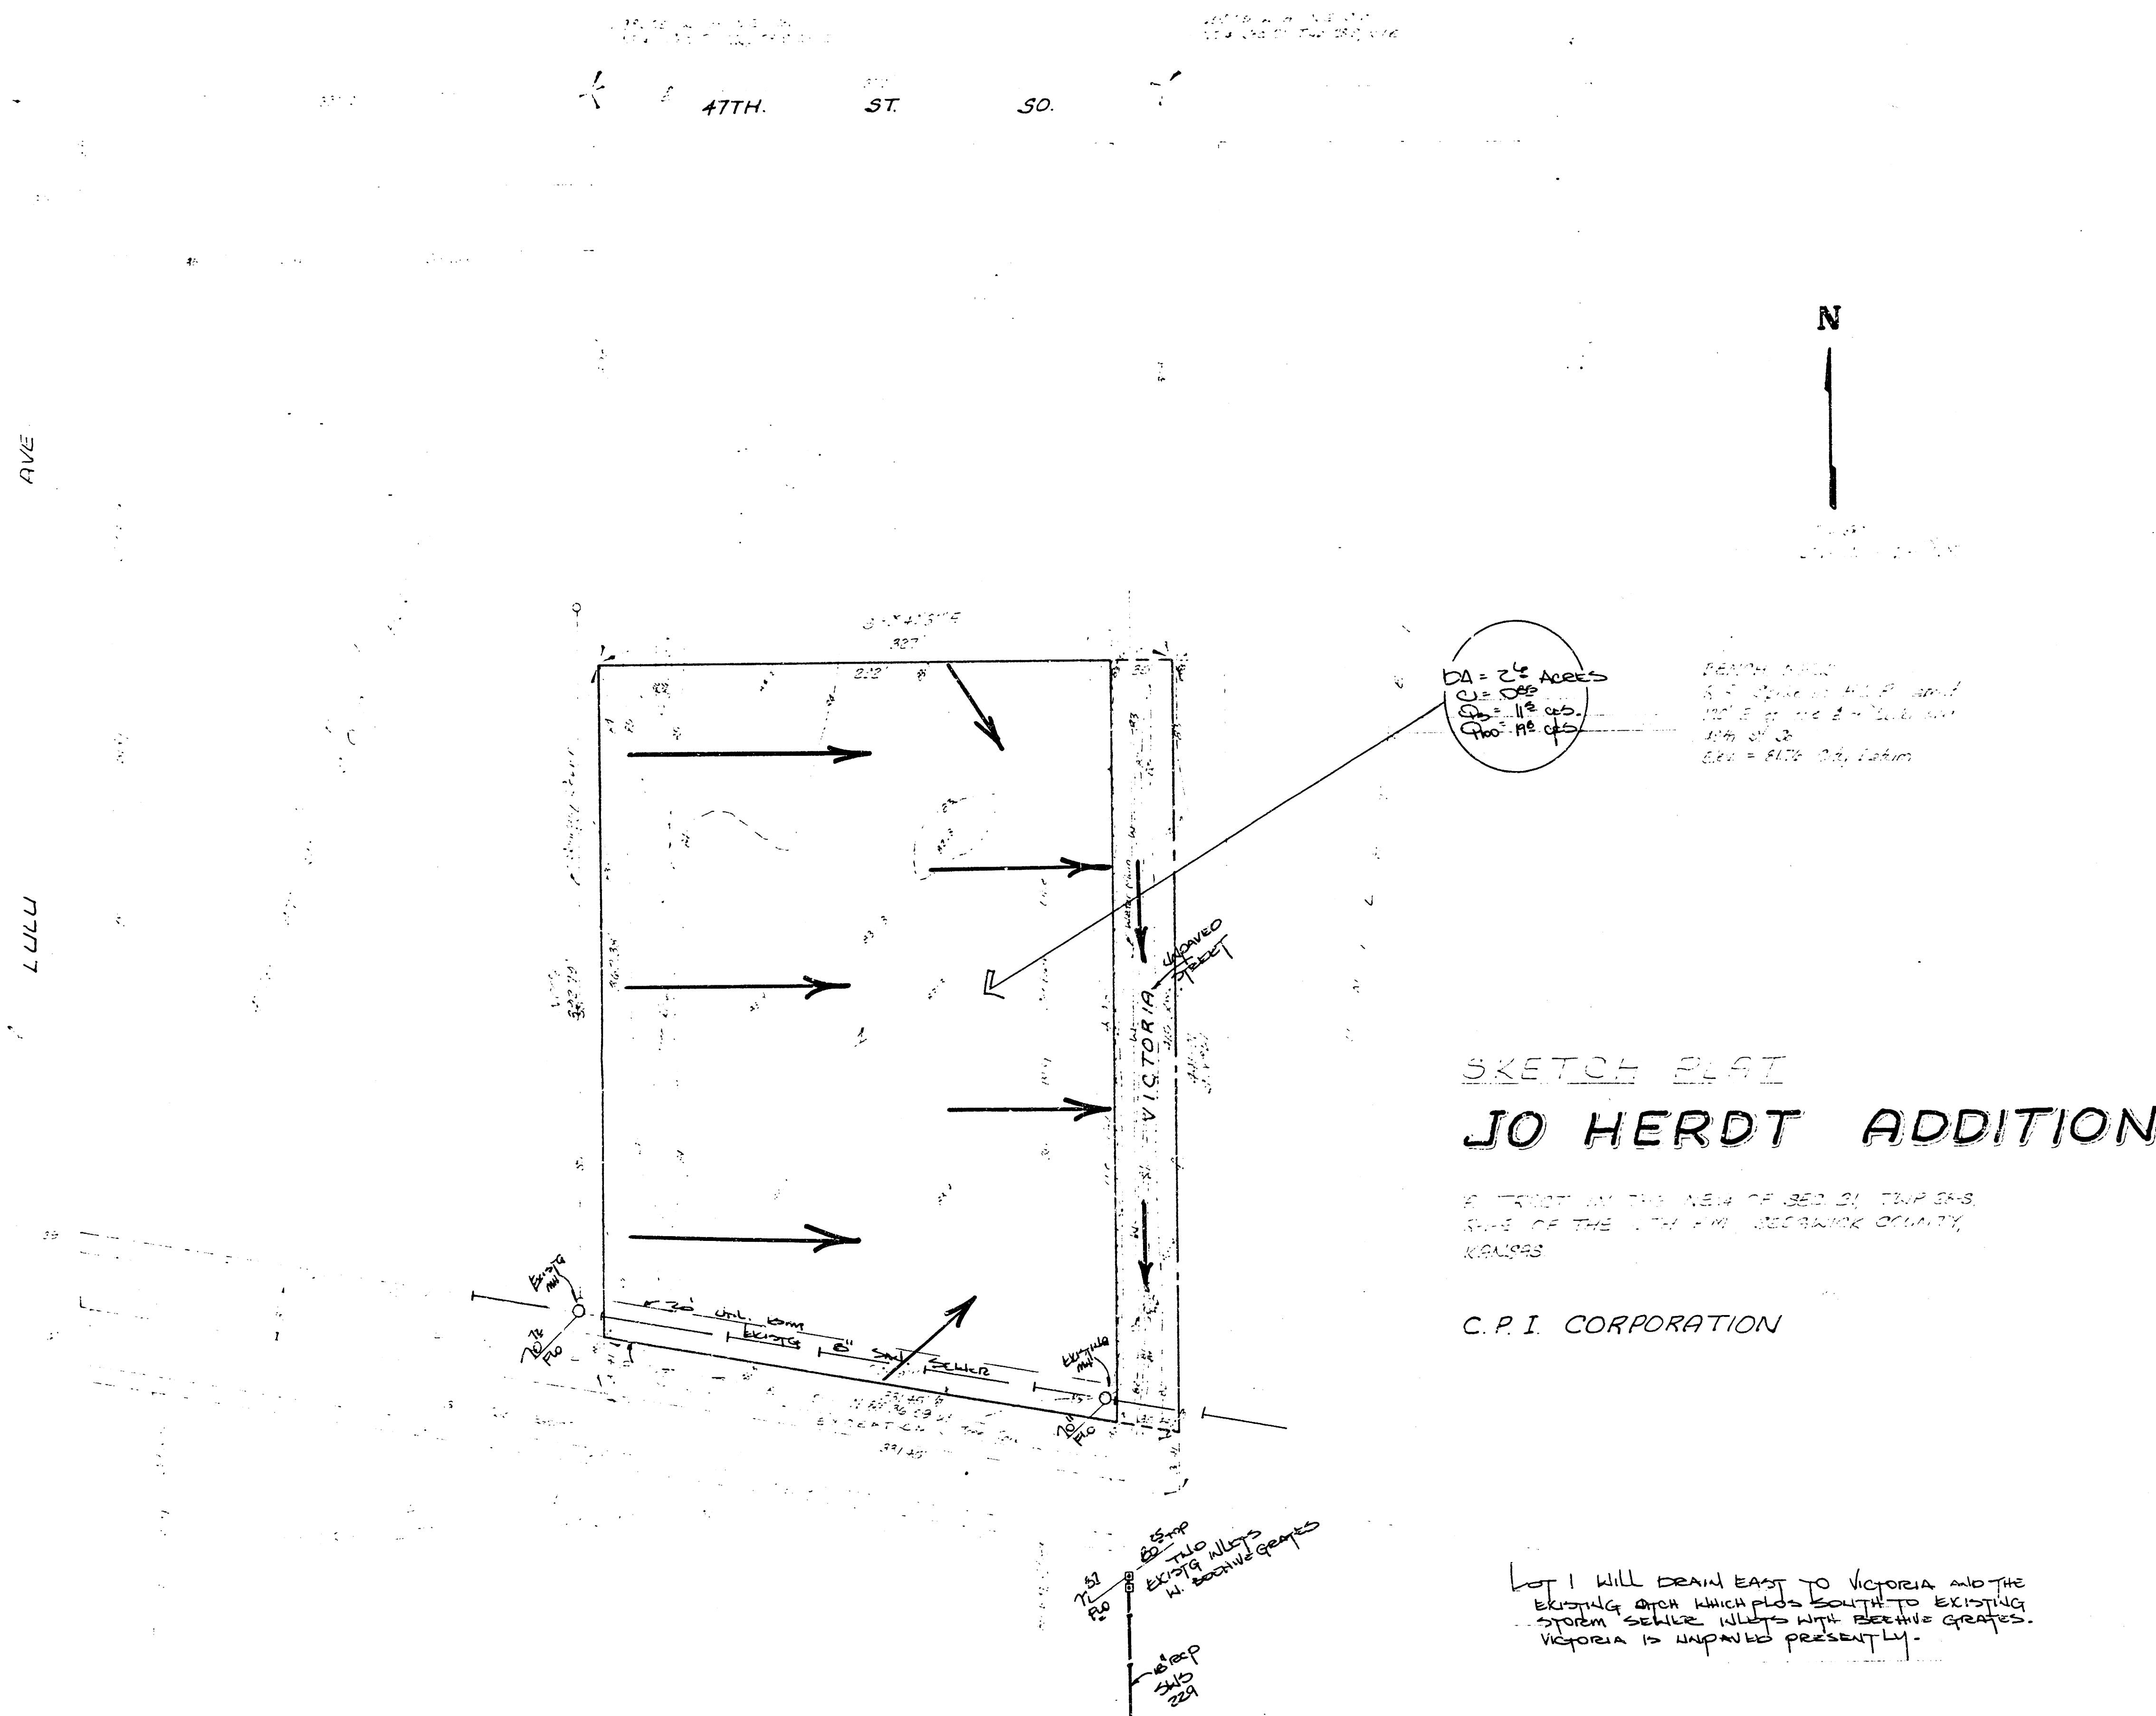

BAUGHMAN COMPANY, P.A.
SURVEYING & ENGINEERING
316 42-7271 • 330 LAURA • WICHITA, KANSAS 67211