



DRAINAGE AREA	AREA ACRES	AREA ACCUM.	C5	C100	TC5	TC100	IS	I100	OS	O100	PIPE SIZE	PIPE SLOPE	INLETS
AREA I LIGHT COMMERCIAL TYPE B SOIL	4.5		0.70	0.80	22	17	3.41	7.00	120	252	21"	0.9%	AREA INLET
AREA II APARTMENTS TYPE B SOIL	8.8		0.70	0.60	24	18	3.65	6.84	225	182			

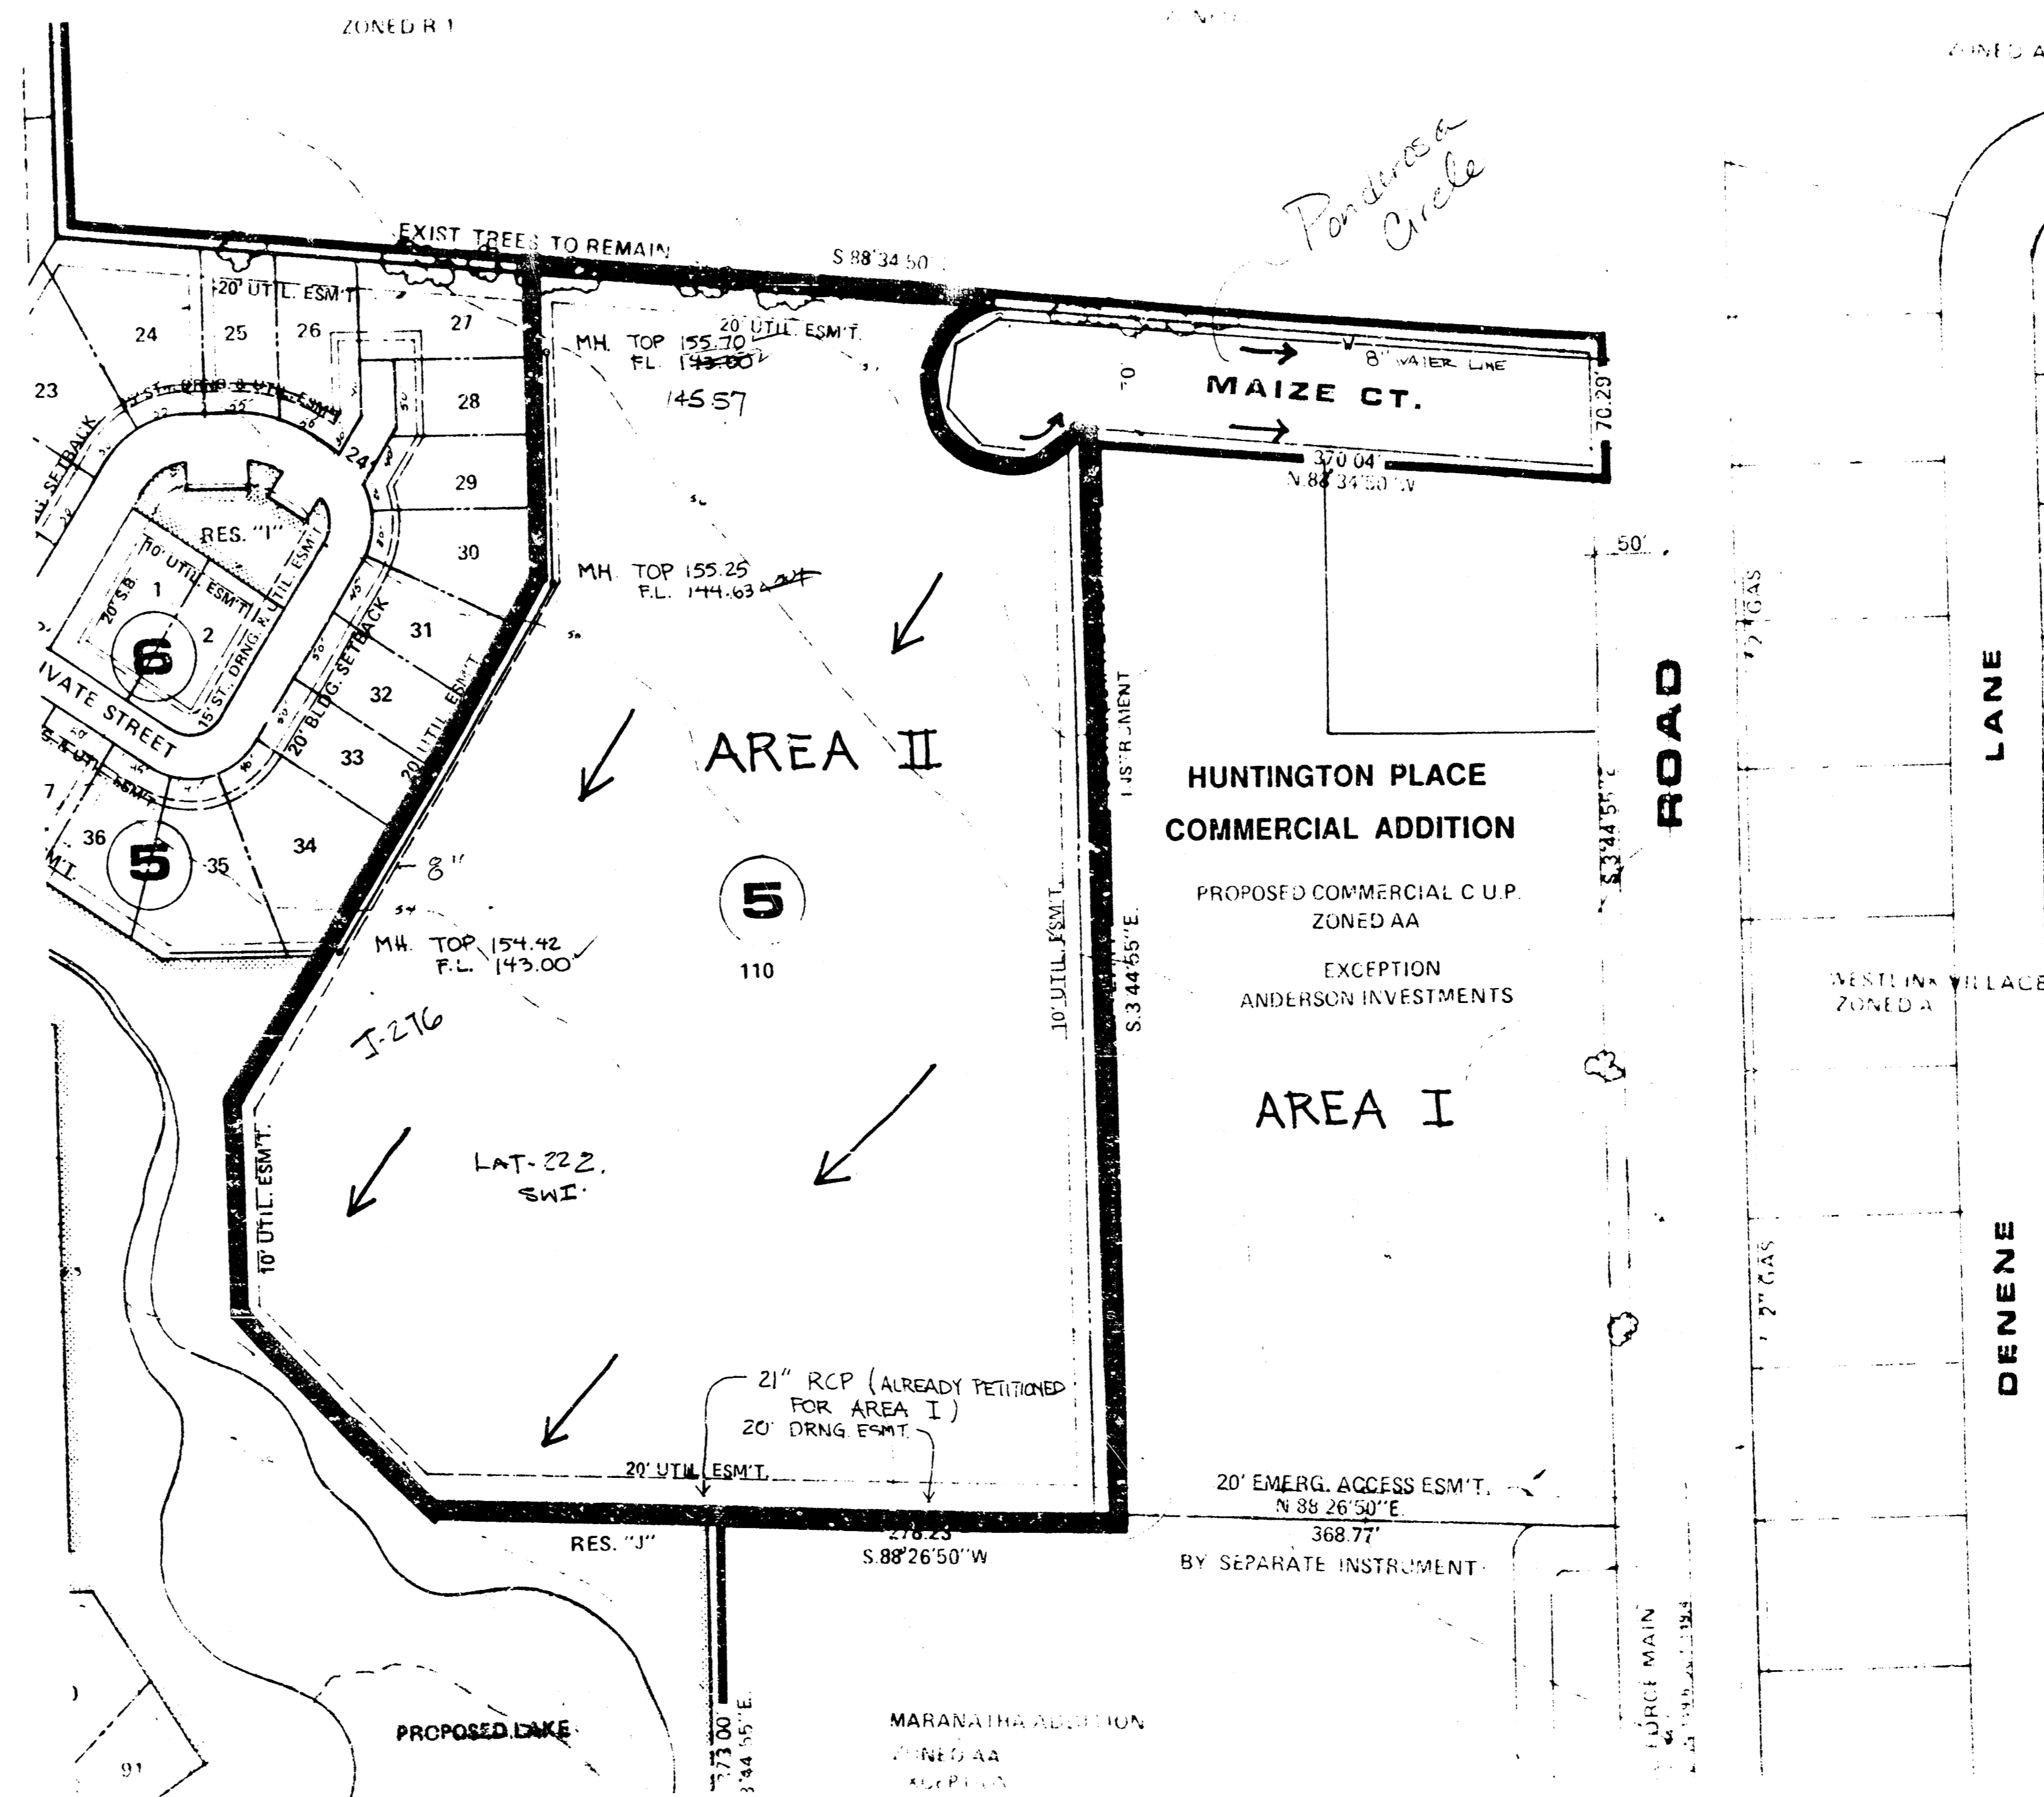

**APPROVED
DRAINAGE PLAN**

	HUNTINGTON PLACE 4TH ADDITION	Design Drawn by Checked by Date 9/24/91 Issue
	DRAINAGE PLAN	Sheet 1/1 of
MID-KANSAS ENGINEERING CONSULTANTS PA 3500 NORTH ROCK ROAD BUILDING #800 WICHITA, KANSAS 67226		682-6561