


Keener Add.

7

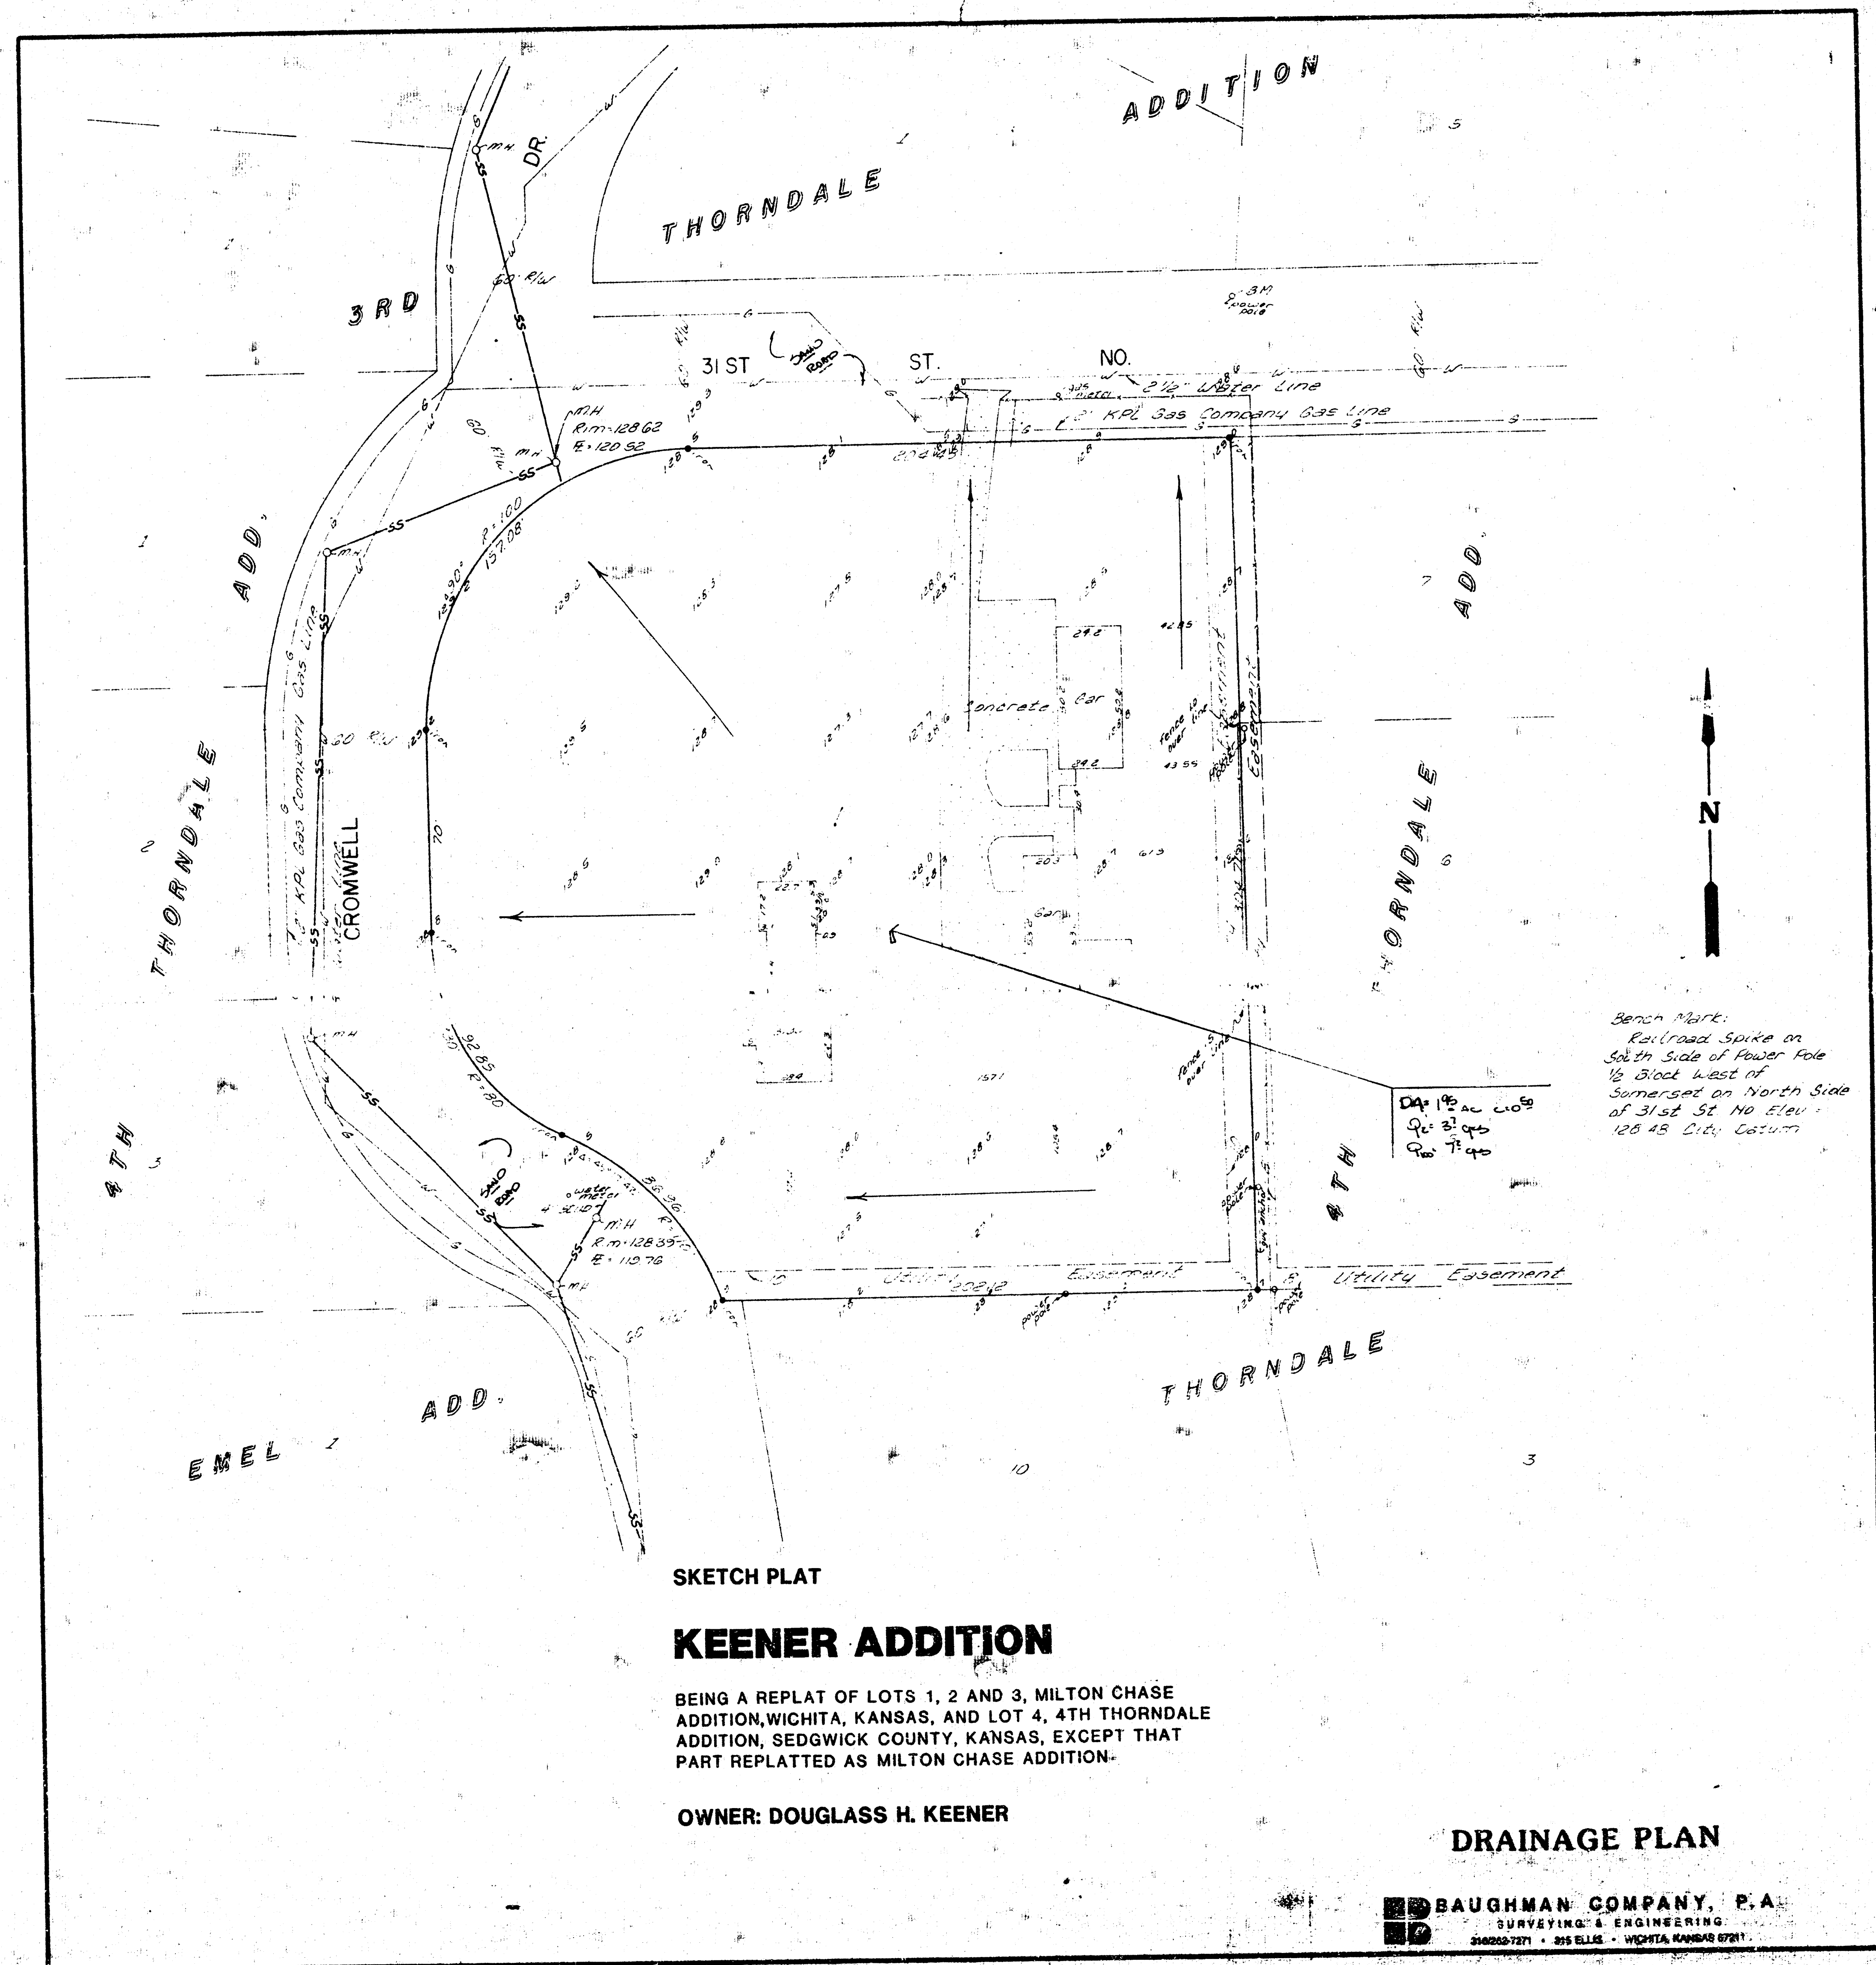

SKETCH PLAT

KEENER ADDITION

BEING A REPLAT OF LOTS 1, 2 AND 3, MILTON CHASE ADDITION, WICHITA, KANSAS, AND LOT 4, 4TH THORNDALE ADDITION, SEDGWICK COUNTY, KANSAS, EXCEPT THAT PART REPLATTED AS MILTON CHASE ADDITION.

OWNER: DOUGLASS H. KEENER

DRAINAGE PLAN

ED BAUGHMAN COMPANY, P.A.
SURVEYING & ENGINEERING
