


KENYON'S KORNER ADDITION
(Drainage)

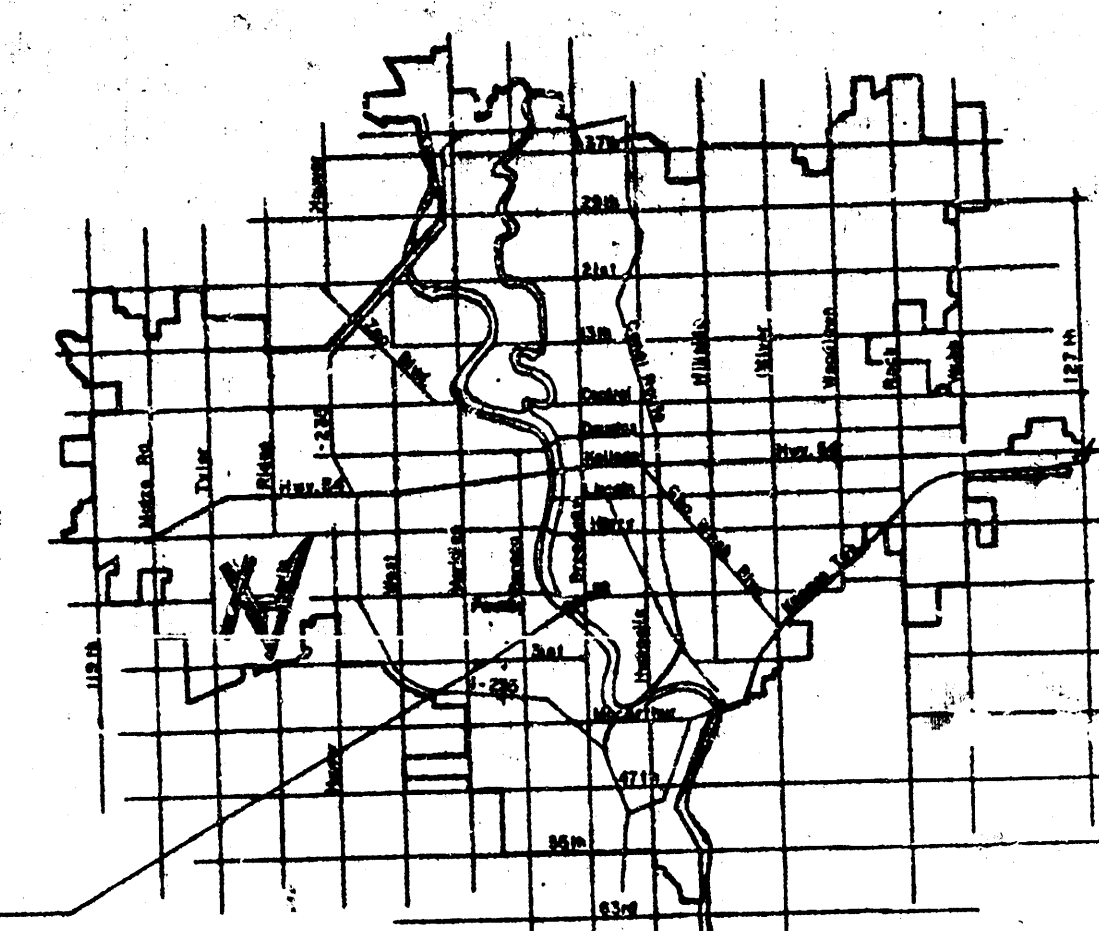

Project Location

VICINITY MAP

1" = 20'
• = Iron

LEGEND -


W = Water Main
G = Gas Main
OE = Overhead Electric
OT = Overhead Telephone
UT = Underground Telephone
PP = Power Pole
LP = Light Pole
SLC = Street Light Circuit
MH = Manhole
SS = Sanitary Sewer
AA = Spot Elevations
TC = Top of Curb
FL = Flow Line
TSB = Telephone Splice Box

PRELIMINARY PLAT
of
KENYON'S KORNER
Wichita, Sedgwick Co, Kansas

LEGAL DESCRIPTION:

LOT 2 IN PAWNEE SUB ADDITION AND
ALSO LOTS 10, 12 AND 14 ON TOPEKA
AVENUE IN HILBISH & HETTINGER'S
ADDITION TO WICHITA, SEDGWICK
COUNTY, KANSAS.

SITE
DRAINAGE PLAN

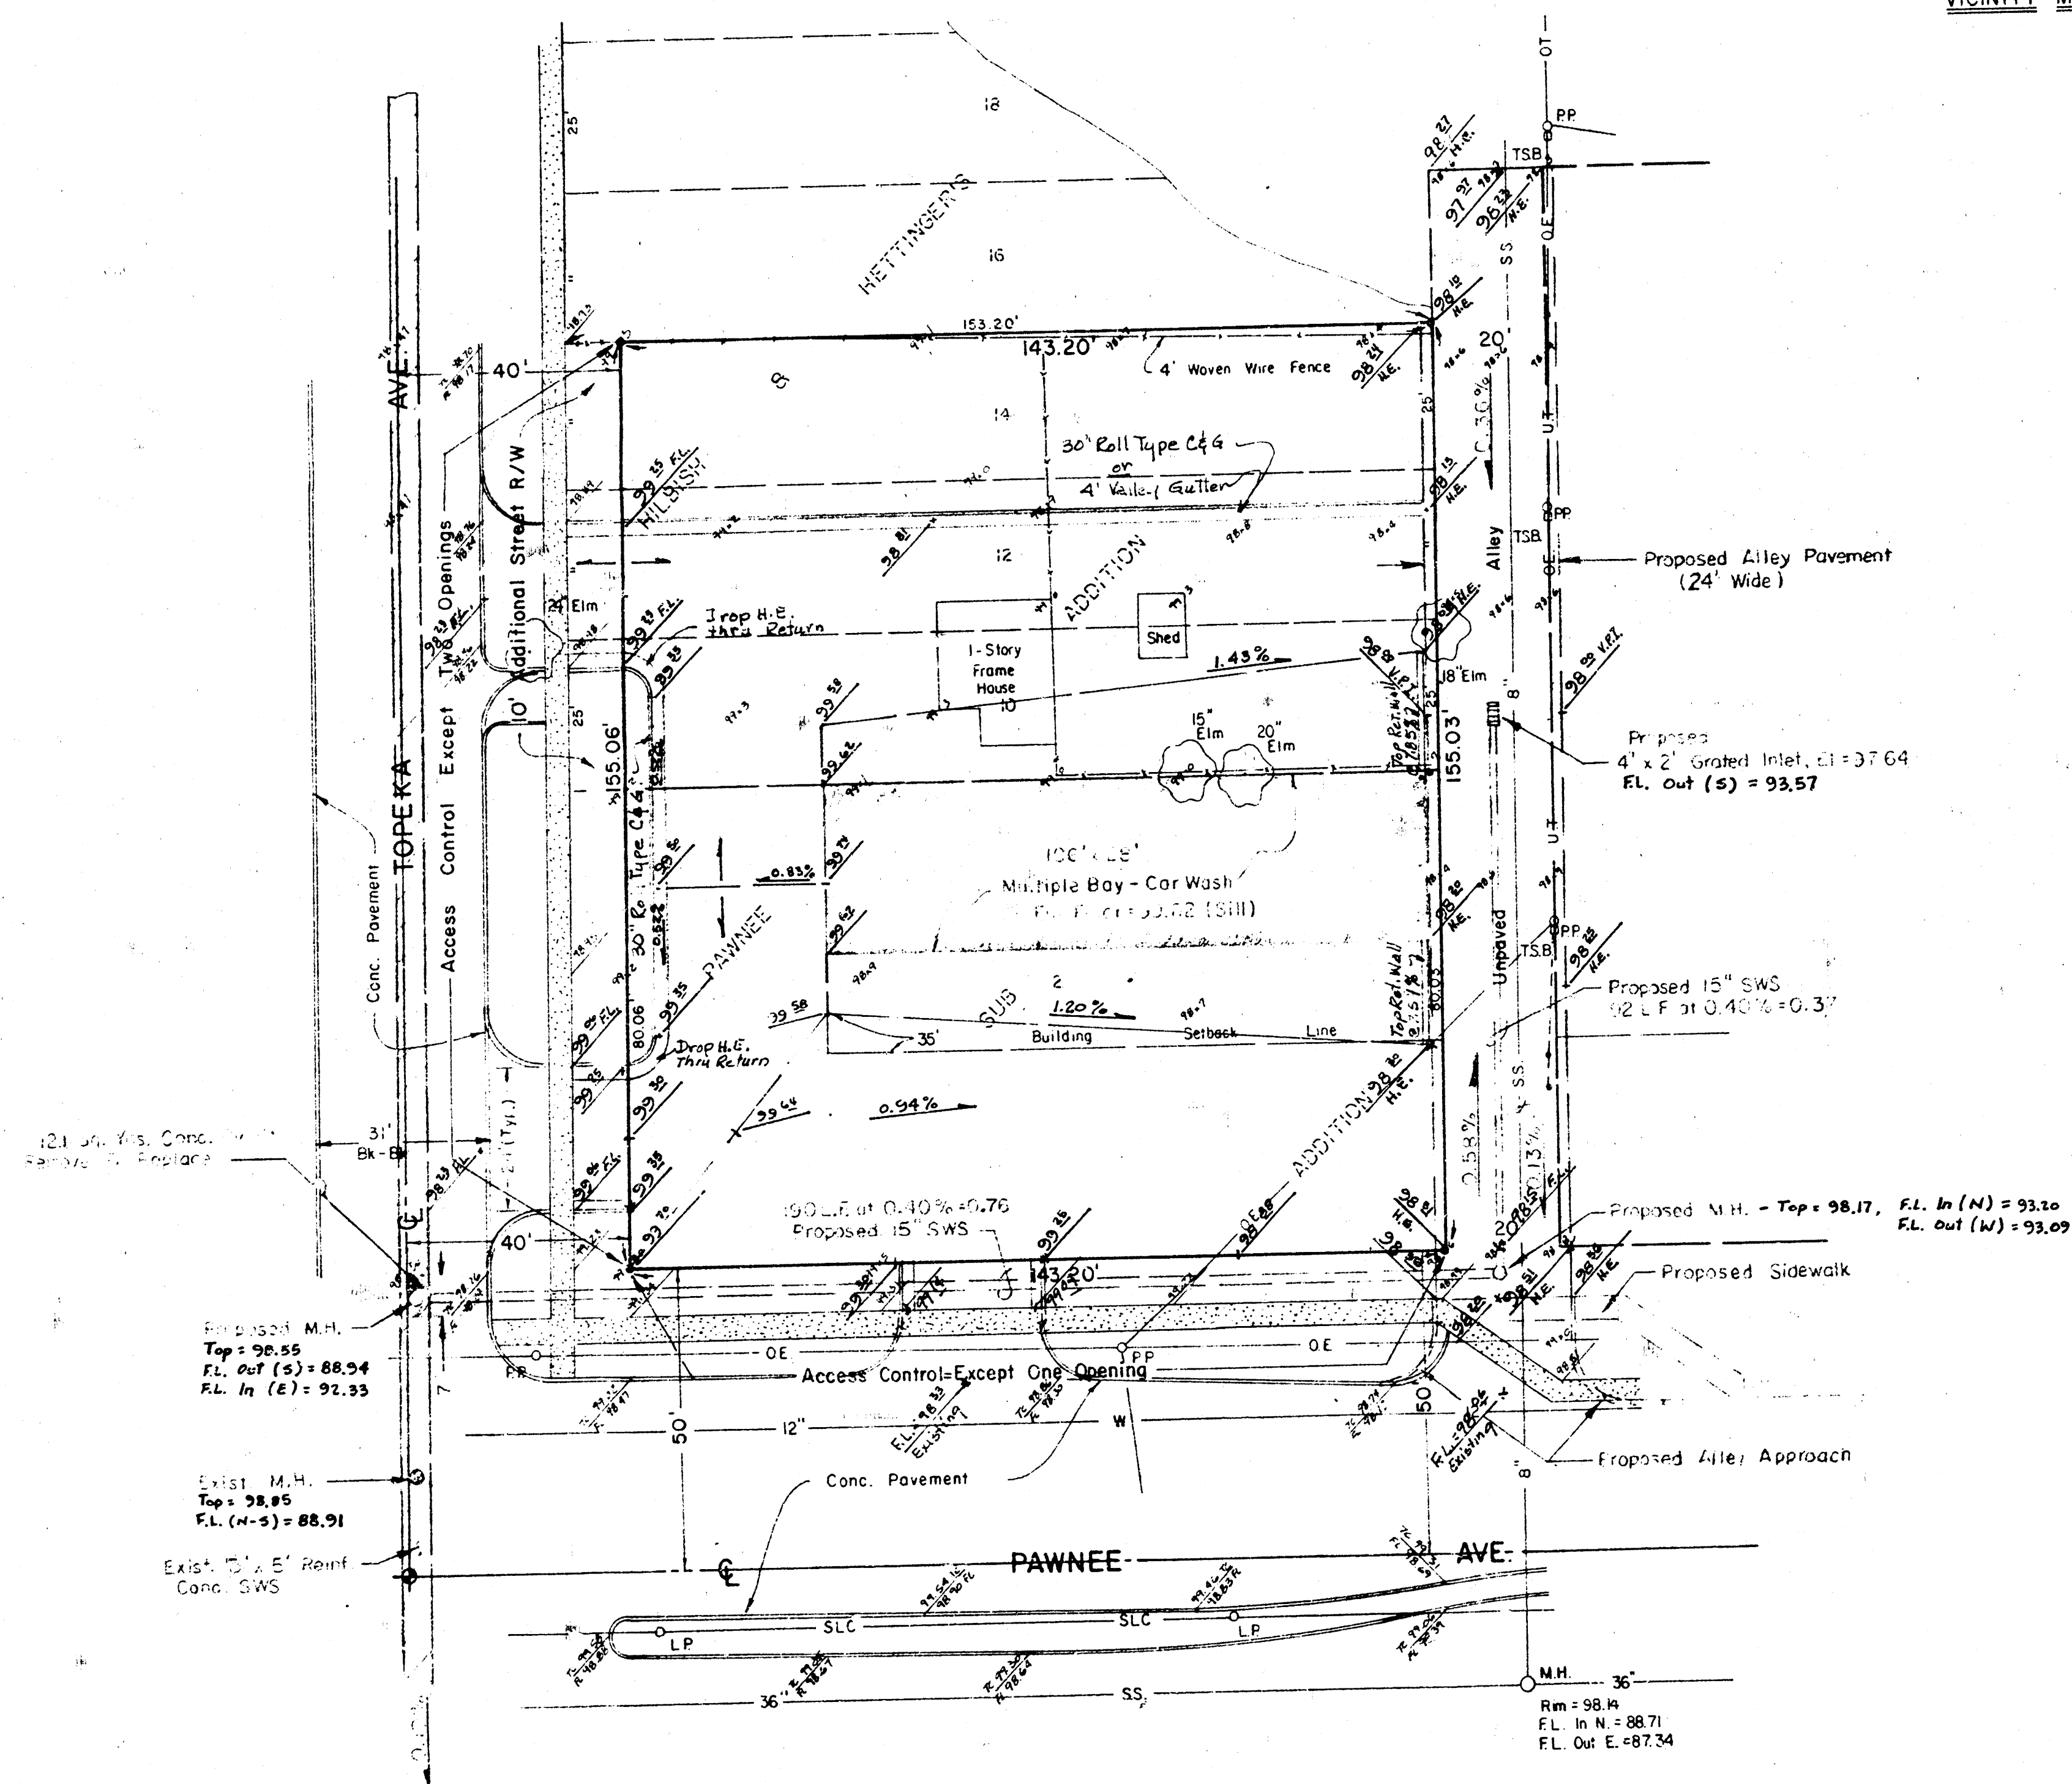

MOEHRING & ASSOCIATES
CONSULTING ENGINEERS
WICHITA

