
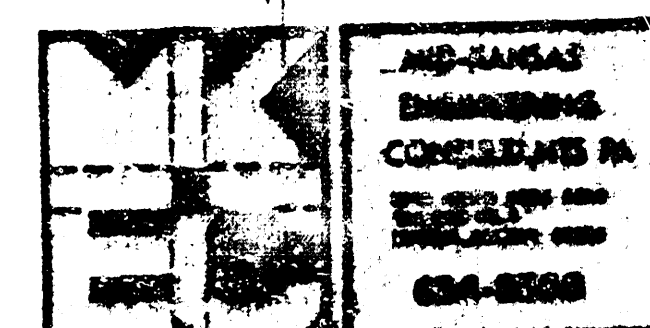


NOTES :


1. CITY OF WICHITA B.M. DISC. 44" S. AND 48" W. OF THE INTERSECTION OF ROCK ROAD AT 37TH STREET NORTH ELEV. = 204.11
2. A DRAINAGE CONCEPT WILL BE PREPARED BY MID-KANSAS ENGINEERING CONSULTANTS.
3. TOPOGRAPHY IN THE AREA OF THE NEW WILLIOWOOD BRIDGE IS CURRENTLY UNDER CONSTRUCTION AND WILL BE TO BE FIELD VERIFIED. CONTOURS SHOWN ARE PROPOSED, NOT AS-BUILT.

TOTAL SQ. FT. = 934,64
TOTAL ACRES = 21.4

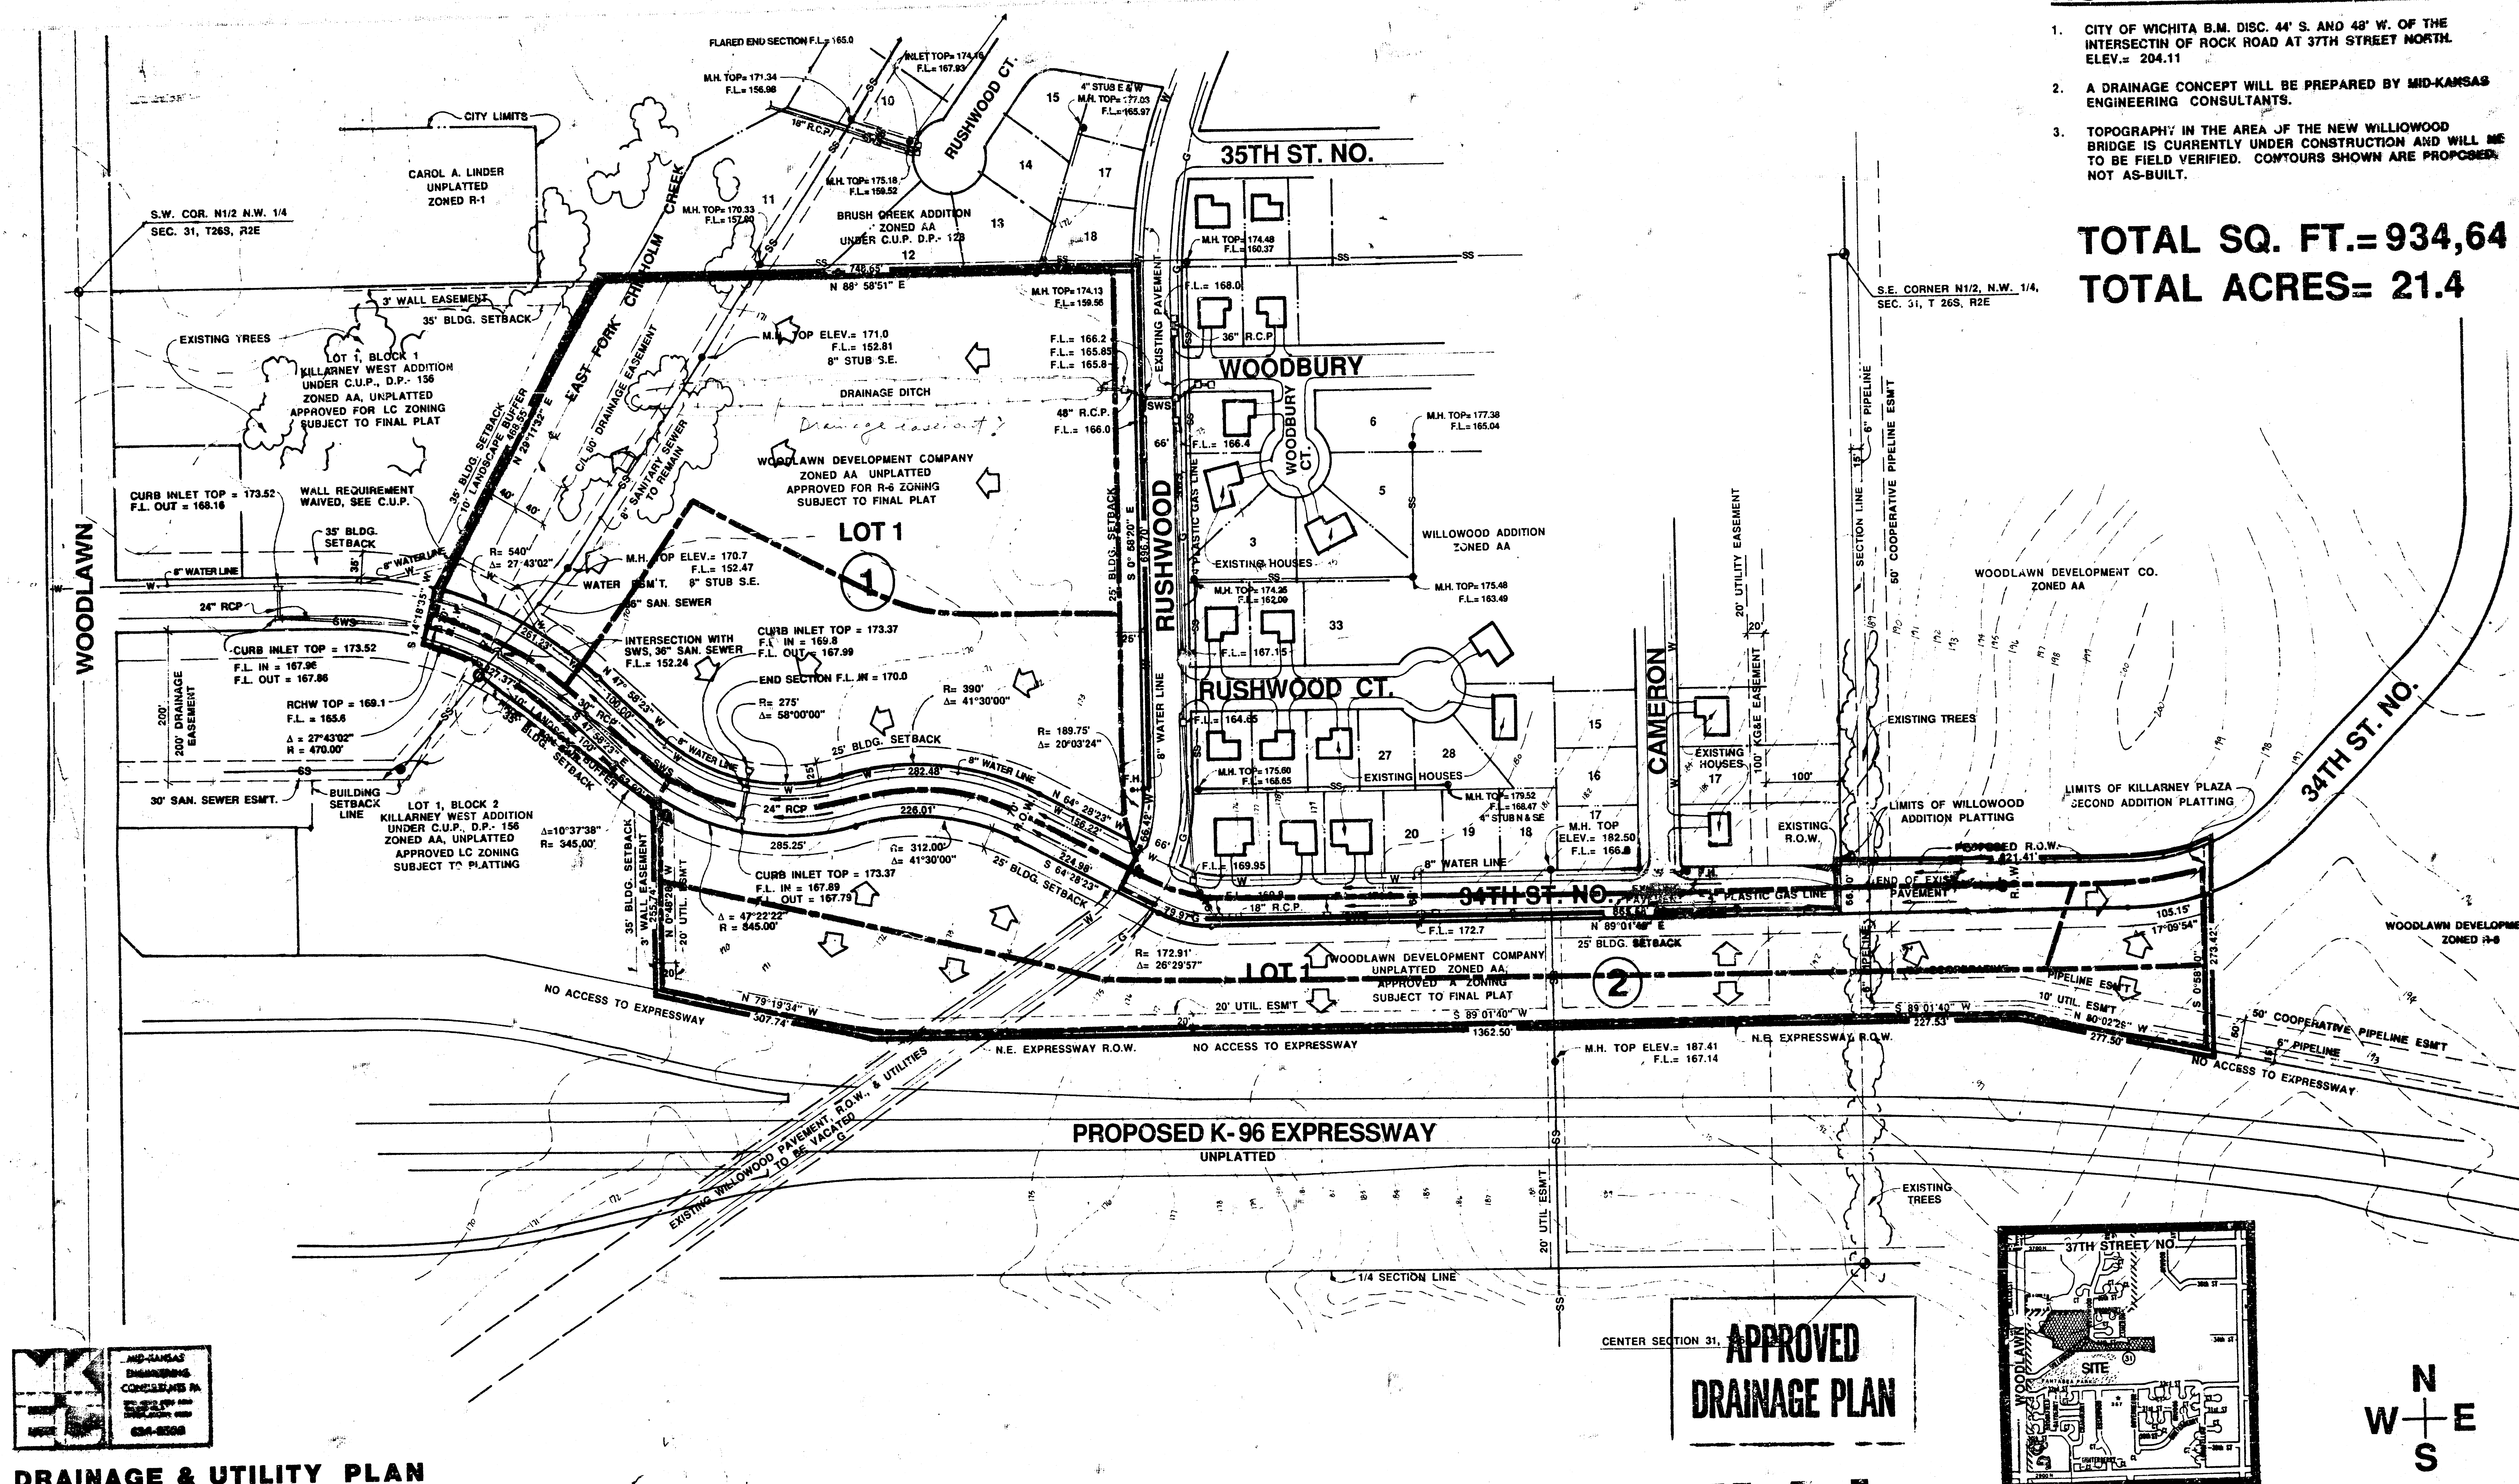


DRAINAGE & UTILITY PLAN

KILLARNEY WEST RESIDENTIAL

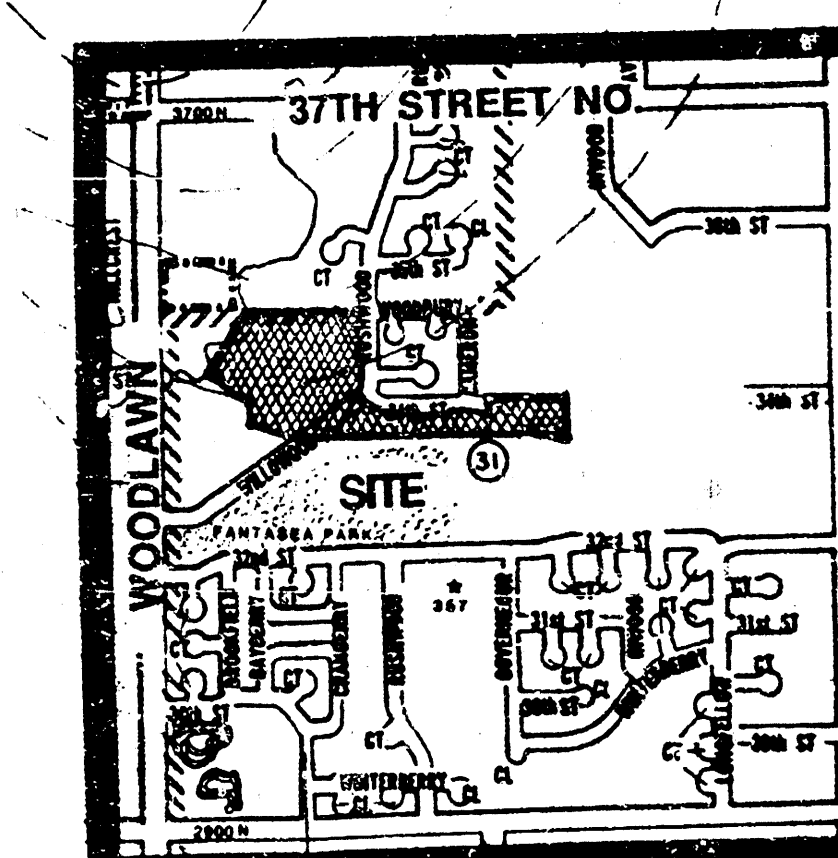

LOCATION MAP
NO SCALE

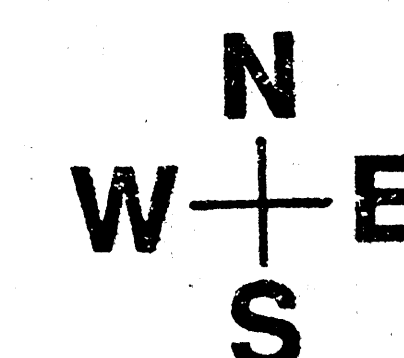

SCALE: 1" = 100'-0"
 CONTOUR INTERVAL = 1'