

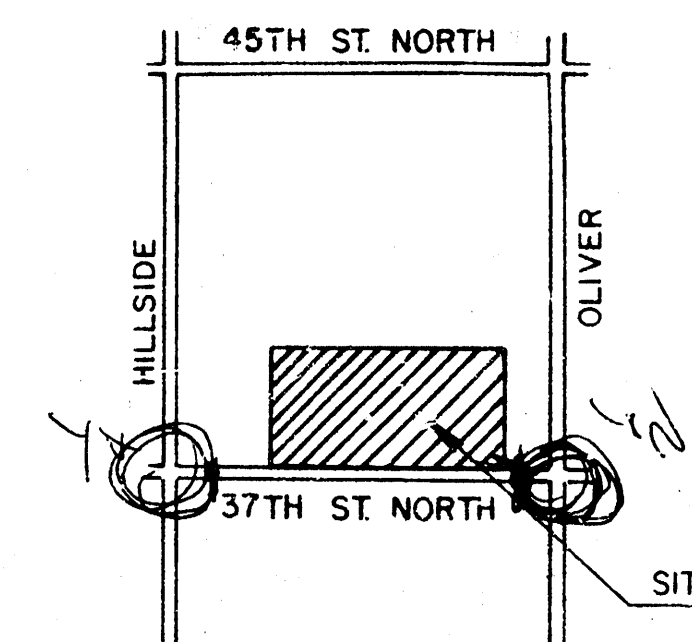


PRELIMINARY PLAT OF
KOCH OFFICE PARK THIRD ADDITION

AN ADDITION TO WICHITA, SEDGWICK COUNTY, KANSAS

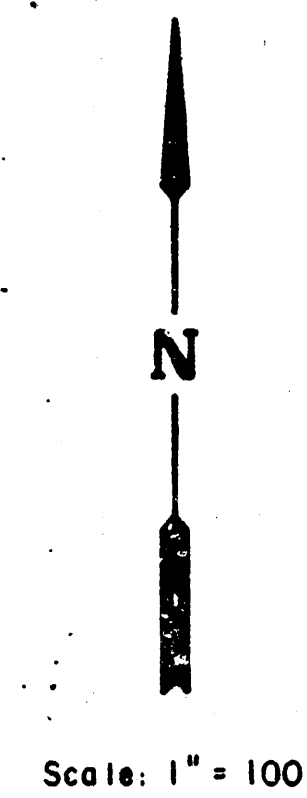

DRAINAGE & UTILITY CONCEPT

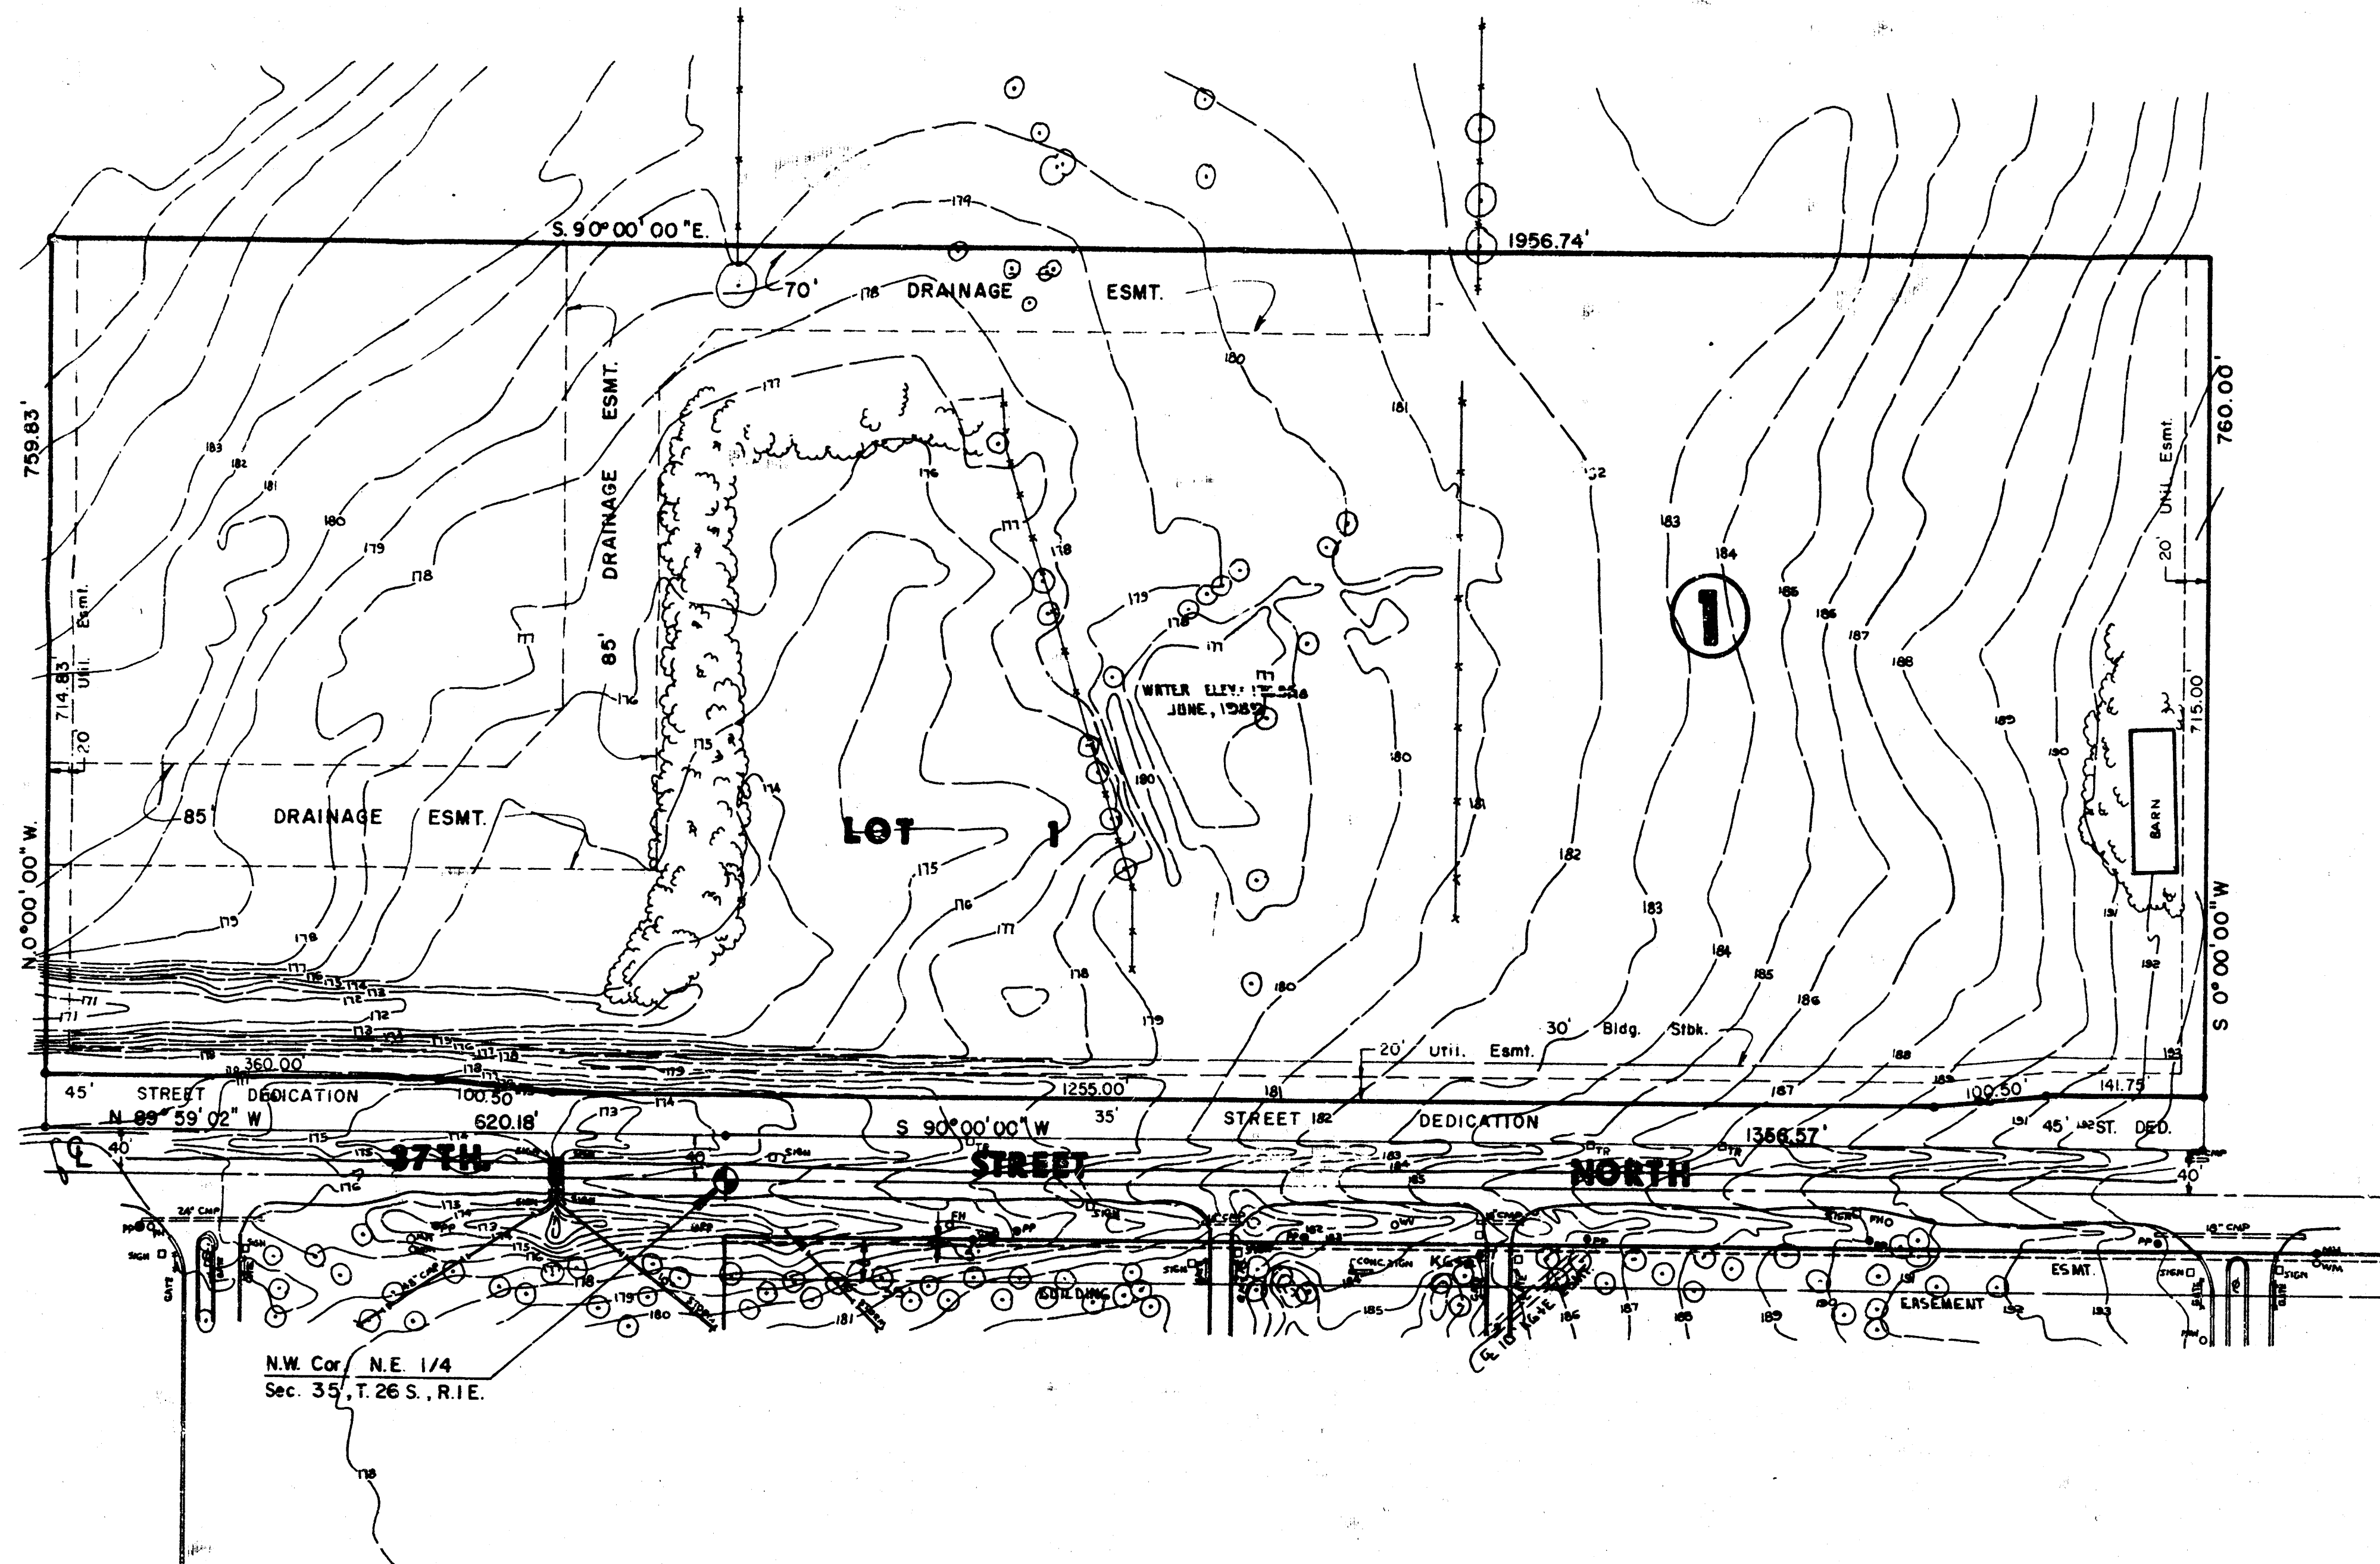

**KOCH OFFICE PARK
THIRD ADDITION**
KOCH INDUSTRIES
4111 E. 37TH ST NORTH
67226 PH. 832-5400

MID-KANSAS ENGINEERING CONSULTANTS P.A.
3500 NORTH ROCK ROAD
BUILDING #800
WICHITA, KANSAS 67226
636-5566




LETTER OF TRANSMITTAL

PROJECT: Koch Office Park 3rd Addition
PROJECT #: DATE: 11/29/89
TO: Vicky Huang
City Engineering Department
455 North Main - 7th Floor
Wichita, KS 67202

We are sending you the following items: ☒ Attached
☐ Under separate cover via
☐ Prints ☐ Specifications ☐ Legal Descriptions
☐ Tracing ☐ Petitions ☐ Correspondence ☐ Other

COMMENTS: One copy of the drainage basin affecting the referenced plat. Also one copy each of the computer runs showing that the Koch parking lot affects the basin runoff by about 20% or five (5) percent.

For Your Approval: ☒ For Your Use ☐ Approved as Noted
As Requested: ☐ For Review and Comment

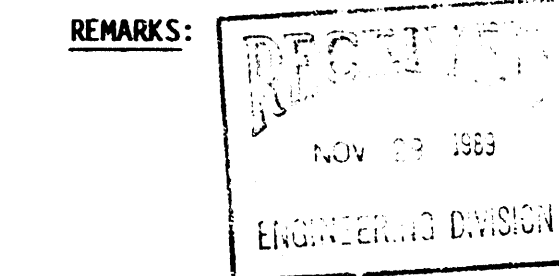

Signed: Kenneth H. Bengtson, P.E.
President

KHB/mrn

LIST OF INPUT DATA FOR THE HYDROLOGIC MODEL



COMPUTER PROGRAM FOR PROJECT FORMULATION - HYDROLOGIC USER NOTES

THE USER MANUAL FOR THIS PROGRAM IS THE ONLY USED PART OF THE CHANGES FROM THE DRAINAGE VERSION INCLUDE:

REAL ROUTING - THE ROUTING OPTION IN THE PREVIOUS VERSIONS REPLACES THE CURRENT METHOD. DATA DATA PREPARED FOR PREVIOUS VERSIONS BEING UNDER ROUTING COEFFICIENTS WILL NOT RUN ON THIS VERSION.

THE IMPROVED TIME OF CONCENTRATION DATA BEING ROUTING OF A REAL. IT IS RECOMMENDED THAT THE OPTIMAL CROSS SECTION DISCHARGE AREA BE USED WHENEVER NEW CROSS SECTION DATA IS ENTERED. THE ROUTE SHOULD BE CHECKED FOR REASONABLENESS AND ADEQUACY OF INPUT DATA FOR THE COMPUTATION OF IT VALUES USED IN THE ROUTING PROCEDURE.

GUIDELINES FOR DETERMINING OF ANALYTICAL DATA AND COEFFICIENTS (K) ARE AVAILABLE IN THE USER MANUAL. SUMMARY TABLE 2 DISPLAYS REAL ROUTING RESULTS AND ROUTING PARAMETERS FOR COMPUTATION AND ROUTING.

HYDROGRAPH CONVERSION - THE PROCEDURE TO CALCULATE THE OPTIMAL TIME INCREMENT AND PEAK TIME OF THE UNIT HYDROGRAPH HAVE BEEN IMPROVED. REAL ROUTING AND TIME INCREMENT FROM THE PREVIOUS VERSION. INPUT HYDROGRAPHS ARE STILL DISCRETELY PRINTED, AND ROUTED AT THE USER SELECTED MAIN TIME INCREMENT.

INTERMEDIATE TERMS - METHOD ADDED TO PROVIDE DISCHARGES AT INTERMEDIATE POINTS WITHIN REACHES WITHOUT ROUTING.

OTHER - THIS VERSION CONTAINS SOME ADDITIONS TO THE INPUT AND MANIPULATION CAPABILITIES TO THE USER. OPTIONS HAVE BEEN ADDED AND IMPROVED IN THE PREVIOUS VERSIONS. THE ROUTING OPTION IS NOT OPERATIONAL AT THIS TIME. CHANGES AND THE USER MANUALS CORRECTLY REFLECT THE ROUTING OPTION IS NOT OPERATIONAL AT THIS TIME.

PROGRAM CHANGES SINCE MAY 1982:

12/17/82 - CORRECT PEAK RATE FACTOR FOR USER ENTERED DATA.
5/12/83 - CORRECT COMPUTING FOR ---
1. DIVISION OF BASEFLOW TO DIVERSITY OPERATION
2. HYDROGRAPH AND UNIT HYDROGRAPH SLOPE AND MOVE BASEFLOW
3. CROSS SECTION DATA ROUTING POSITION
4. INTERMEDIATE PEAK WITHIN REACH AREA IS LARGER THAN THE AREA
5. CHANGE ROUTING FROM "REAL" TIME INCREMENT TO "STANDARD" HYDROGRAPH
6. IMPROVED "REAL" TIME INCREMENT FROM "STANDARD" HYDROGRAPH

COCH 37th STREET NORTH & 1/2 MILE POINT 2.5 IN. 100-HR 5-HR 24-HR DUNE 5

REV 05/01/83 10/04/87 25 SEP 1989











[illegible][illegible]

15 250
REF 0010103

[illegible]





























[illegible][illegible]





PERATION REPORT: STATION 1

12.71 222.84

19.96	218.02	1.87	2.65	1.74	1.60	1.52	1.45	1.41	1.36	1.31	1.27
-------	--------	------	------	------	------	------	------	------	------	------	------

... (faint text) ...

2-YR 5-YR 10-YR 100-YR

11
12
[illegible]

12
13
14

25	30	30	17.2	49.00
24	30	30	16	48.00

[illegible]