



LANDSOWNE ADDITION
(Drainage)

SKETCH PLAT
PRELIMINARY PLAT OF
LANDSOWNE ADDITION

OWNER: R. P. Lansdowne and Sharon L. Lansdowne
2526 E. Central
Wichita, Ks.

ENGINEER: P.E.C. p.a.
1440 English
Wichita, Ks.

1" = 30'

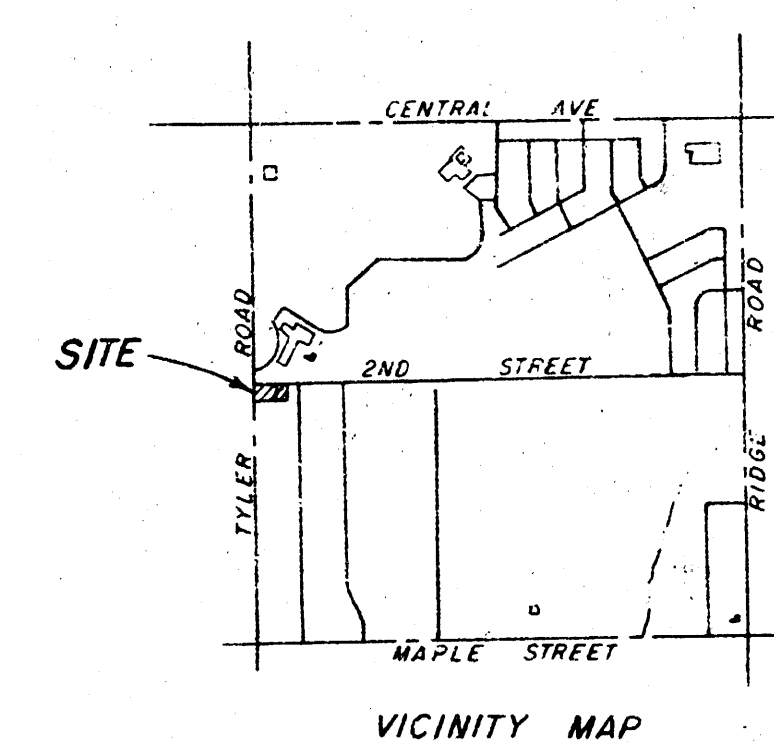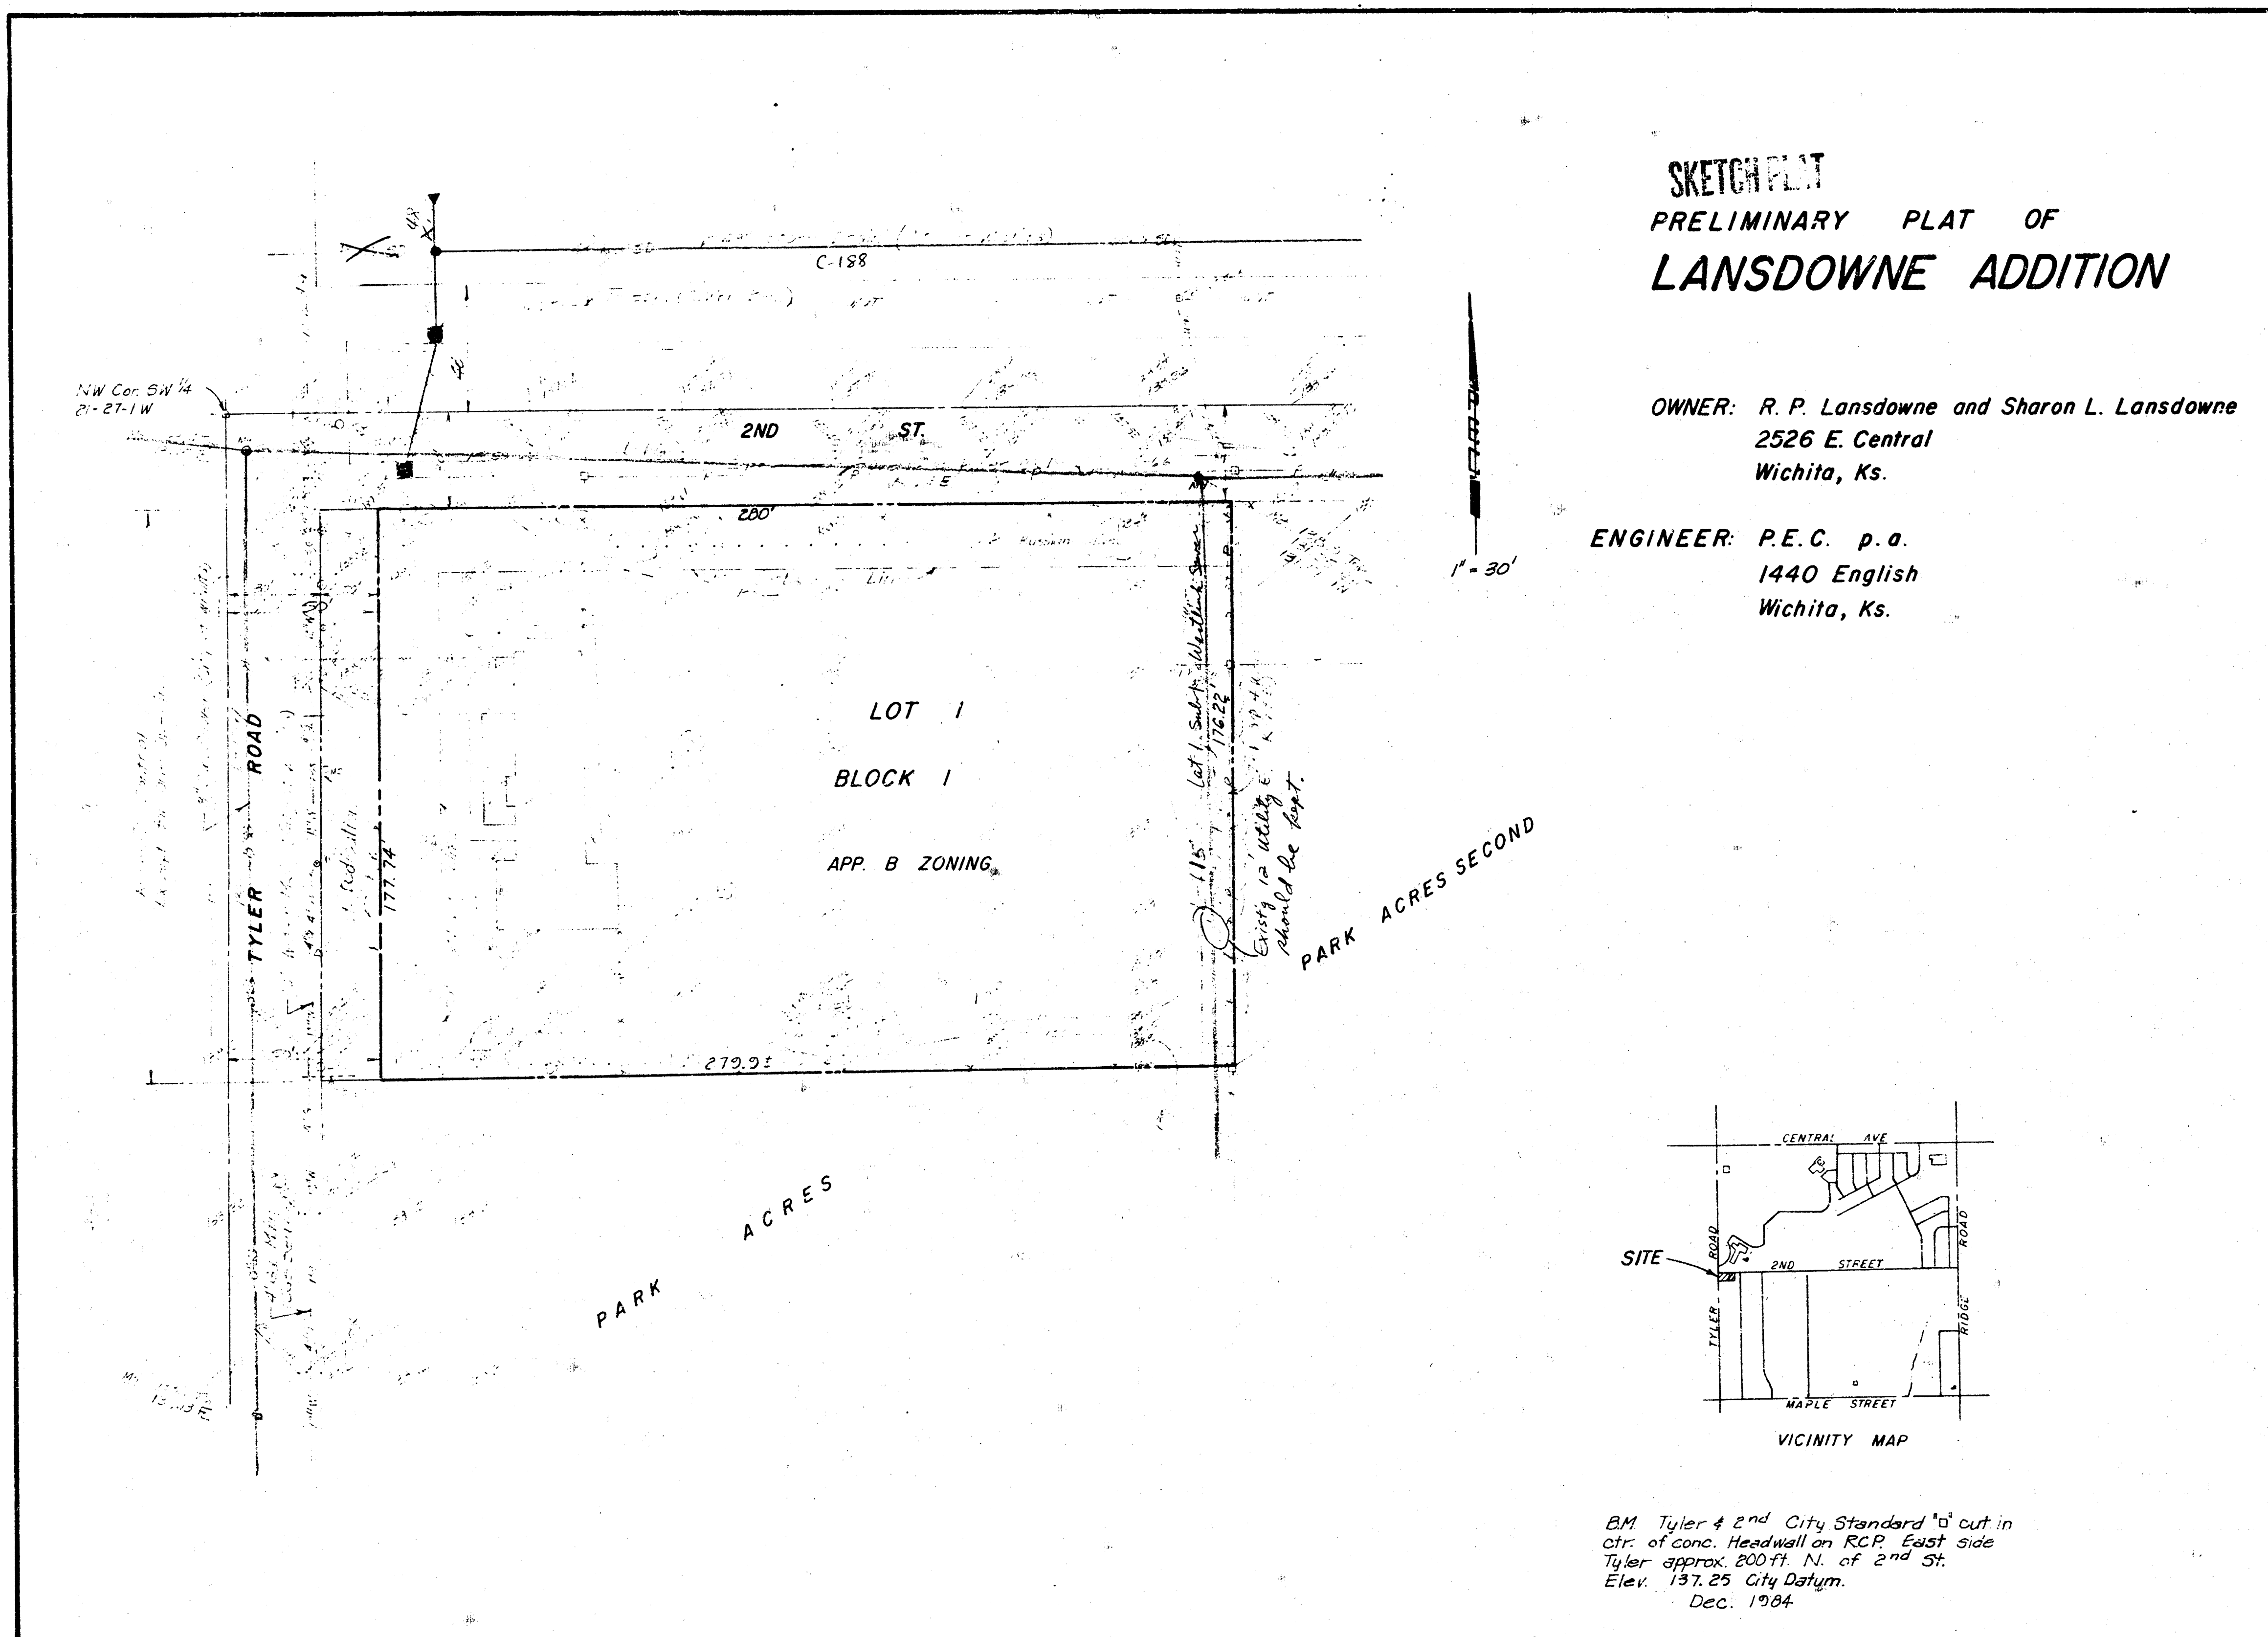

BM Tyler 4 and City Standard 10 cut in
ctr. of conc. headwall on R.O.D. East side
Tyler approx. 800 ft. N. of 2nd St.
Elev. 137.25 City Datum.
Dec. 1984