


EXISTING DRAINAGE DEDICATION FILM 414, PAGE 845

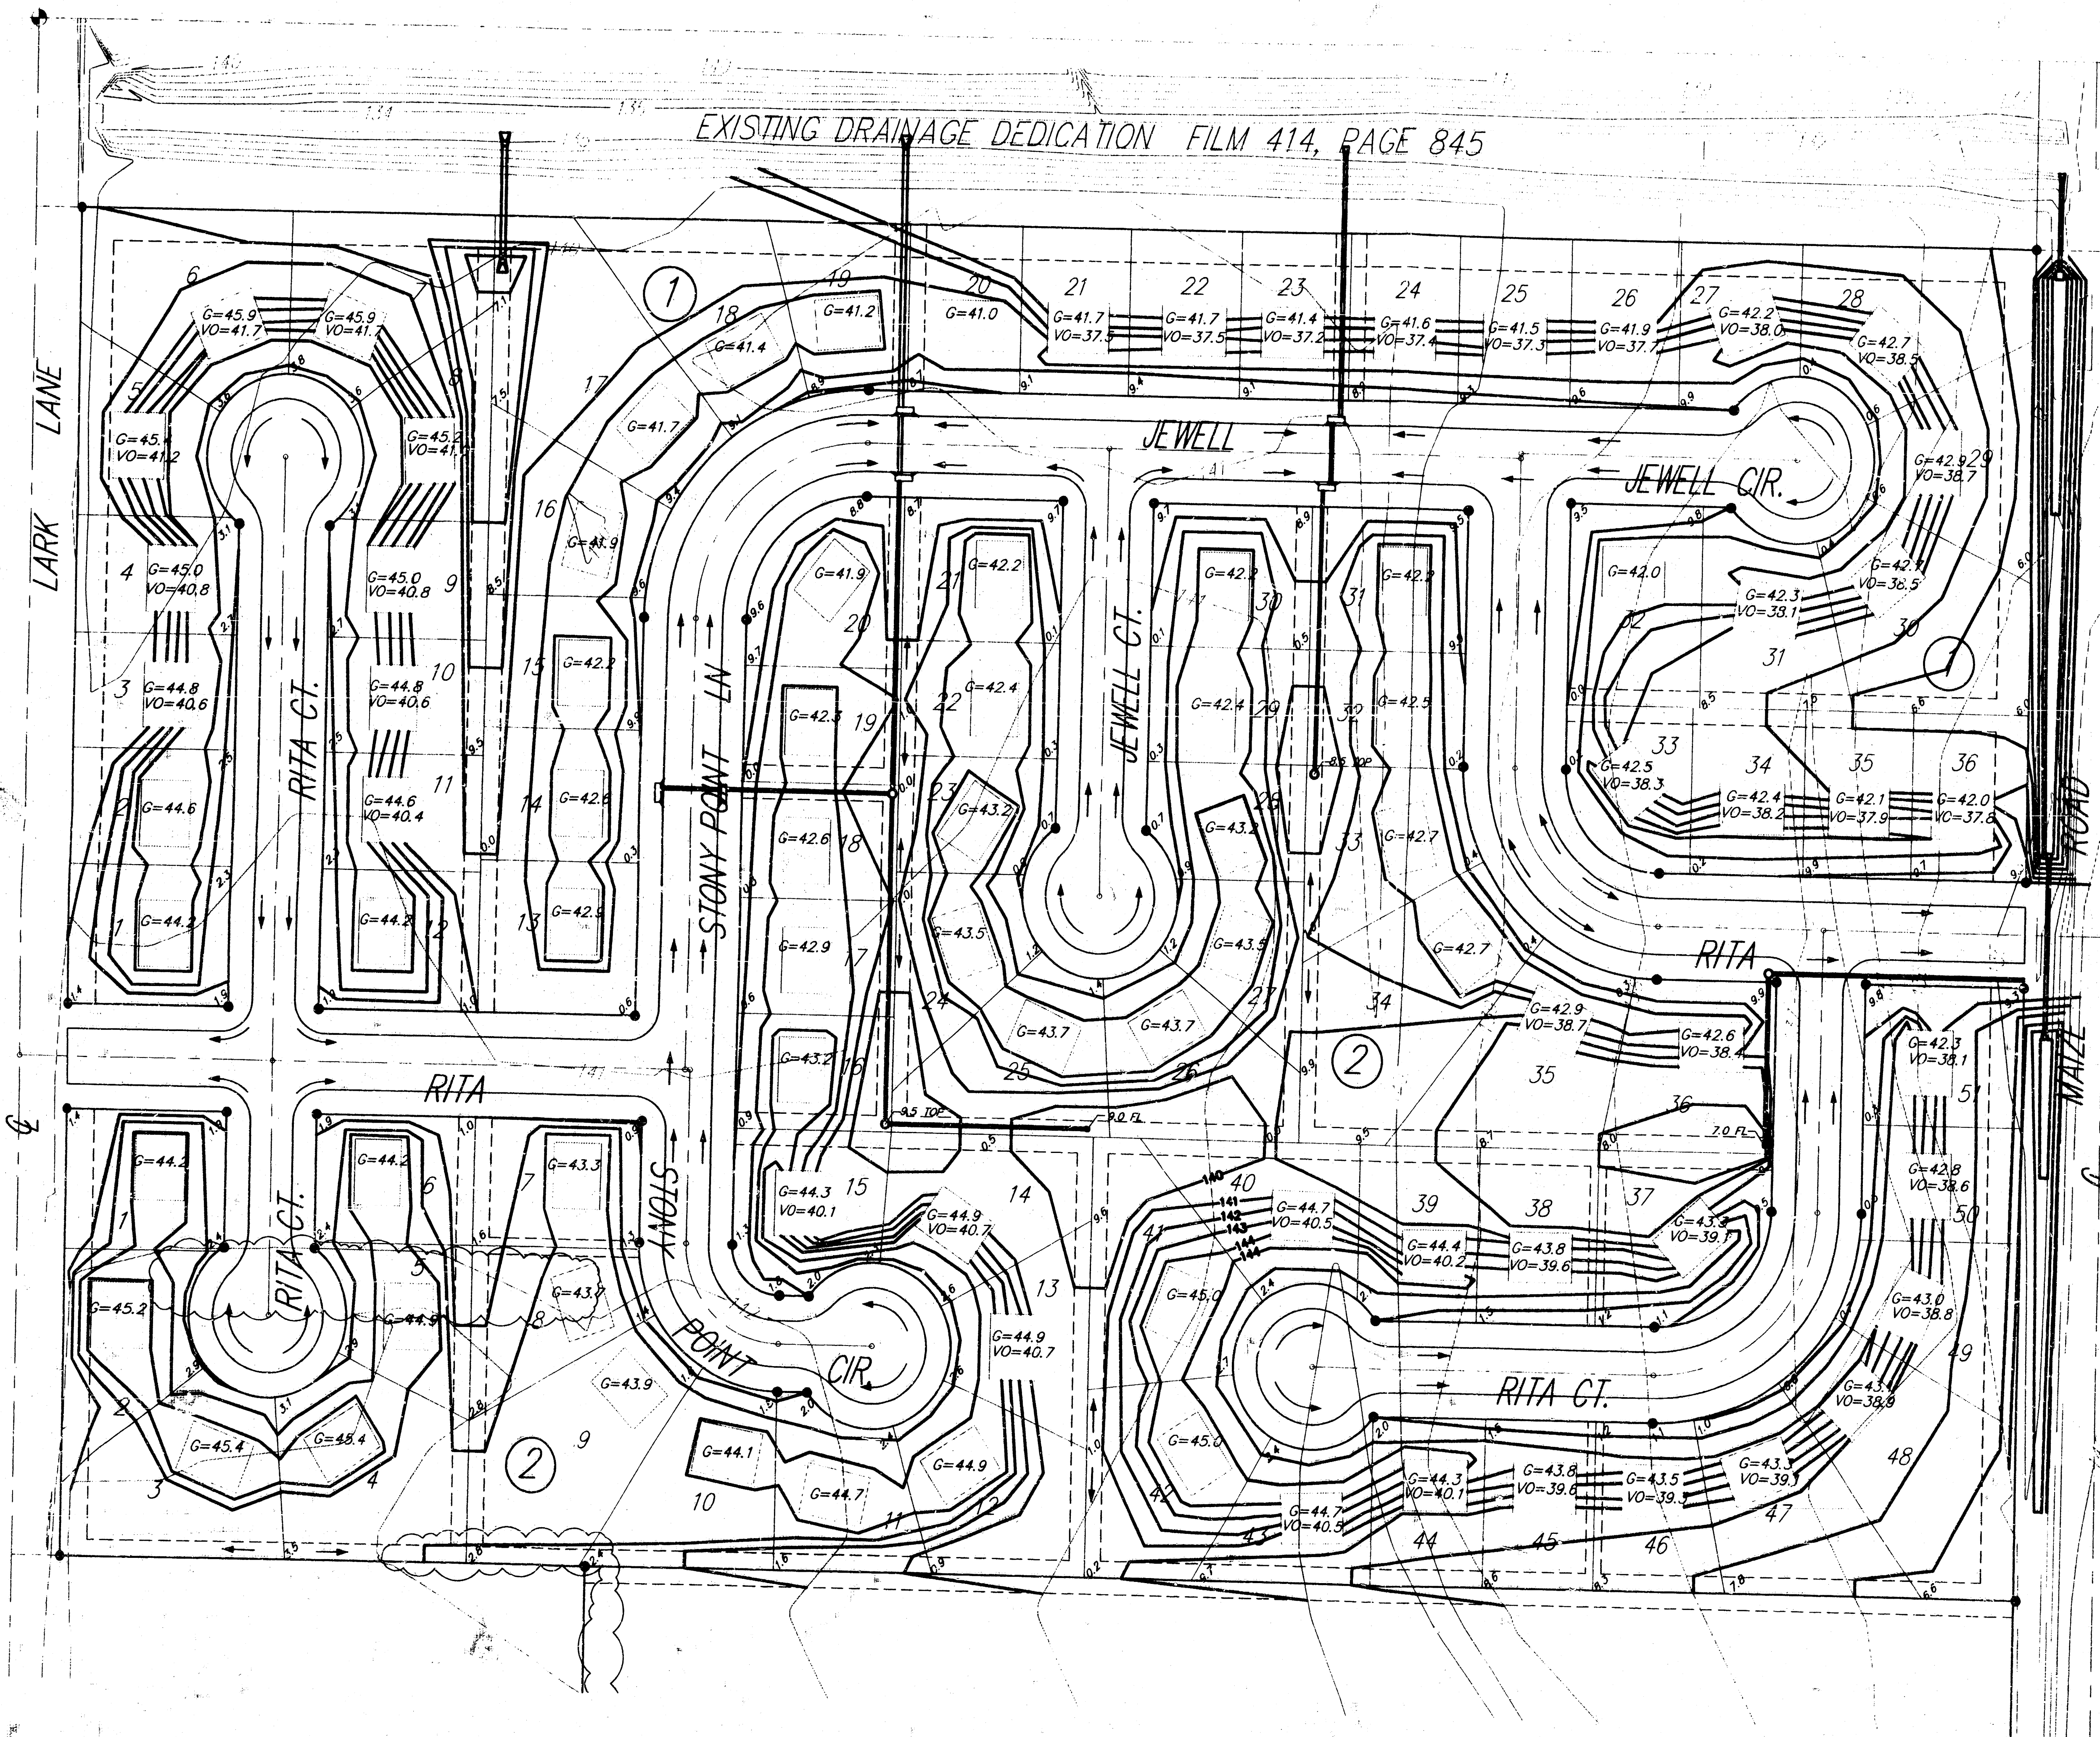

SRB

SCALE: 1" = 60'

LOT GRADING PLAN LINDSAY'S ADDITION WICHITA, KANSAS					
SRB		924 NORTH MAIN WICHITA, KANSAS 67203 http://www.fest.com/~srb		316-264-8008 FAX 264-4621 E-mail: srb@fest.com	
SAVOY, RUGGLES & BOHM, P.A. ENGINEERING & SURVEYING					
PROJECT NUMBER					
DESIGN	DRAWN	UTILITY	REVIEW	DATE	REVISED
AML	AML			JUN. 13, 1998	
					SHEET 1 OF 1