MAPCO ADDITION
(Drainage)

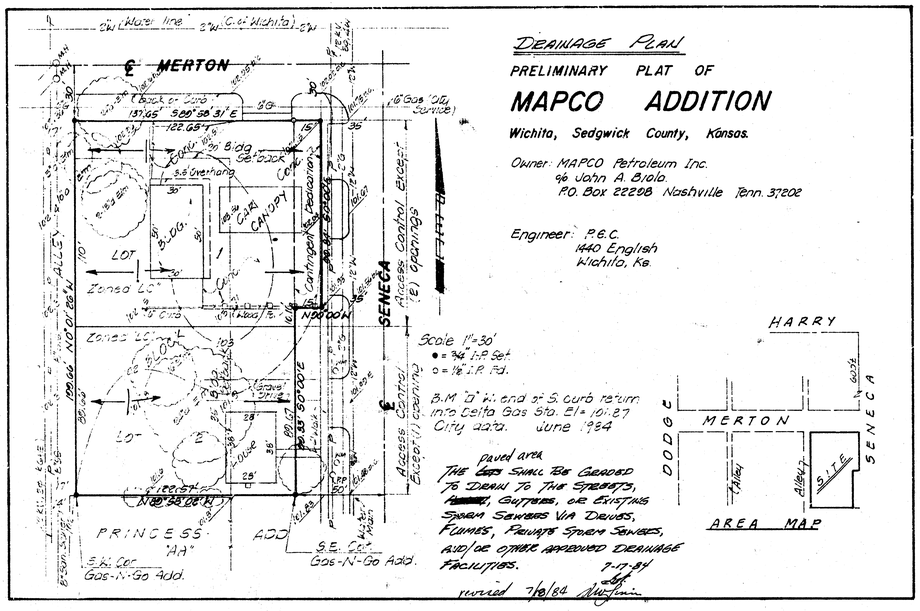
DRAINAGE PLAN
PRELIMINARY PLAT OF
MAPCO ADDITION
Wichita, Sedgwick County, Kansas.
Owner: MAPCO Petroleum Inc.
c/o John A. Biolo.
P.O. Box 2220B Nashville Tenn. 37202
Engineer: P.E.C.
1440 English
Wichita, Ks.
Scale 1"=30'
● = 3/4" I.P. Set
o = 1/2" I.P. Fd.
B.M. "D" W. end of S. curb return into Gas Sta. El= 101.27 City data. June 1984
Paved area
THE GAS SHALL BE GRADED TO DRAIN TO THE STREETS, GUTTERS, OR EXISTING STORM SEWERS VIA DRIVES, FLUMES, PRIVATE STORM SEWERS, AND/OR OTHER APPROVED DRAINAGE FACILITIES.
7-17-84
revised 7/9/84
HARRY
MERTON
DODGE
SENECA
ALLEY
SITE
AREA MAP
MERTON
SENECA
DODGE
ALLEY
LOT
Zoned "C"
Zoned "C"
Zoned "C"
Bldg. Setback
Bldg.
CANOPY
Cantilever Projection
Access Control Except (E) Openings
Access Control Except (1) opening
N00°00'W
S00°00'E
N00°38'08"E
PRINCESS "AA" ADD
S.W. Cor. Gas-N-Go Add.
S.E. Cor. Gas-N-Go Add.
N.E. Cor. Gas-N-Go Add.
S.W. Cor.
Curb
Curve
Curve
Curve
Curb
Curb
Curb