


Maple Lane 5th

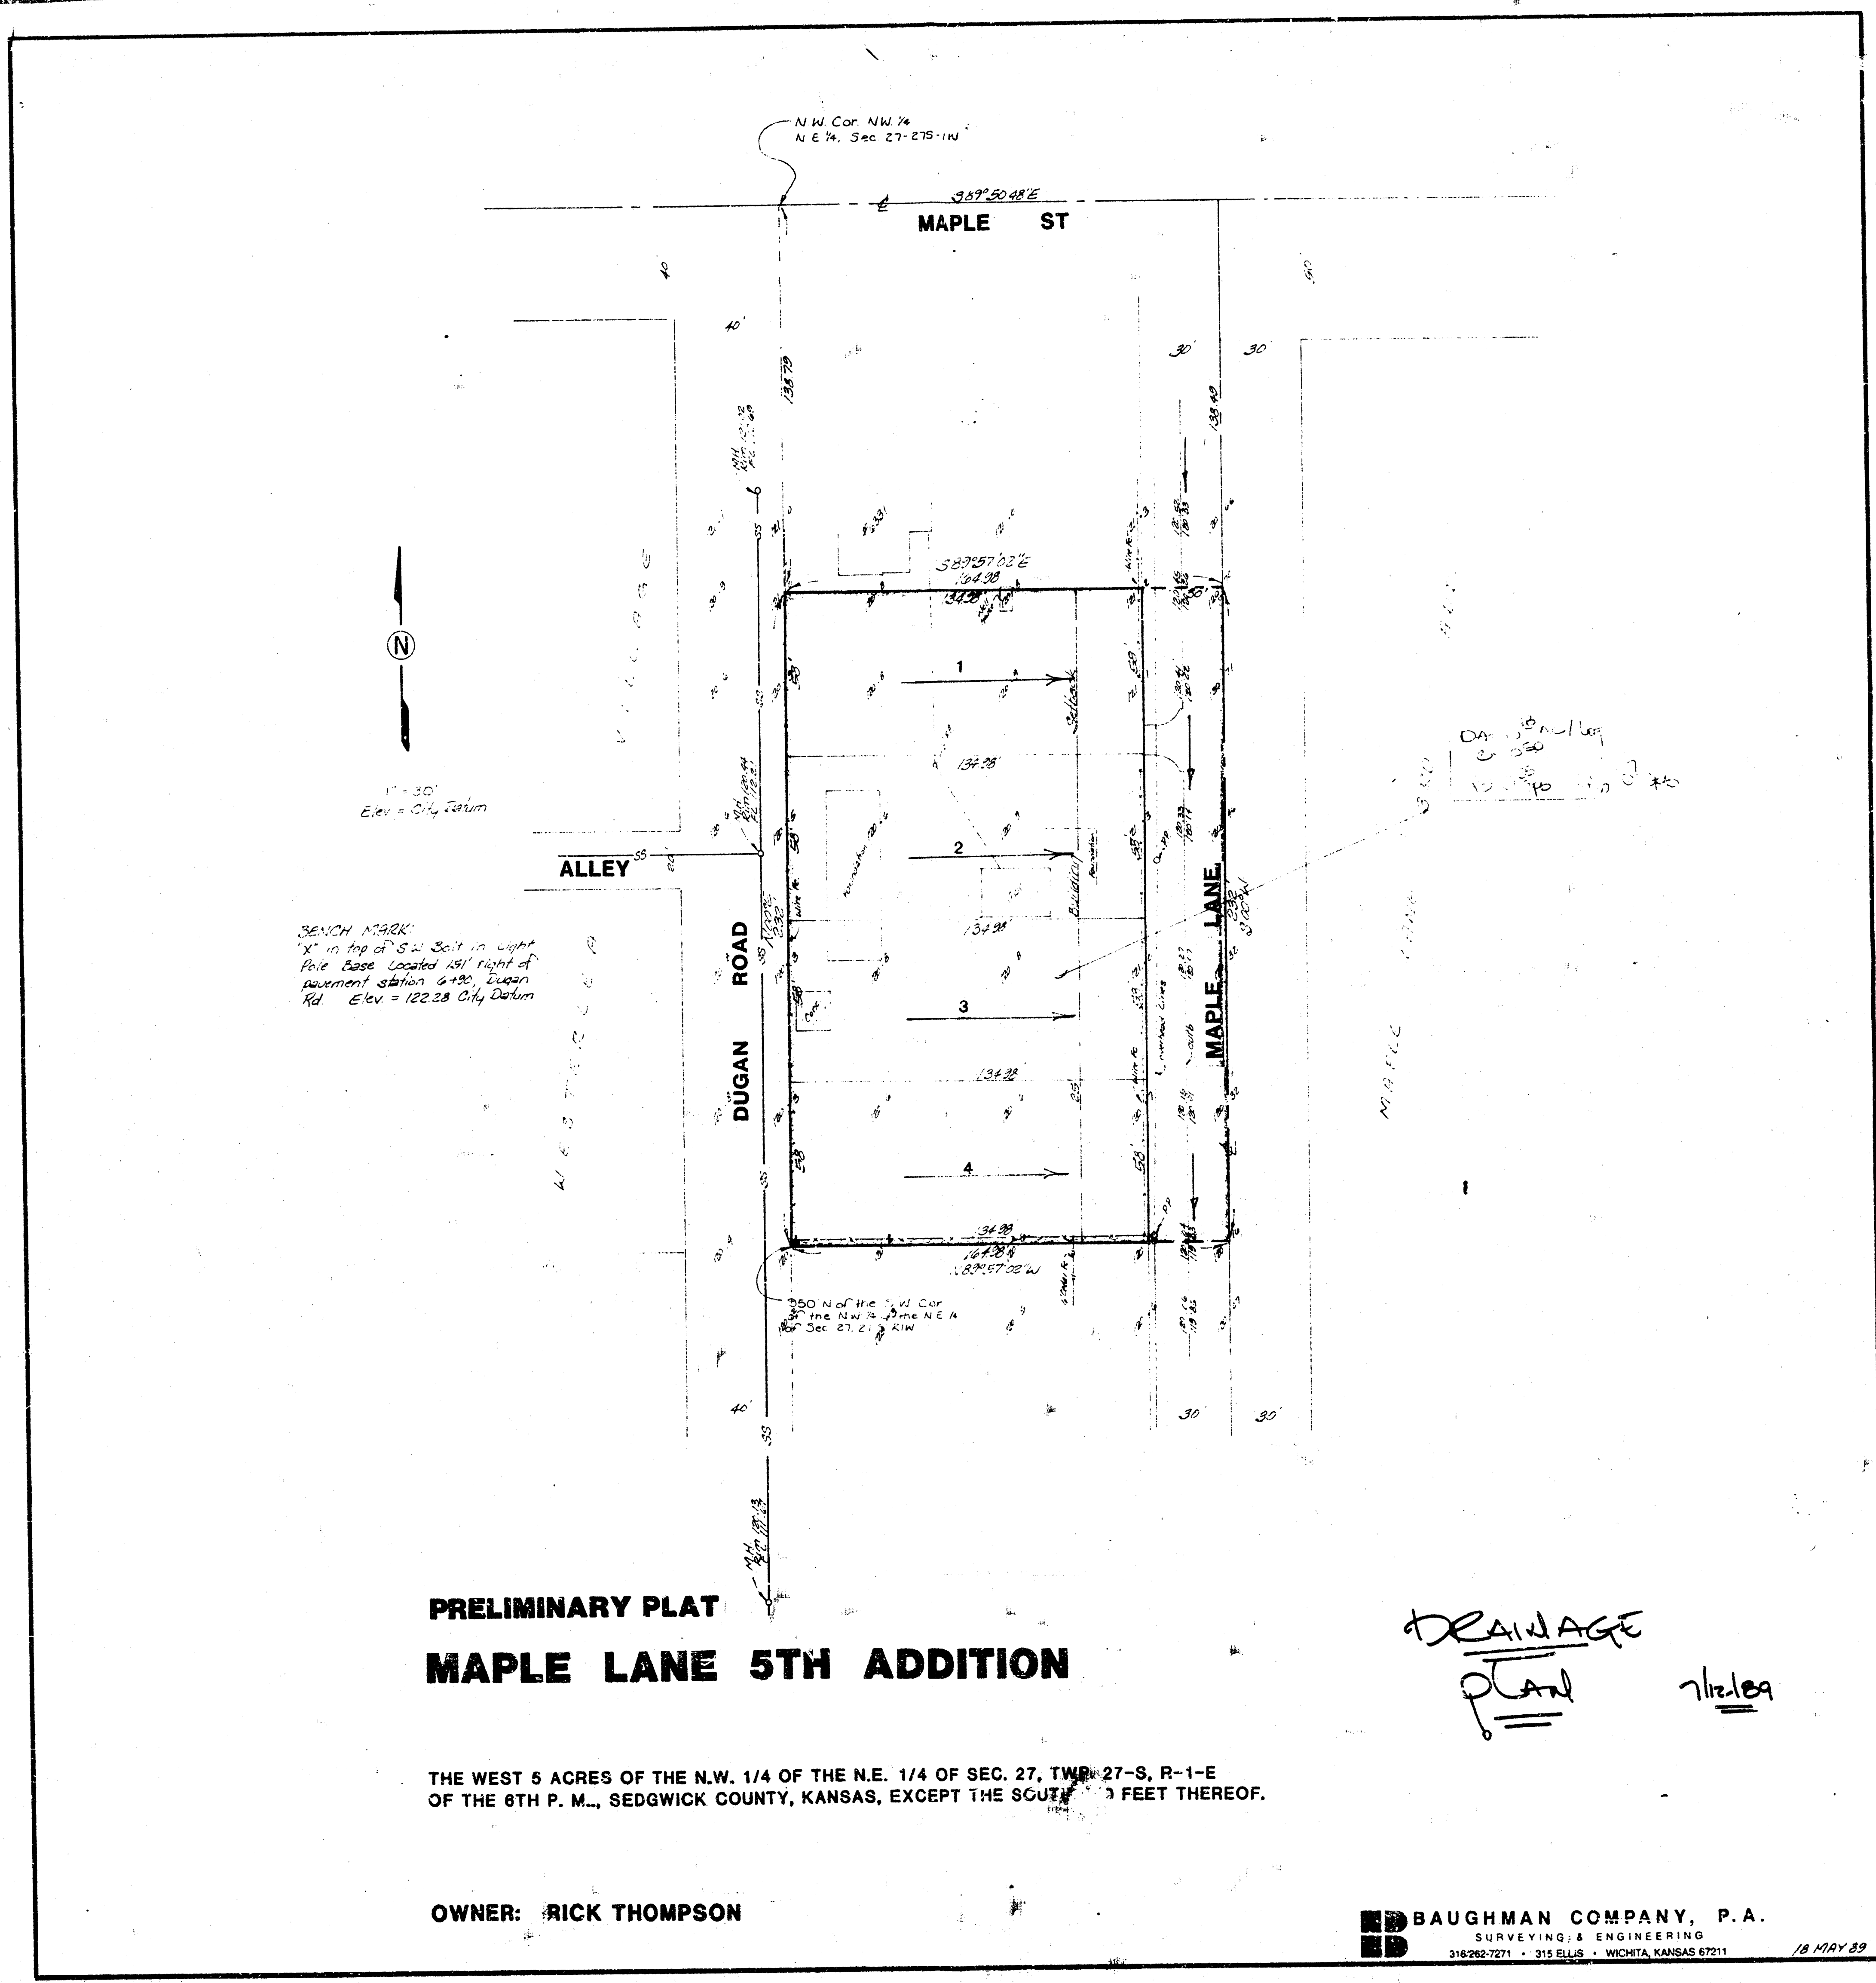

PRELIMINARY PLAT
MAPLE LANE 5TH ADDITION

THE WEST 5 ACRES OF THE N.W. 1/4 OF THE N.E. 1/4 OF SEC. 27, T.27-S., R.1-E. OF THE 6TH P. M., SEDGWICK COUNTY, KANSAS, EXCEPT THE SOUTH 3 FEET THEREOF.

OWNER: RICK THOMPSON

DRAINAGE

ED BAUGHMAN COMPANY, P.A.
SURVEYING & ENGINEERING
