


5-27-95

MEADOW DARS - DRAINAGE PLAN

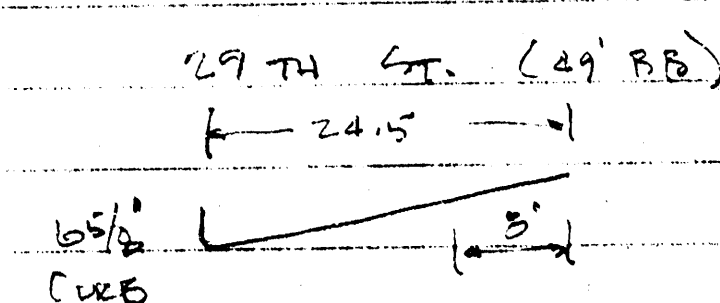

6.2' DEPTH = 10% SLOPE (ONE 9' LAKE OPEN)

STREET GRADE = 0.16% @ 6.2' DEPTH = 1.30 cfs

RESTRICT OUTFLOW FROM LOT 1 BLOCK 1 TO 6.50

SOIL GROUP D

MEADOW GOOD CONDITION CN = 75 PRESENT
COMM. BUSINESS CN = 95 FUTURE

6" 100% FILLER 5.9" USE 6.0"

RUNOFF 5.58 PRESENT


5.91 FUTURE

1.33 DIFFERENCE

$5.5 \times 43500 \times 1.33 \div 12 = 25000$ C.F. STORAGE

100 x 392 3' DEEP

USE WEIR OR PIPE TO CONTROL OUTFLOW

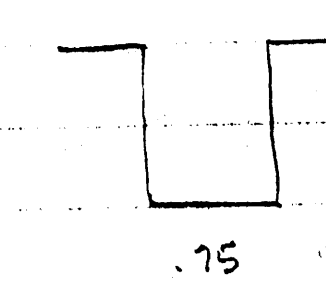

$Q = CLH^{3/2}$ $C = 3.0$

$H = 1$ $Q = 2.30 cfs$

$H = 1.5$ $Q = 4.1 cfs$

$H = 2$ $Q = 6.4 cfs$

12" RCP UNIT CONTROL 2.2' HD @ 6.0 cfs

ON LOT 1 BLOCK 1

PROVIDE 5500 C.F. OF STORAGE WITH A 12" RCP DISCHARGE PIPE OR A 9" WIDE BRICK OPEN WEIR TO CONTROL OUTFLOW. MAXIMUM DEPTH OF POURING TO BE 24" OR SUBMIT ALTERNATE STORM WATER DETENTION PLAN TO REDUCE Q TO FLOW TO 6.0 cfs.

**APPROVED
DRAINAGE PLAN**

LOT GRADING PLAN MEADOW OAKS ADDITION

TO WICHITA, SEDGWICK COUNTY, KANSAS

DATE: 7-19-93

GENERAL NOTES:

1. Pad Site elevations are at ground level. The top of foundation is 18" to 24" above the ground elevation shown.
2. Pad Site elevations are 42" above the top of the street curbs at the center of the lot.
3. The rear of all lots slope at 2 inches in 10 feet minimum.
4. The top of rear foundation walls for view out basements are 2.5 to 3.5 feet below the pad site elevation.


BENCHMARKS:

BM# 1
City of Wichita Bench Mark Disc, 5.5' E. and 37' N.
of N1/4 Corner Sec. 1-27-1E
Elev. 172.38

BM# 2
NW Corner Concrete Outter on Beacon Hill Road Median
at 29th Street North
Slev. 162.99
(City of Wichita Datum)

Minimum Building Elevations		
Lot No.	Block No.	Minimum Low Opening
70-71	2	173.0
72-73	2	172.0
74-75	2	171.0
76-77	2	170.0
78-81	2	169.0
82-83	2	168.0
Lot No.	Block No.	Minimum Low Floor
92-95	2	163.6
97-102	2	163.6
111-114	2	163.6
1	4	163.5


(Elevations are to City of Wichita Datum)

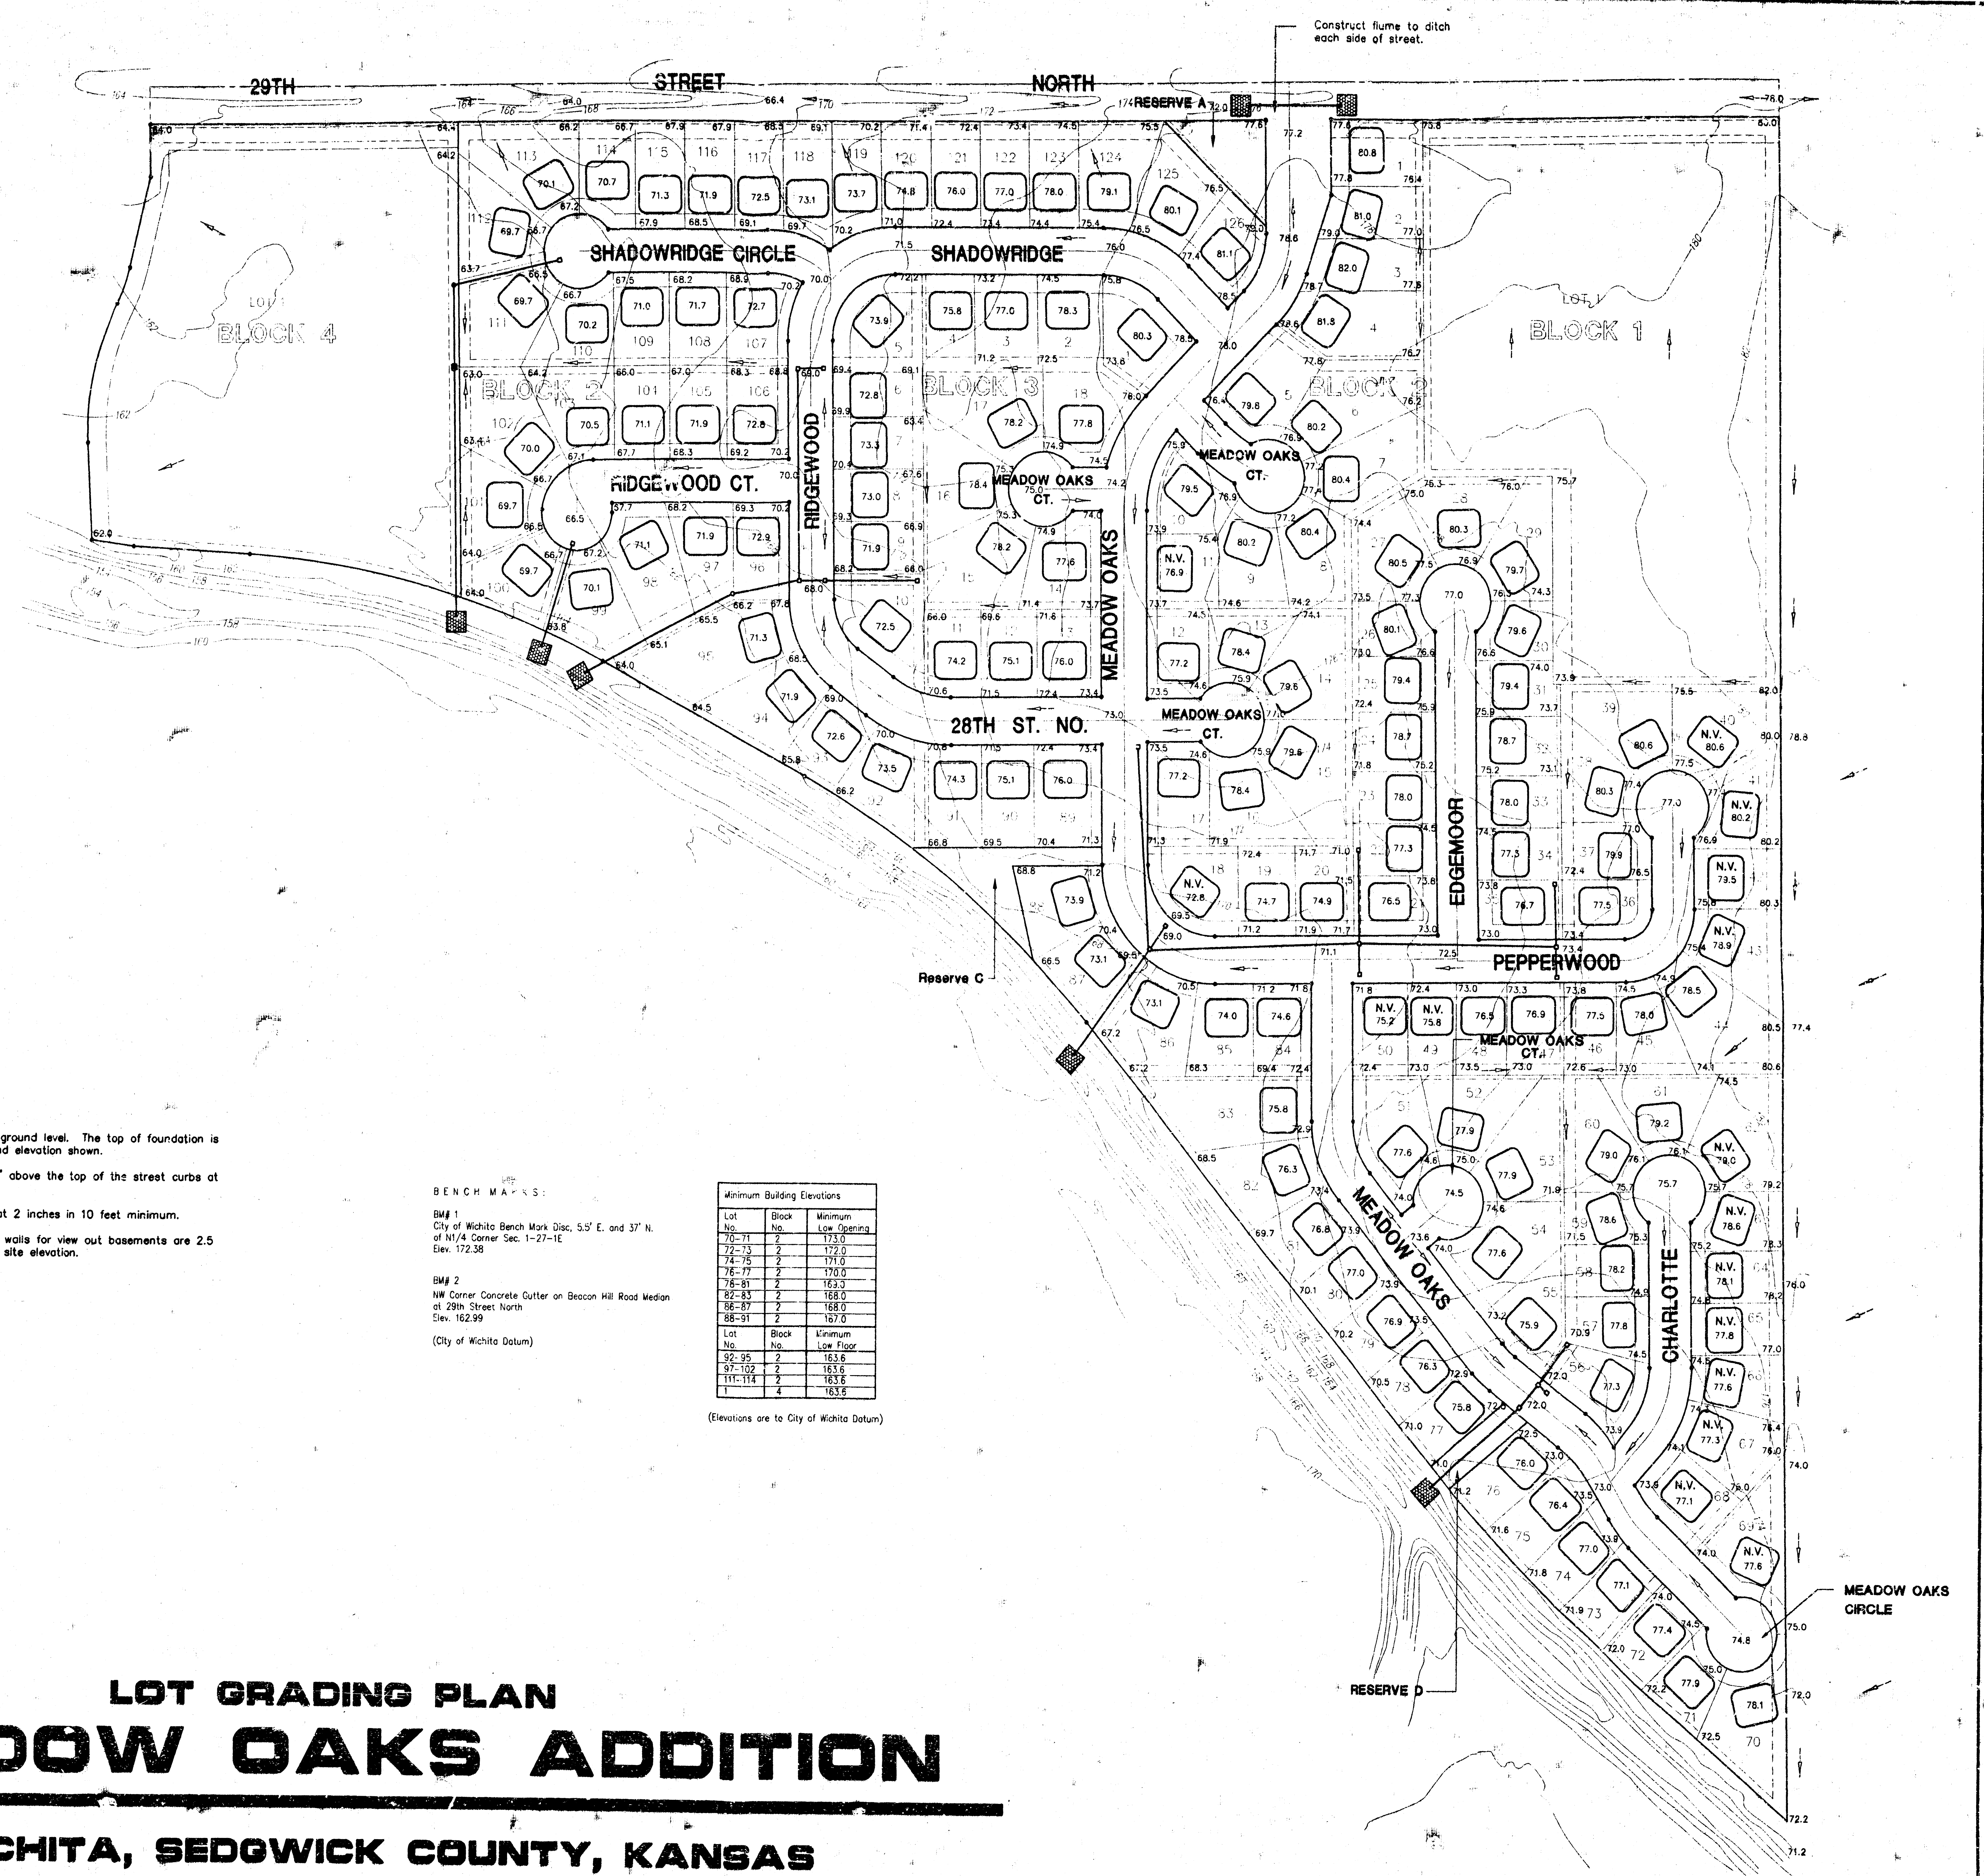

GENERAL NOTES:

1. Drainage from the adjacent property to the East must be diverted South at the East property line of Meadow Oaks.
2. The design of "V" Swales are based on a slope of .004, 10:1 slopes and an "N" value of .030.
3. Runoff calculations are based on a 15 min. minimum time of concentration, a "C" value of 0.5 for residential and 0.8 for commercial. The corresponding "I" values are 3.83, 4.56, 7.37 for 2, 5 and 100 year storms.

LINE NO. 1					
Location	Q	Pipe	2YR. Bypass	100YR. Bypass	Comments
1-2	4.4	15"	-	4.1	MI at Point No. 2
2-3	4.4	15"	-	11.5	End Section w/ Rip-Rap @ Pt. 3
LINE NO. 1					
Location	Q	Surface Drainage	Depth	Width	Comments
1-2	4.1	"V" Swale	0.5	12"	100 Yr. Storm
2-2	11.5	"V" Swale	0.82	16.5'	100 Yr. Storm
LINE NO. 2					
Location	Q	Pipe	2YR. Bypass	100YR. Bypass	Comments
1-2	3.8	15"	-	3.6	End Section w/ Rip-Rap @ Pt. 2
LINE NO. 2					
Location	Q	Surface Drainage	Depth	Width	Comments
1-2	3.6	"V" Swale	0.5	10"	100 Yr. Storm
LINE NO. 3					
Location	Q	Pipe	2YR. Bypass	100YR. Bypass	Comments
1-2	7.4	18"	-	-	Quin Pipe
2-3	11.9	24"	-	-	-
3A-3B	3.5	15"	-	-	-
3B-3	6.5	18"	-	6.0	Bypass overflows down rear lot line @ 3B
3-4	32.7	36"	-	-	Quin Pipe
4-5	32.7	36"	-	-	End Section w/ Rip-Rap @ Pt. 5
LINE NO. 4					
Location	Q	Pipe	2YR. Bypass	100YR. Bypass	Comments
1-2	12.4	24"	-	7.7	Drop Inlet @ Pt. 1
2A-2	2.1	15"	-	-	-
2-3	16.6	24"	-	-	-
3A-3	2.0	15"	-	-	-
3B-3	5.7	18"	-	5.4	Drop Inlets @ Pt. 3B
3-4	29.8	36"	-	-	-
4A-4	3.8	15"	-	-	-
4B-4	4.0	15"	-	-	-
4-5	38.8	42"	-	32.2	End Section w/ Rip-Rap @ Pt. 5
LINE NO. 4					
Location	Q	Surface Drainage	Depth	Width	Comments
1-2	7.7	"V" Swale	0.7	14"	100 Yr. Bypass
3B-3	5.4	"V" Swale	0.6	12"	100 Yr. Bypass
4-5	32.2	"V" Swale	1.20	24.2'	100 Yr. Bypass
LINE NO. 5					
Location	Q	Pipe	2YR. Bypass	100YR. Bypass	Comments
1-2	5.0	18"	-	4.6	Drop Inlet @ Pt. 1
2-3	13.2	24"	-	-	Obi. Inlet @ Pt. 2
3-4	16.3	30"	-	15.1	End Section w/ Rip-Rap @ Pt. 4
LINE NO. 5					
Location	Q	Surface Drainage	Depth	Width	Comments
1-2	4.6	"V" Swale	0.6	12"	100 Yr. Bypass
3-4	15.1	"V" Swale	0.9	18"	100 Yr. Bypass
LINE NO. 6					
Location	Q	Pipe	2YR. Bypass	100YR. Bypass	Comments
1-2	10.0	24"	-	3.7	End Section w/ Rip-Rap @ Pt. 1 & 2

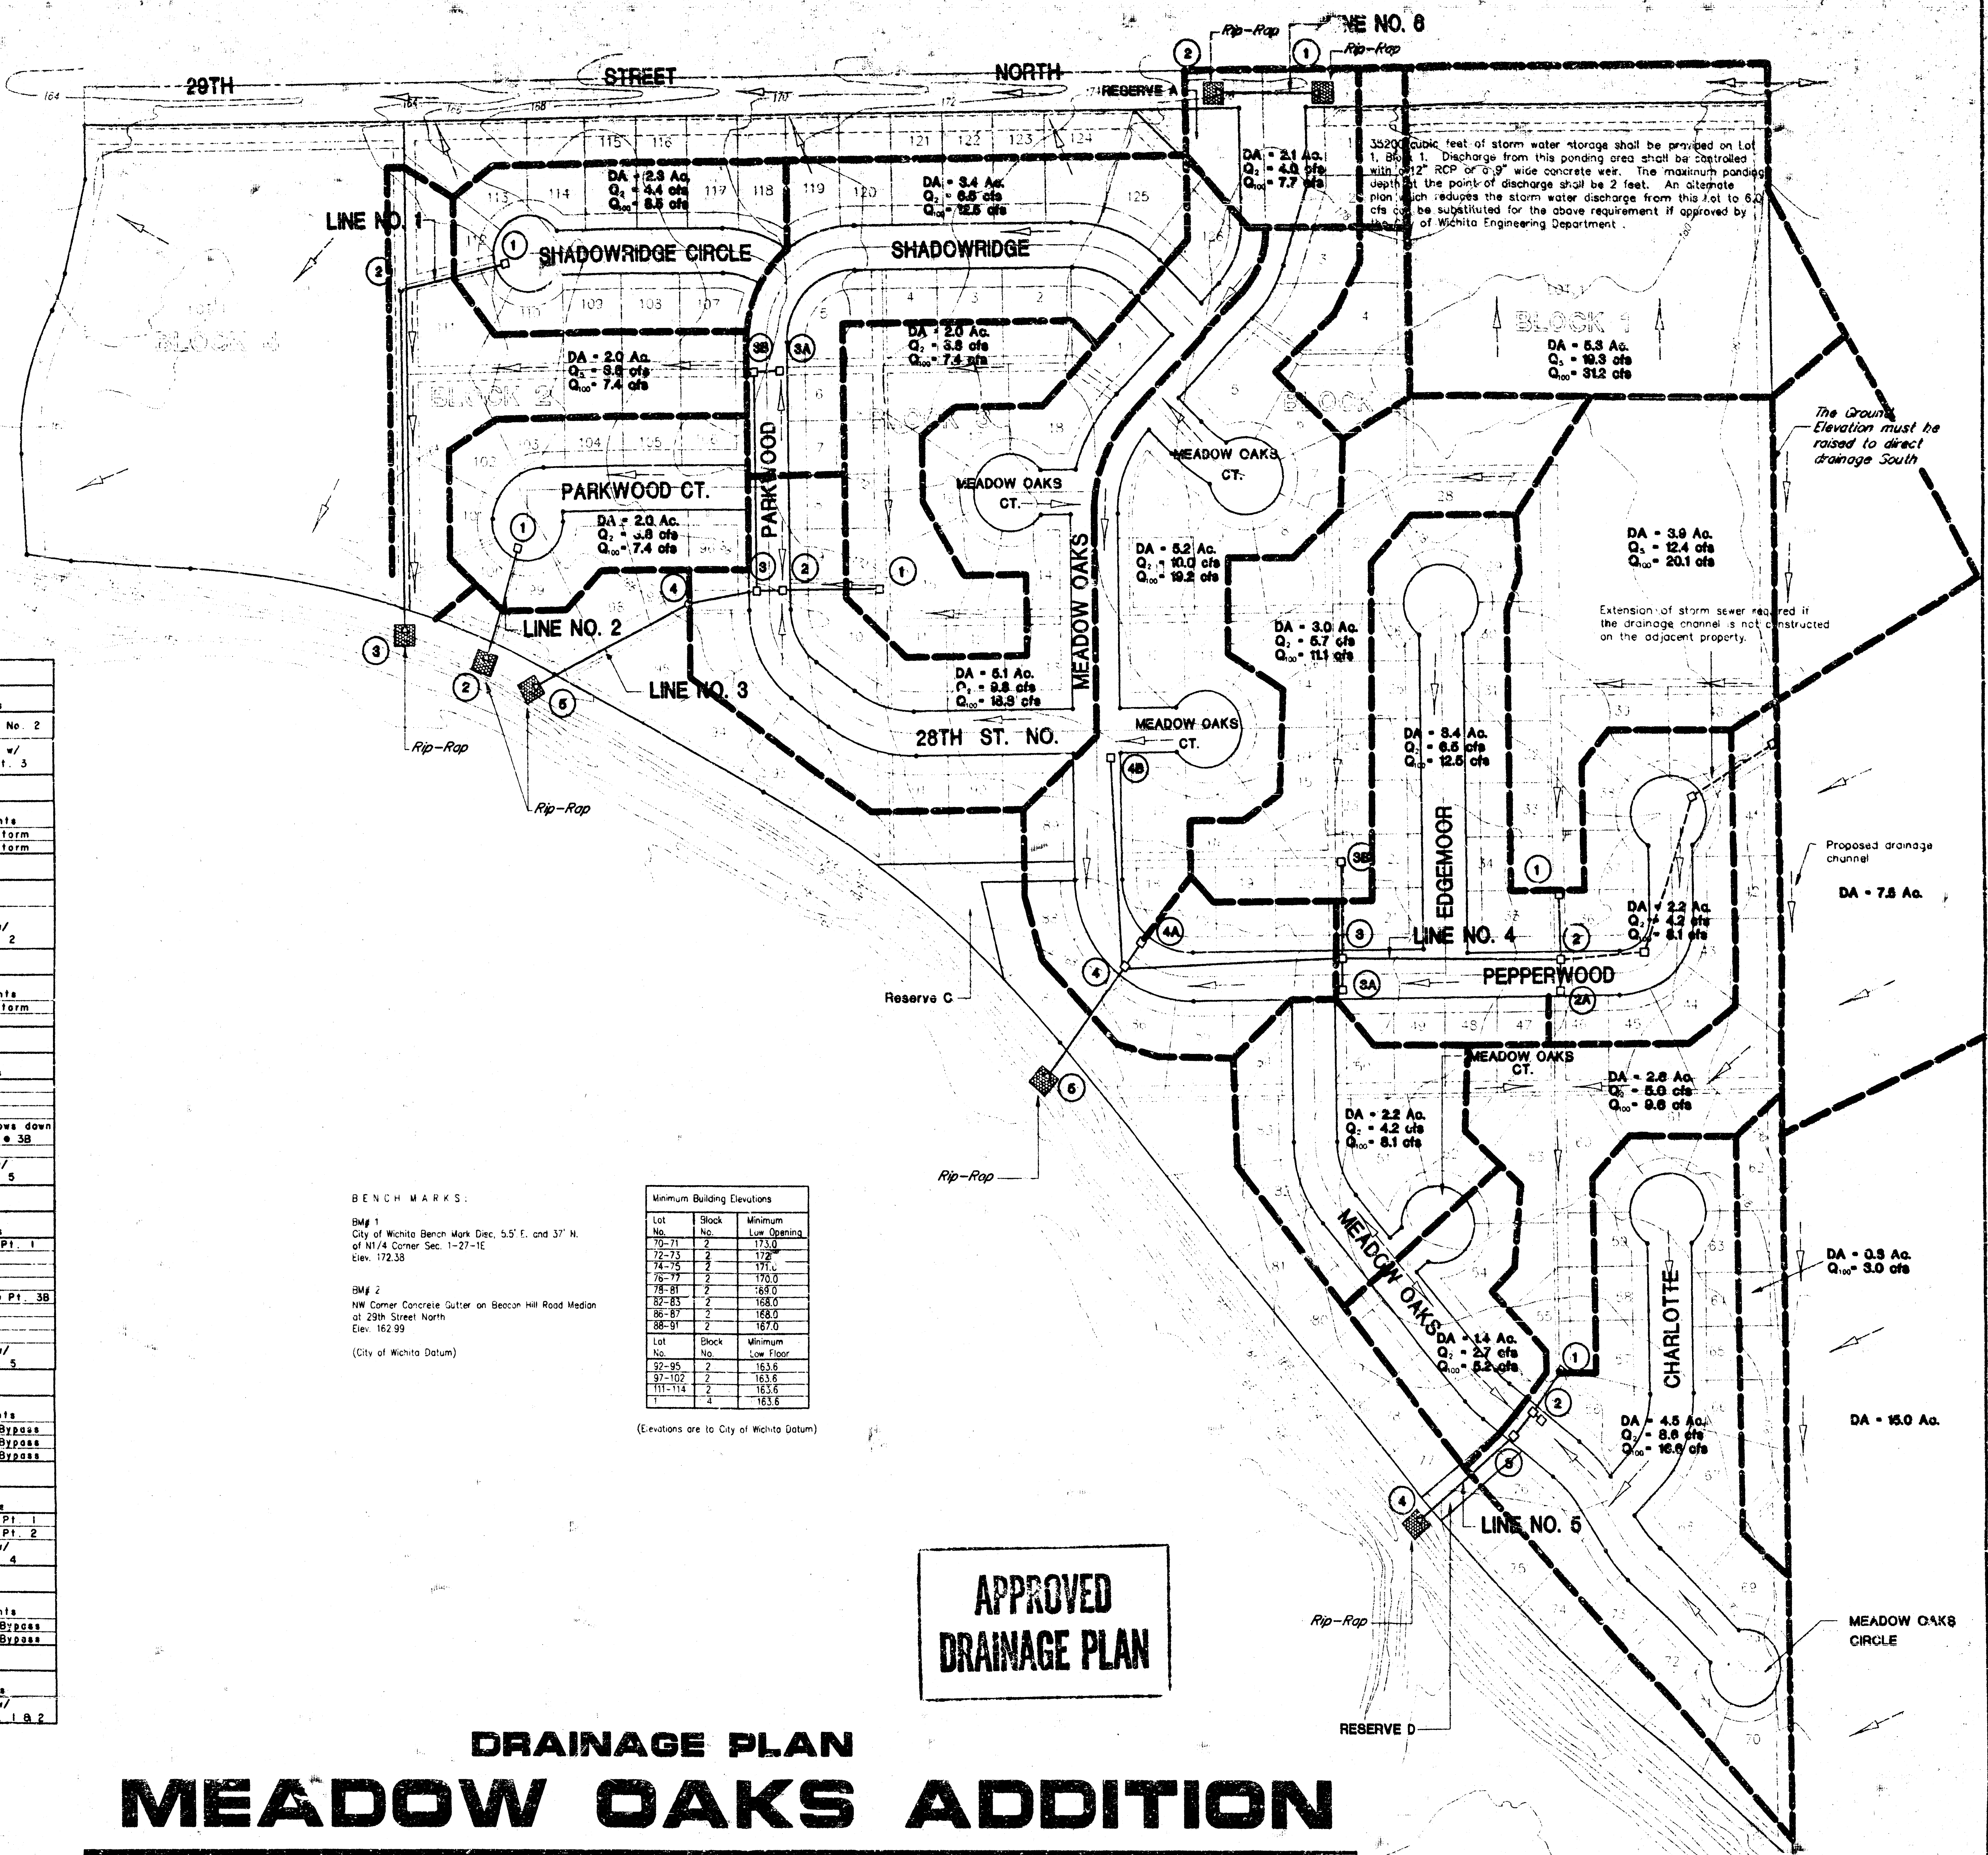

BENCH MARKS:

BM 1
City of Wichita Bench Mark Dec. 5.5' E. and 37' N.
of M/4 Corner Sec. 1-27-1E
Elev. 172.38

BM 2
NW Corner Concrete Gutter on Beacon Hill Road Median
at 29th Street North
Elev. 162.99
(City of Wichita Datum)

Minimum Building Elevations		
Lot No.	Block No.	Minimum Low Opening
70-71	2	173.0
72-73	2	172.8
74-75	2	171.6
76-77	2	170.0
78-81	2	168.0
82-83	2	168.0
86-87	2	168.0
88-91	2	167.0
Lot No.	Block No.	Minimum Low Floor
92-95	2	163.6
97-102	2	163.6
111-114	2	163.6
1	4	163.6

(Elevations are to City of Wichita Datum)

**APPROVED
DRAINAGE PLAN**

DRAINAGE PLAN MEADOW OAKS ADDITION

TO WICHITA, SEDGWICK COUNTY, KANSAS

DATE: 6-1-93