


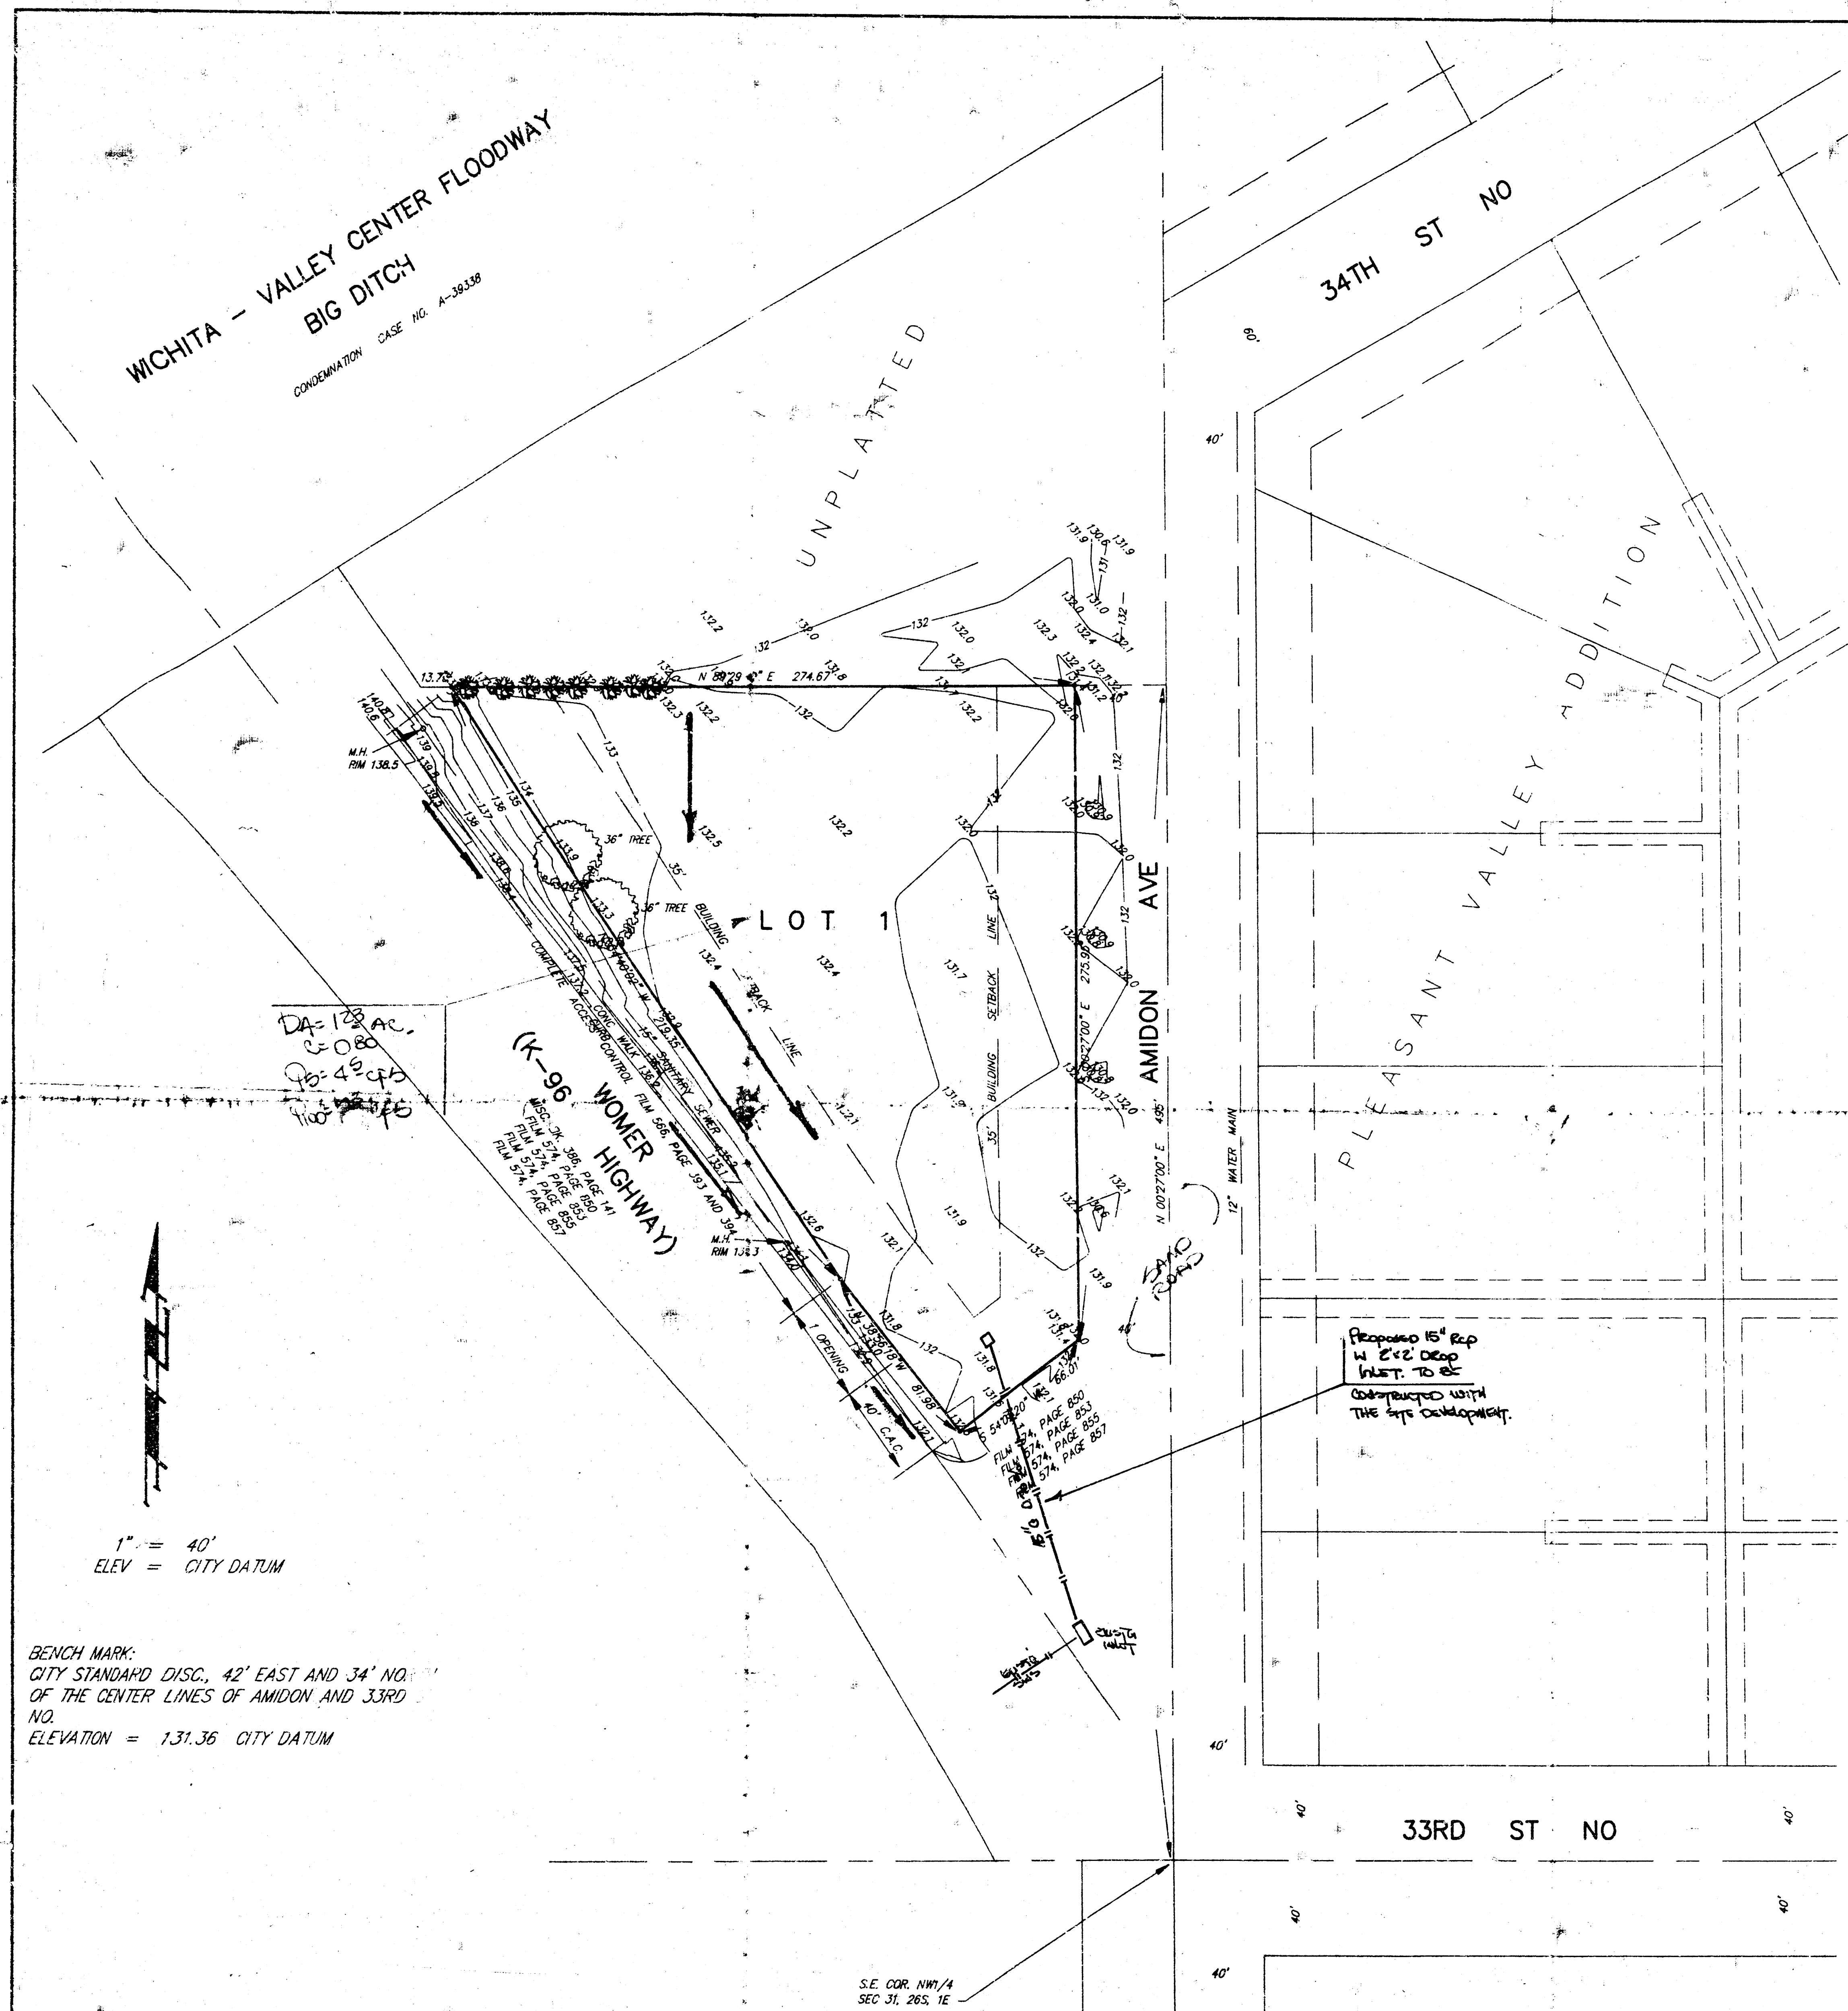

SKETCH PLAT
**NORTH AMIDON
 MEDICAL CENTER
 ADDITION**
 WICHITA, SEDGWICK COUNTY, KANSAS

LEGAL DESCRIPTION:
 The north 363 feet of the south 495 feet of the east 630 feet of the SE1/4 of the NW1/4 of Sec. 31, Twp. 26-S, R-1-E of the 6th P.M., Sedgewick County, Kansas, except that portion lying south and west of the easterly right-of-way line of K-96 Highway (Misc. Bk. 386, Page 141) and except the east 40 feet for road right-of-way and except those portions added for K-96 Highway right-of-way on Film 574, Page 850, Film 574, Page 853, Film 574, Page 855, and Film 574, Page 857.

Containing 51,440 Sq. Ft.
 1.2 Acres

LEOTA ZICKFOOD, PAZIER
 3400 N. CHARLES
 WICHITA, KS 67214

DAVID M. WALL AND MAUREEN P. ROOS
 % JOHN F. REAGAN
 250 N. WATER, S. 17, 215
 WICHITA, KS 67214-180

BENCH MARK:
 CITY STANDARD DISC., 42' EAST AND 34' NORTH
 OF THE CENTER LINES OF AMIDON AND 33RD
 NO.
 ELEVATION = 131.36 CITY DATUM

Drainage Plan