


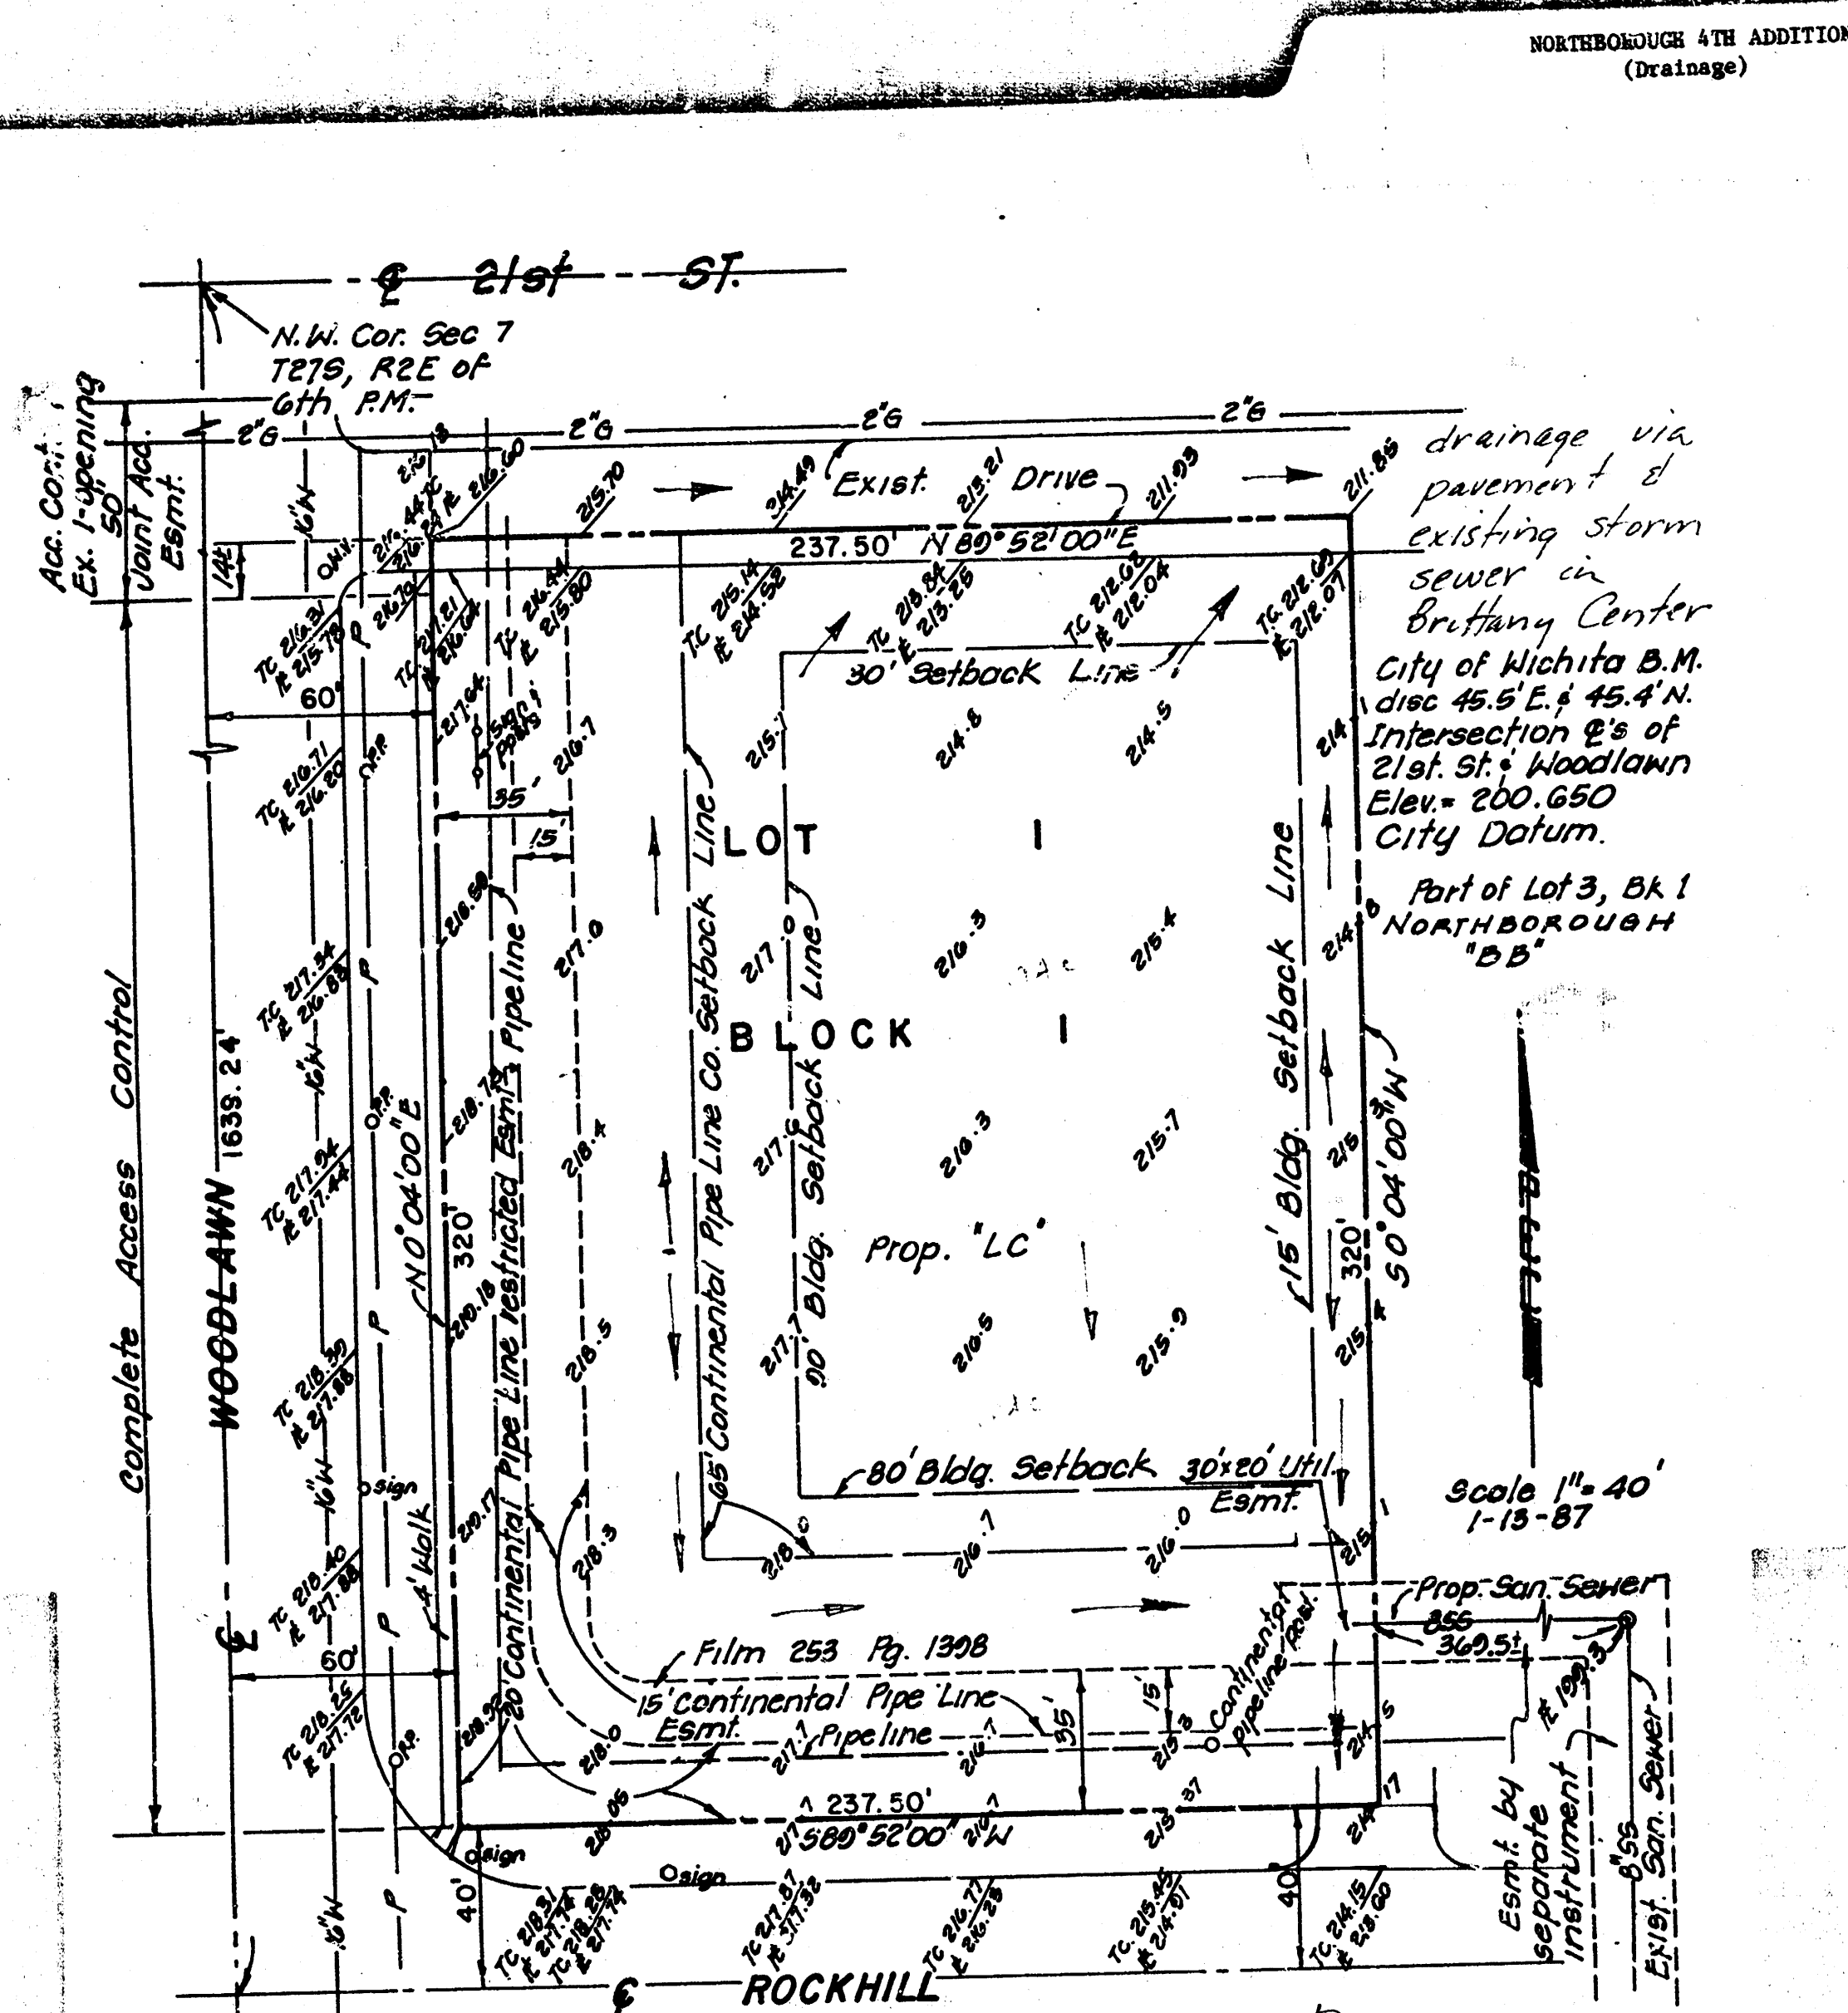

SKETCH PLAT OF *Drainage Plan*
NORTHBOROUGH 4th ADDITION
 Wichita, Sedgwick County, Kansas.

OWNER: BRITTANY DEVELOPMENTS COMPANY
 C/O Richard Boushka
 500 Fourth Financial Center
 Wichita, Ks. 67202

ENGINEER: P.E.C. P.O.
 1440 English
 Wichita, Ks. 67211

*This lot shall be
 graded to drain via
 pavement, drives, and
 the existing storm sewer
 system.*

*Does joint loc. Easement allow
 for drainage?*