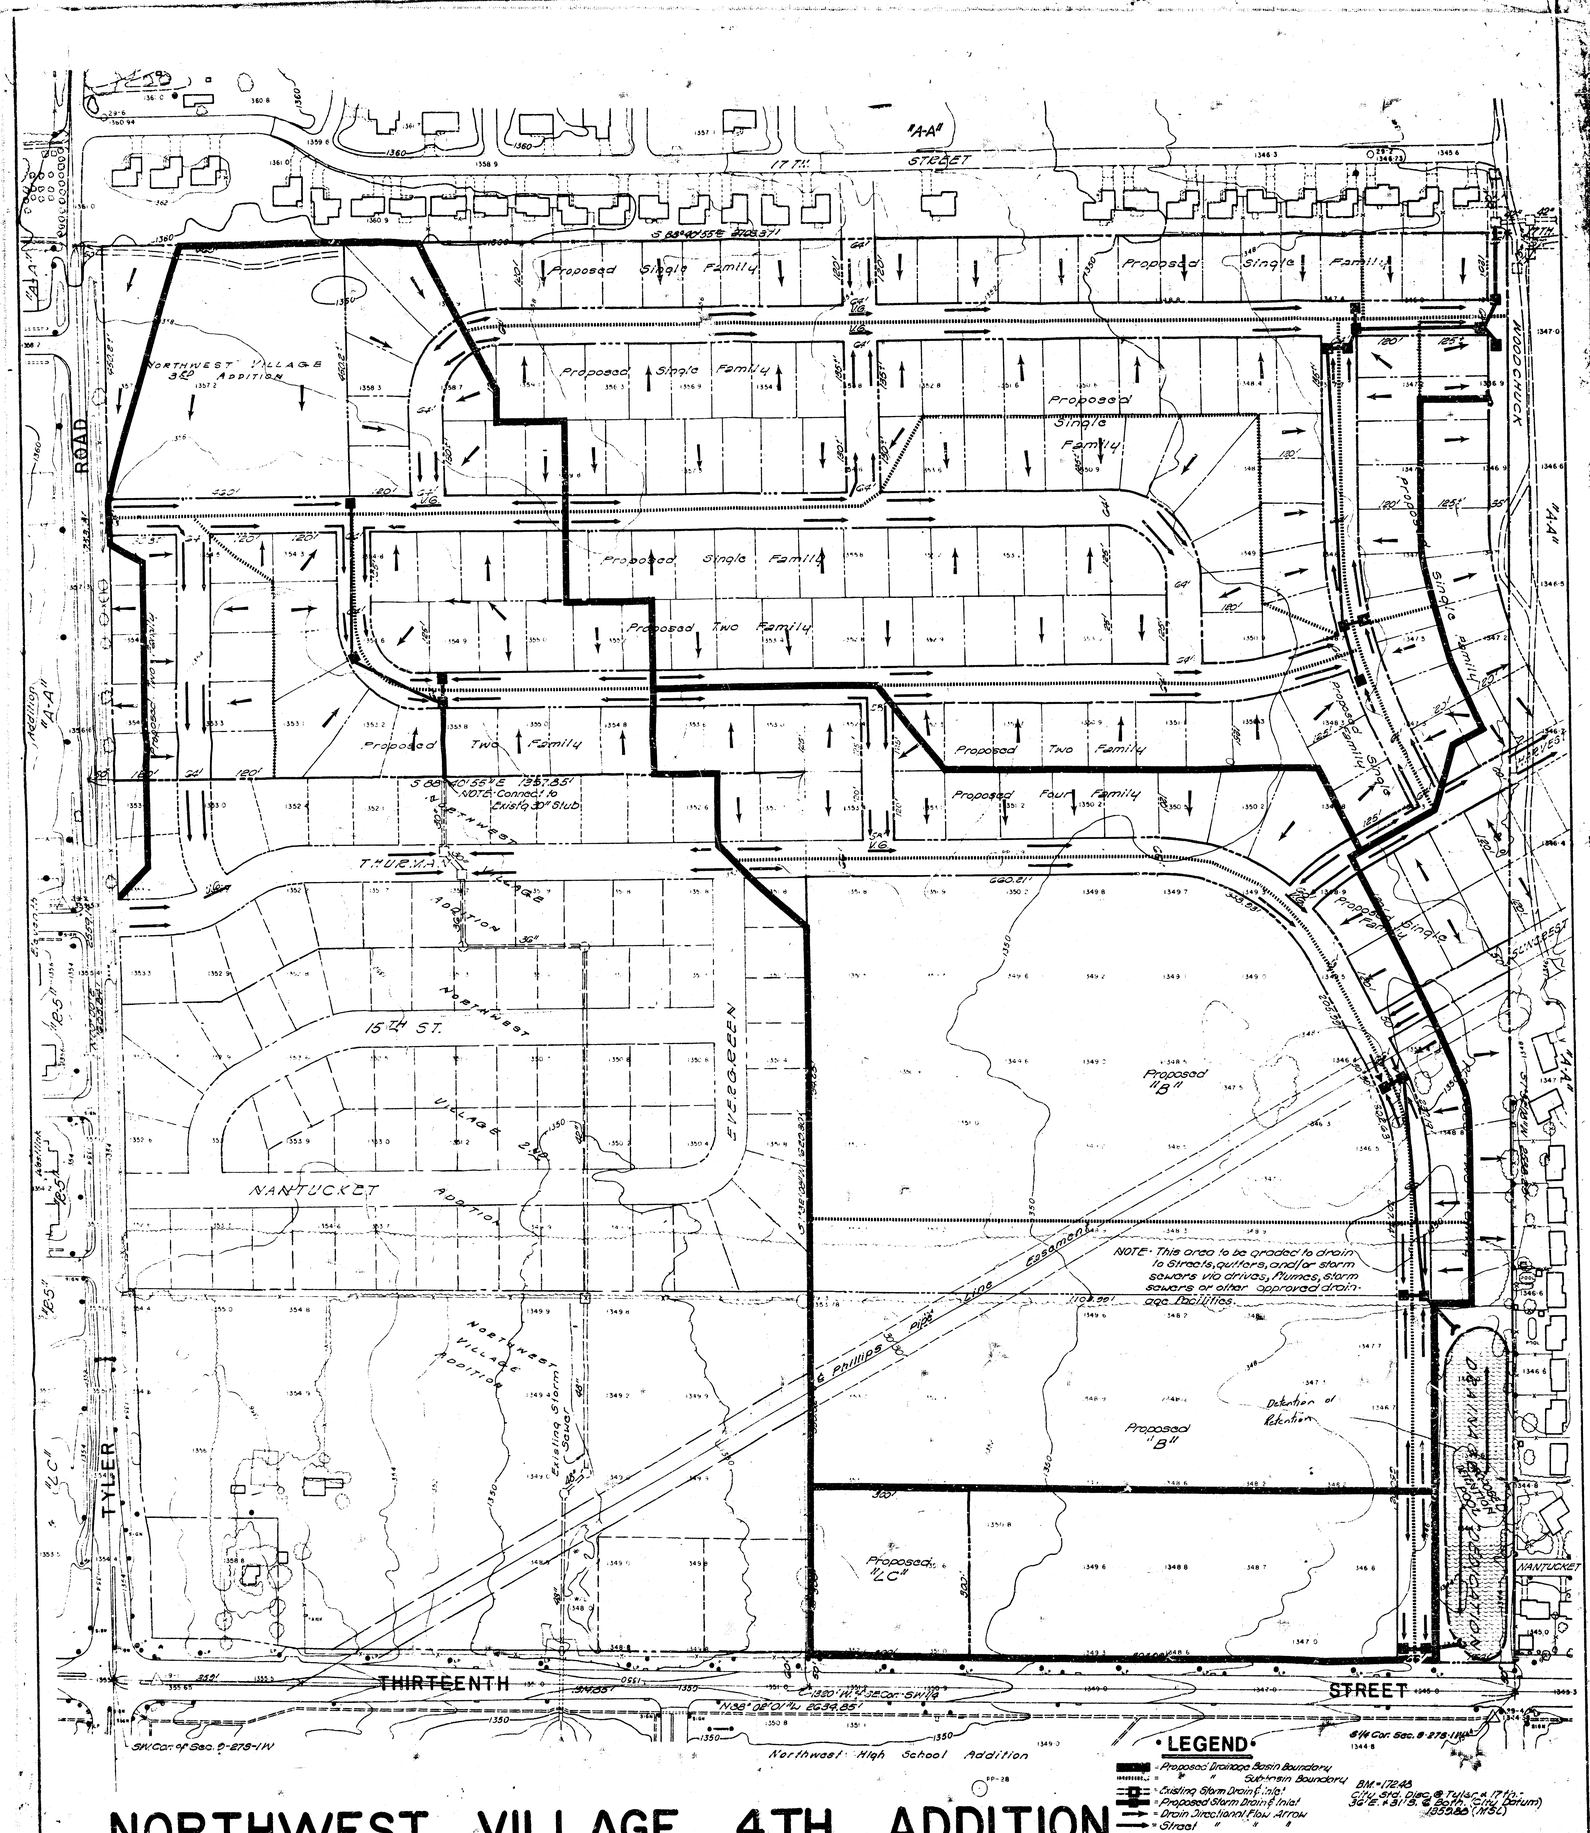

LEGEND

- Proposed Drainage Basin Boundary
- " " Sub-basin Boundary
- Existing Storm Drain & Inlet
- Proposed Storm Drain & Inlet
- Drain Direction/Flow Arrow
- Street " " "

BM = 1724.5
City Std. Disc @ Tyler & 17th.
36'E. + 31'S. @ 30th. (Datum)
1359.86 (NGS)

NORTHWEST VILLAGE 4TH ADDITION

MEMO

TO: Chris Breitenstein, P.E.	PROJECT NO. 36-81085-1186
City Hall - 7th Floor	PROJECT: Northwest Village
455 N. Main 67202	4th Addition
ATT#:	DATE: September 28, 1981
COPIES TO:	FROM: Charles S. Brown, P.E.
Louise Olivarez	REFERENCE: Drainage Concept
Mike Lindebek	

PLEASE ADVISE IMMEDIATELY OF ANY MISCONCEPTIONS OR OMISSIONS YOU BELIEVE TO BE CONTAINED HEREIN.

Transmitted herewith is one copy of the Drainage Concept for Northwest Village 4th Addition.

The Preliminary Plat will be submitted on Friday, October 2, 1981 for hearing on October 15, 1981.

If you have any questions, please call Dick Linn or Gary Wiley at our Land Development Office, 269-1107.

Detention or Retention Pond?
No Outfall Structure.
City Maintained?

RECEIVED
OCT 1 1981
Dept. Of Engineering