


# SKETCH PLAT PMT ADDITION

WICHITA, SEDGWICK COUNTY, KANSAS

PART OF LOTS 1 AND 2, WALNUT GROVE ADDITION AND A TRACT IN THE S.E. 1/4  
OF THE S.W. 1/4 OF SEC. 29, TWP. 26-S, R-1-E.

PMT PROPERTIES, INC.  
1100 W. 37TH STREET NORTH  
WICHITA, KANSAS 67204

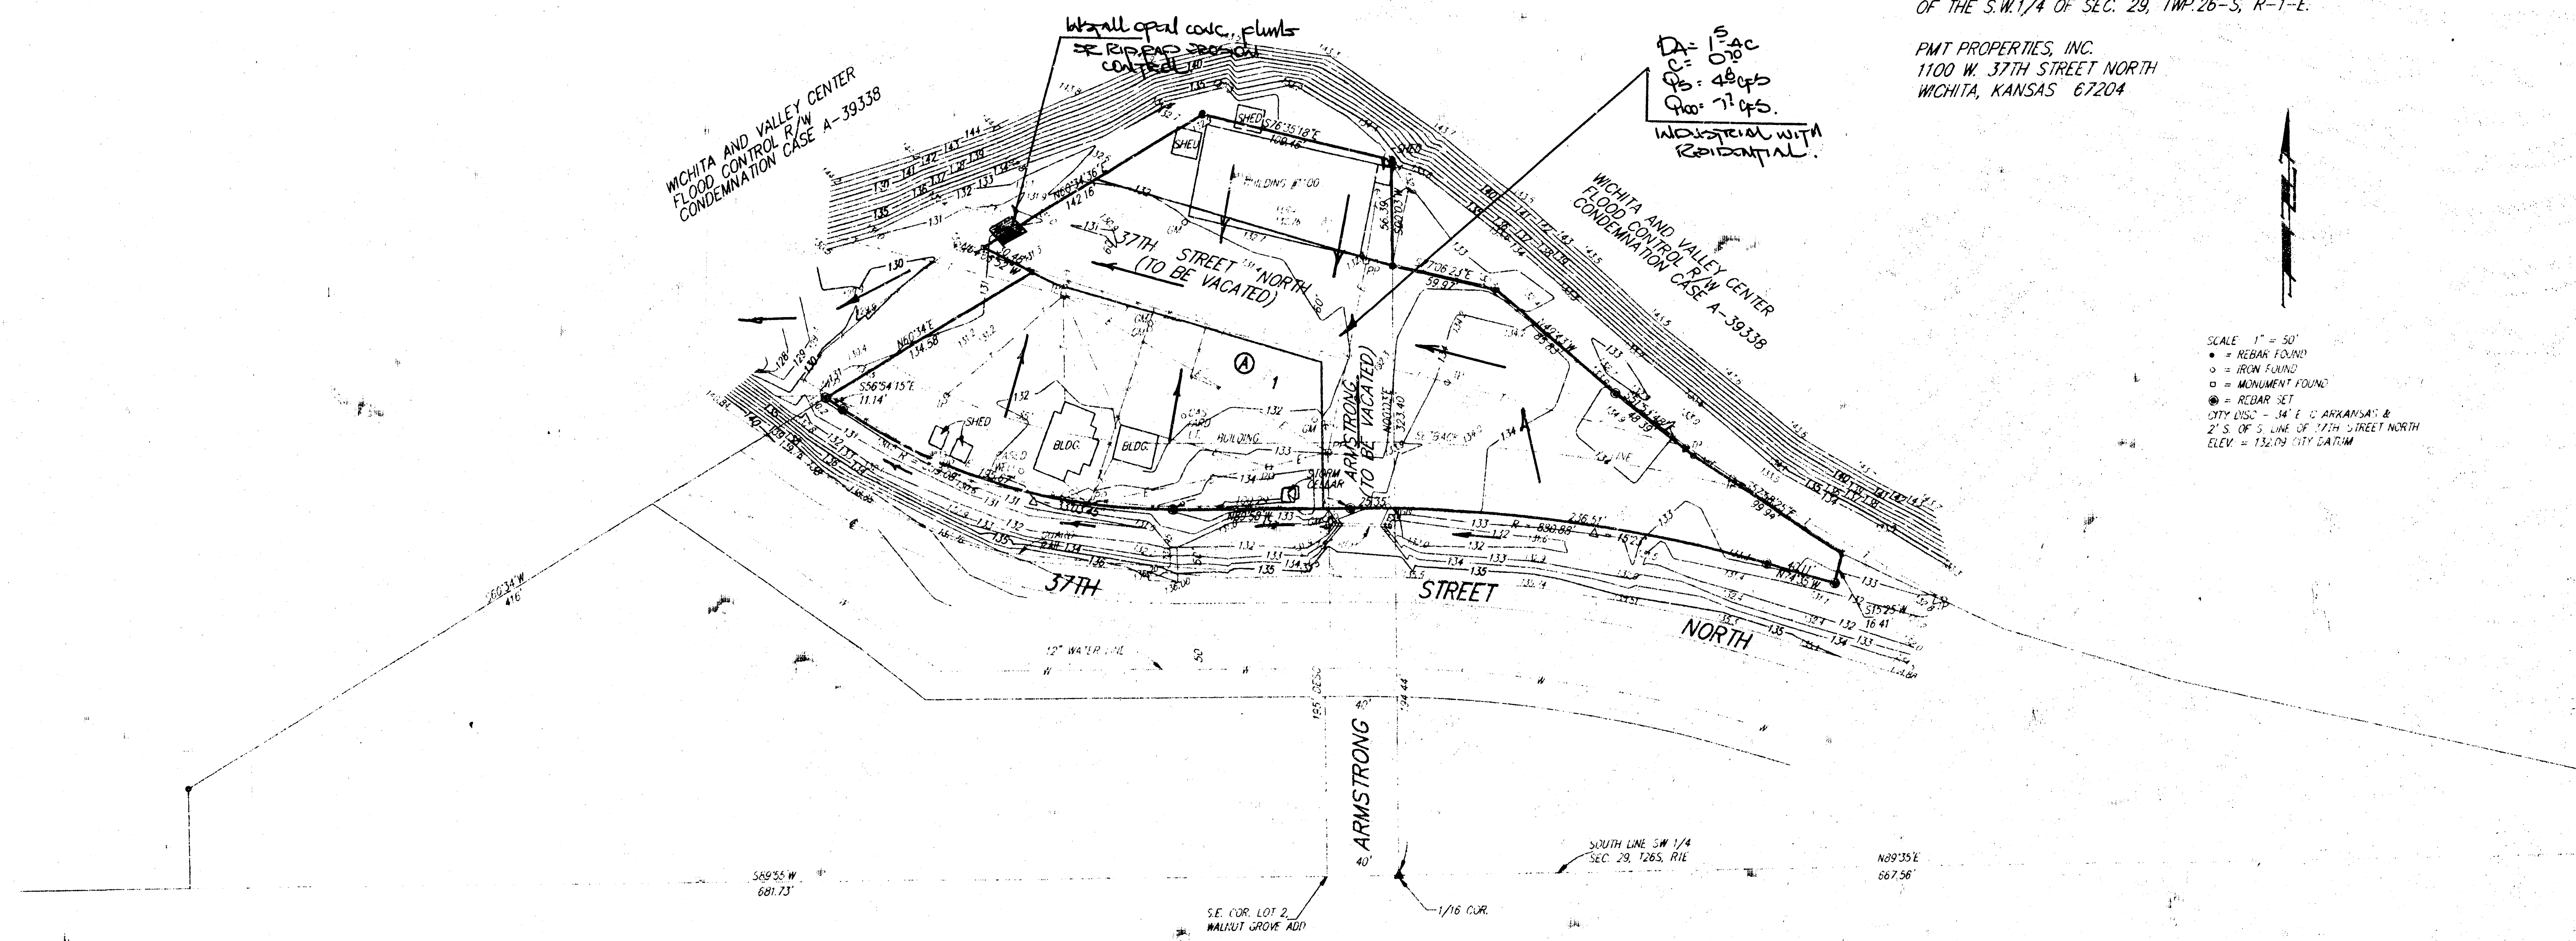

SCALE: 1" = 50'  
 \* = REBAR FOUND  
 o = IRON FOUND  
 □ = MONUMENT FOUND  
 ■ = REBAR SET  
 CITY LOTS - 34' E. OF ARKANSAS &  
 2' S. OF S. LINE OF 37TH STREET NORTH  
 ELEV. = 1320.00 CITY DATUM

**DRAINAGE  
— PLAN —**