



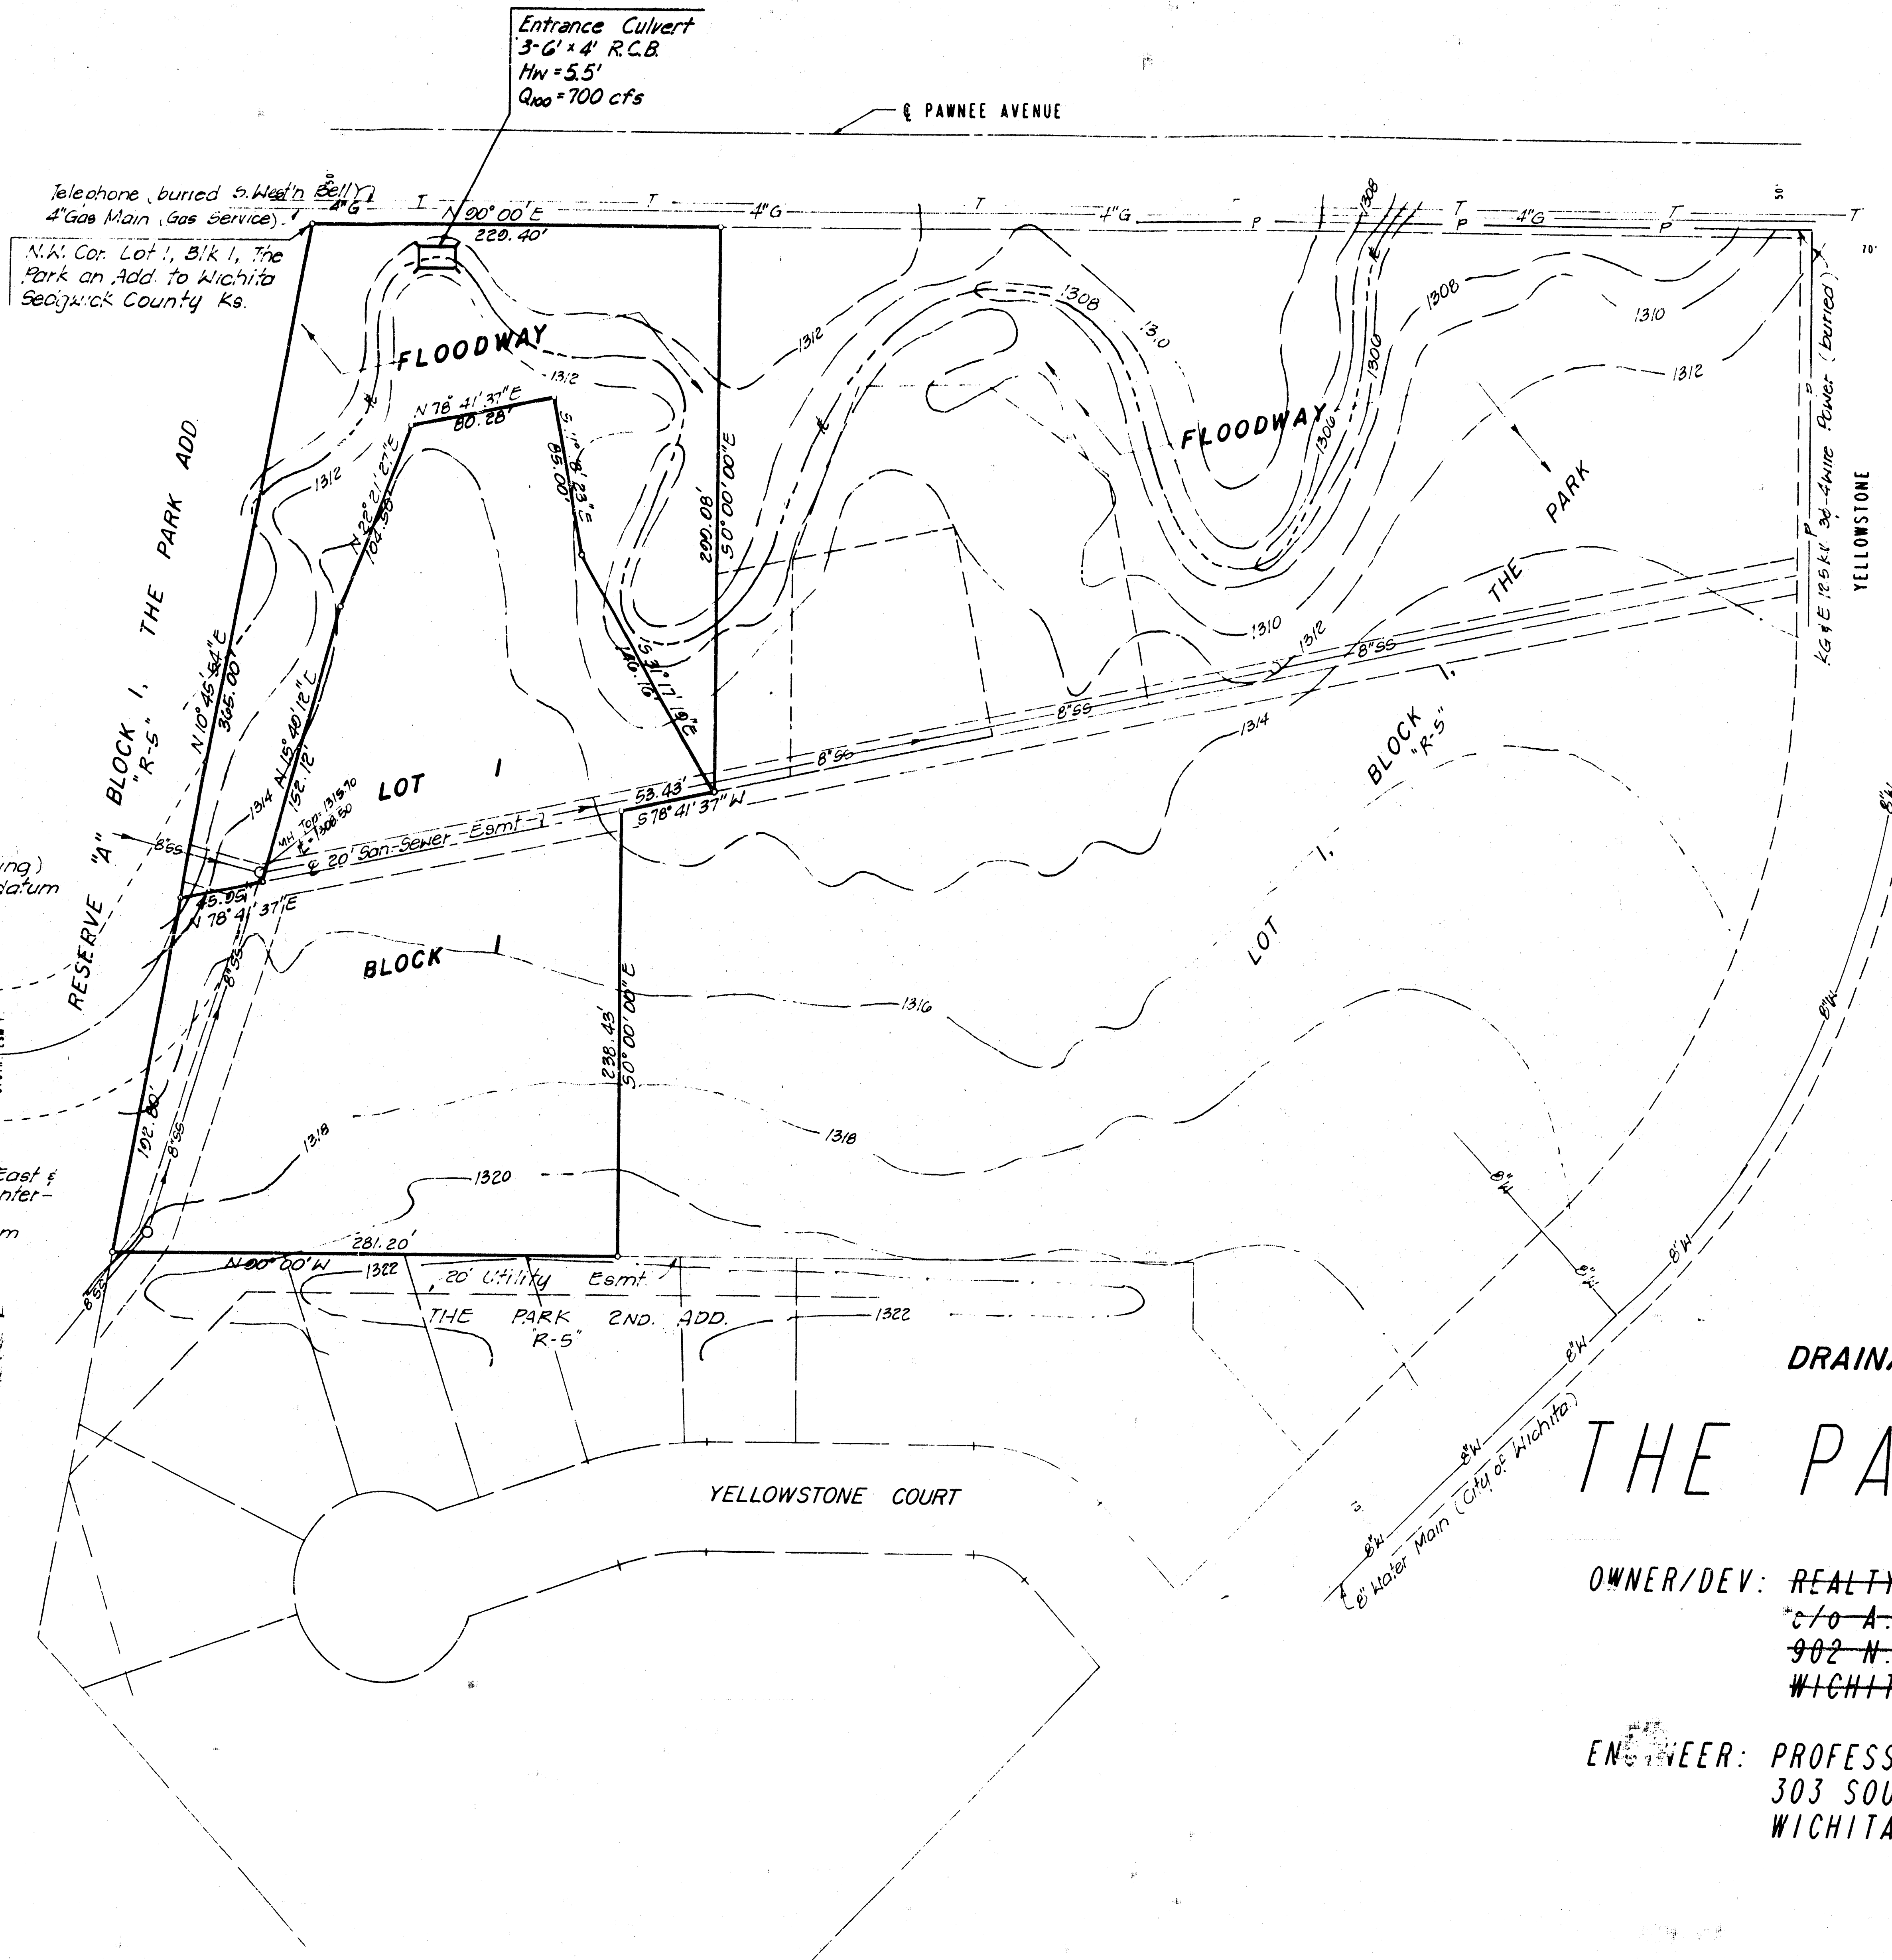

Min Pad Elev (Min opening)
= 1310 ms. = 1310 City datum

SCALE: 1" = 50'

B.M. Marze Rd at Pawnee
City of Wichita B.M. disc, 32' East &
28' South of intersection of center-
line both
Elev. = 135.503 City datum
= 1322.003 M.S.L.

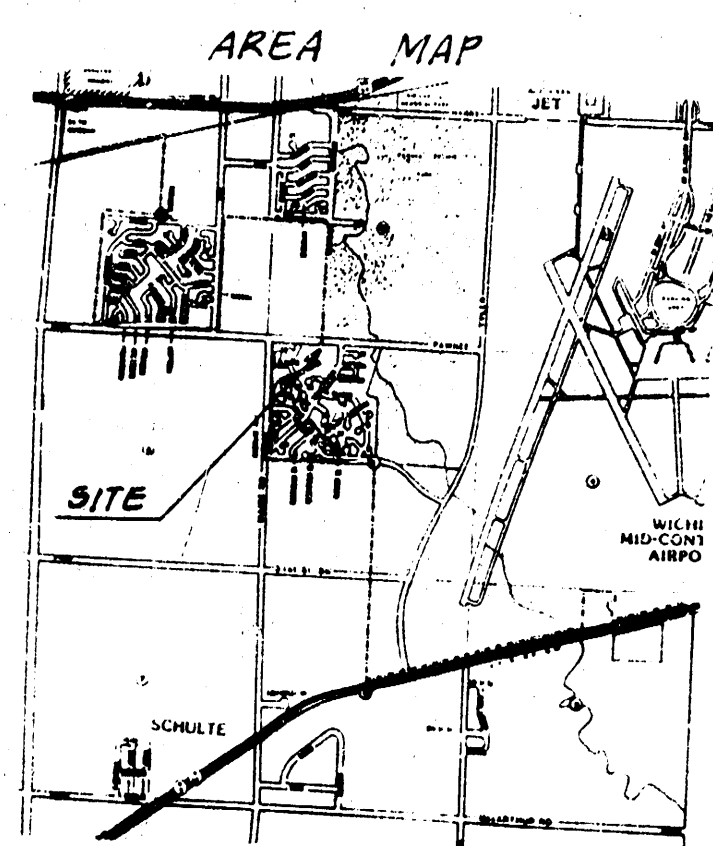

All of Lot 2, Block 1 shall be graded to drain
to the floodway via flumes drives, private streets,
private storm water sewers and/or other
approved drainage facilities.

DRAINAGE PLAN

THE PARK CHATEAU

OWNER/DEV: REALTY ONE CORP.
c/o A. J. SOERRIES
902 N. WEST STREET
WICHITA, KS 67203

MARK A. CHAPPELLE
500 S. HOLLAND
STE. 512
WICHITA, KS. 67207

ENGINEER: PROFESSIONAL ENGINEERING CONSULTANTS, P.A.
303 SOUTH TOPEKA
WICHITA, KS. 67202

