


PEMBROOK

AN ADDITION, TO WICHITA, SEDGWICK COUNTY, KANSAS

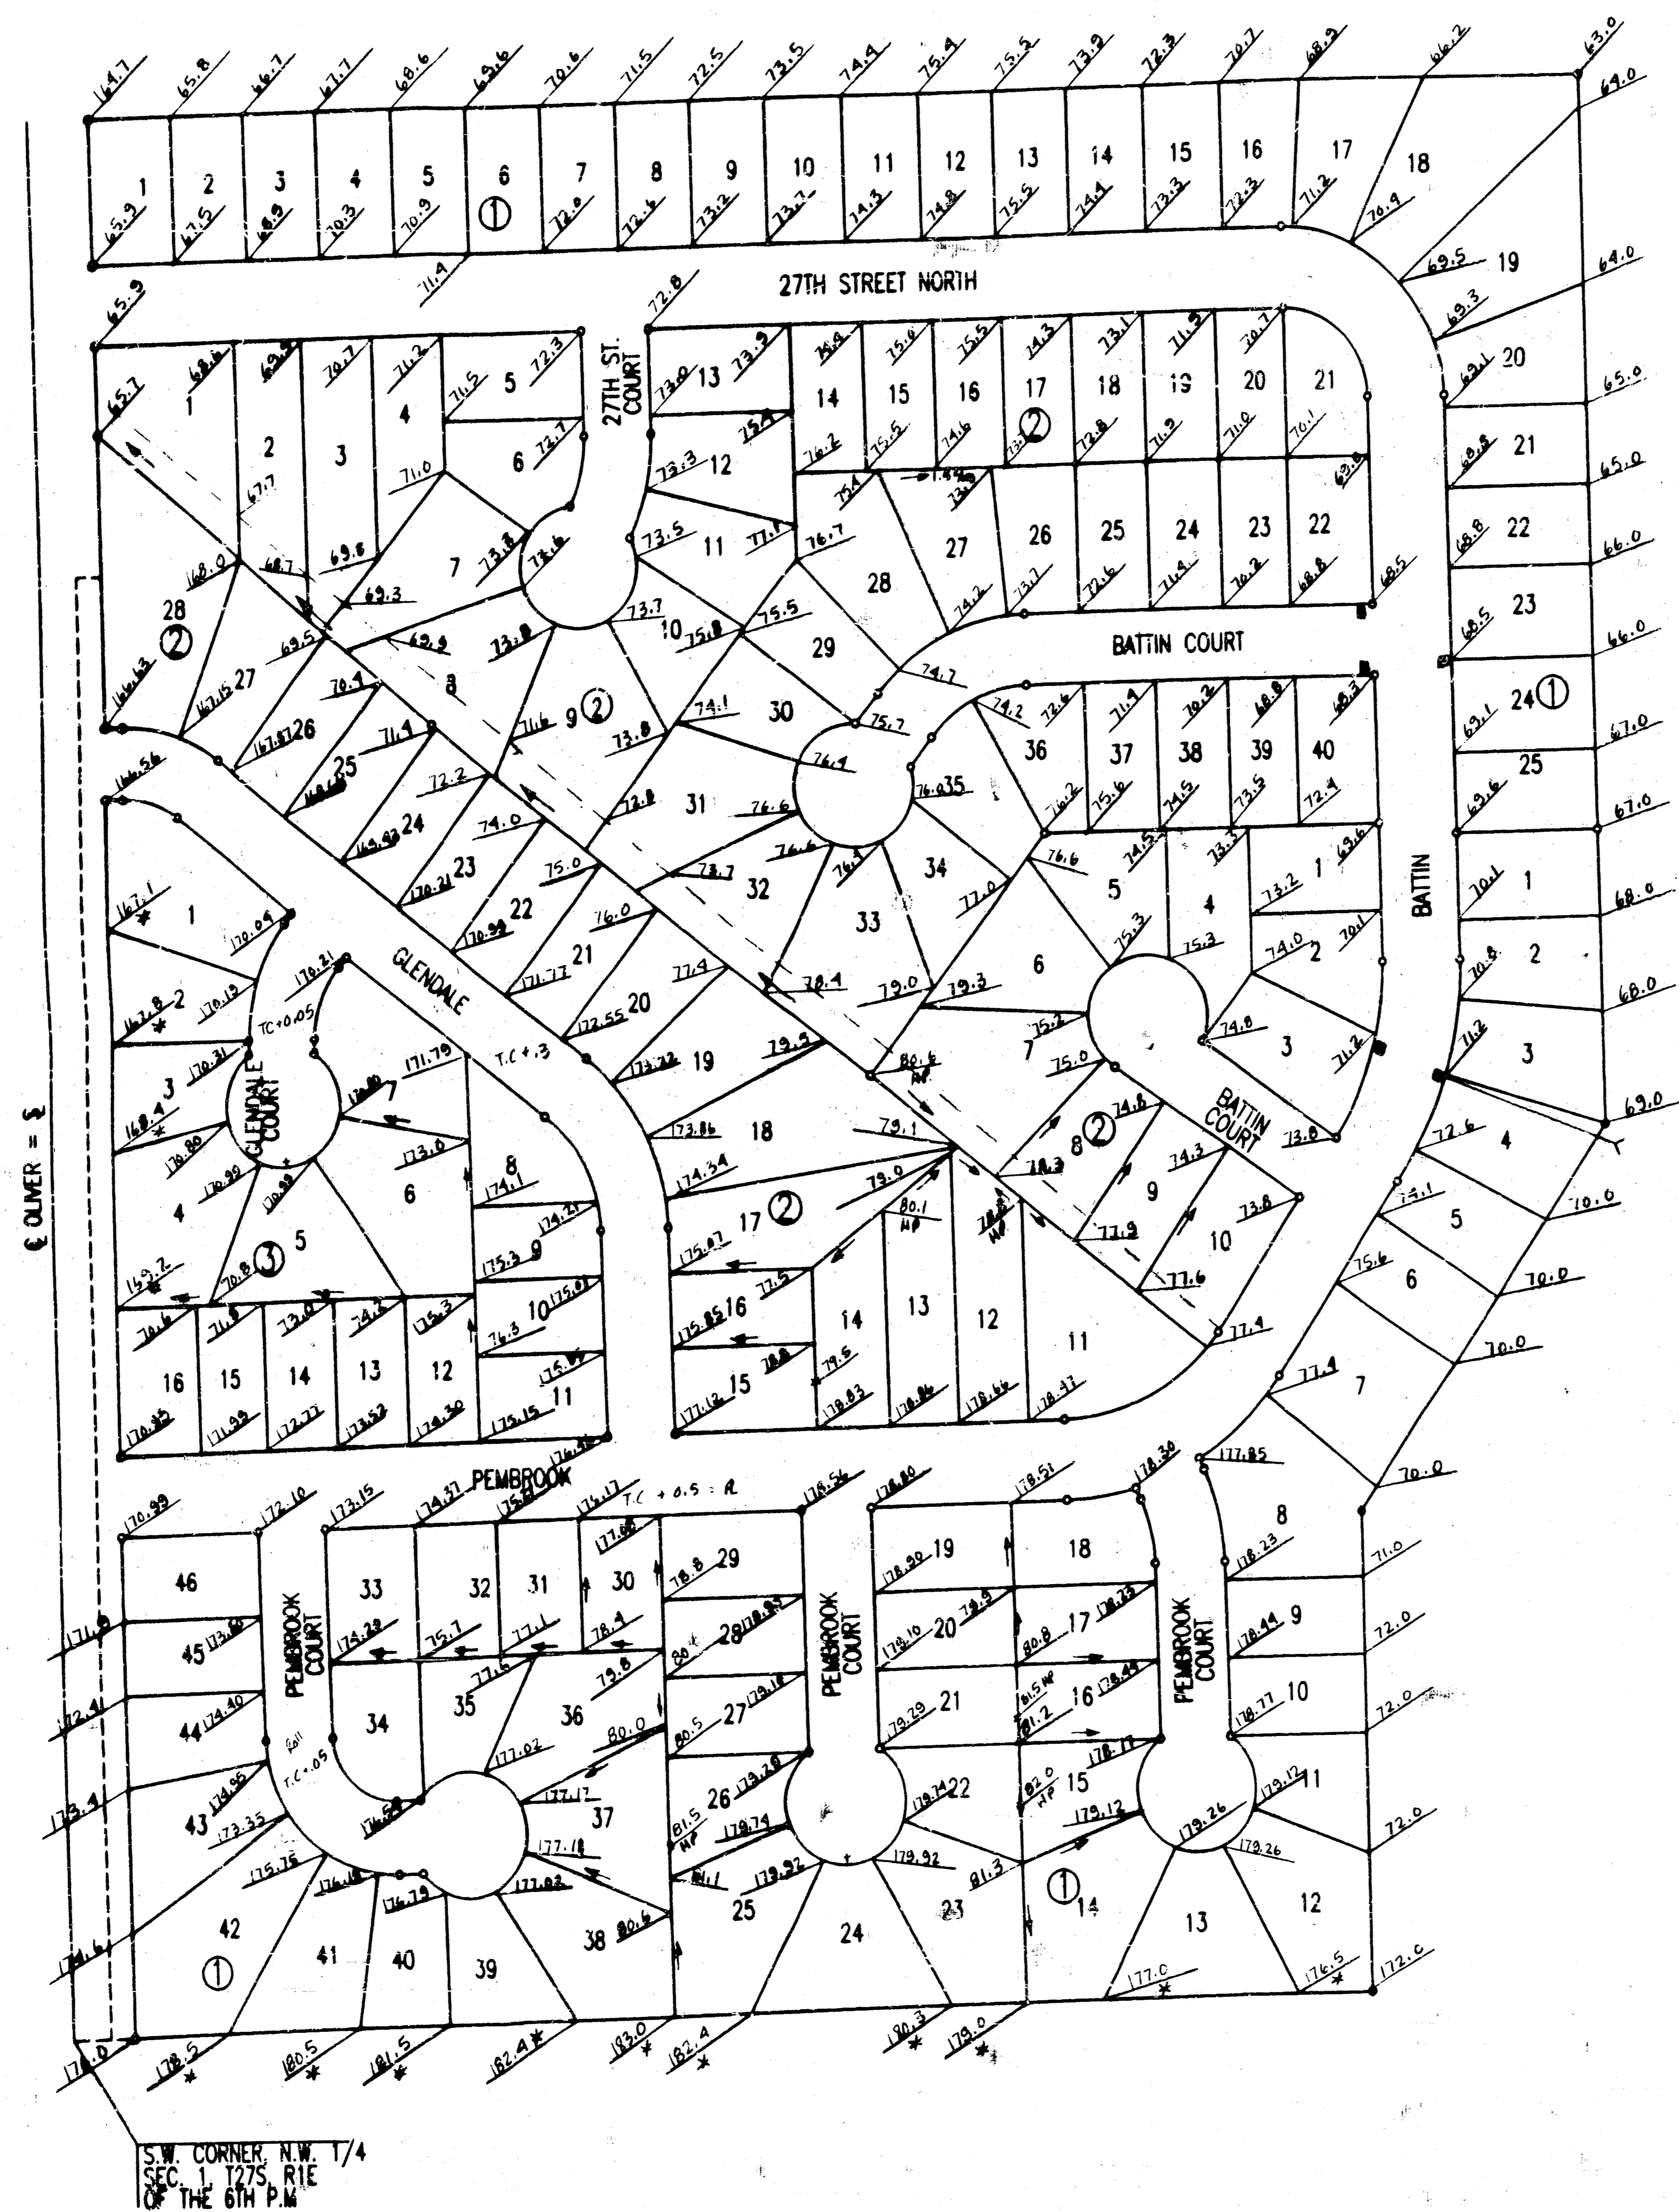

S.W. CORNER N.W. 1/4
OF THE 6TH P.M.





* Match Existing Elevation

Pembroke & Pembroke 2nd

APPROVED
MANAGE PLAN

Revised 7-27-98 KER