


Bunk Trip 2nd

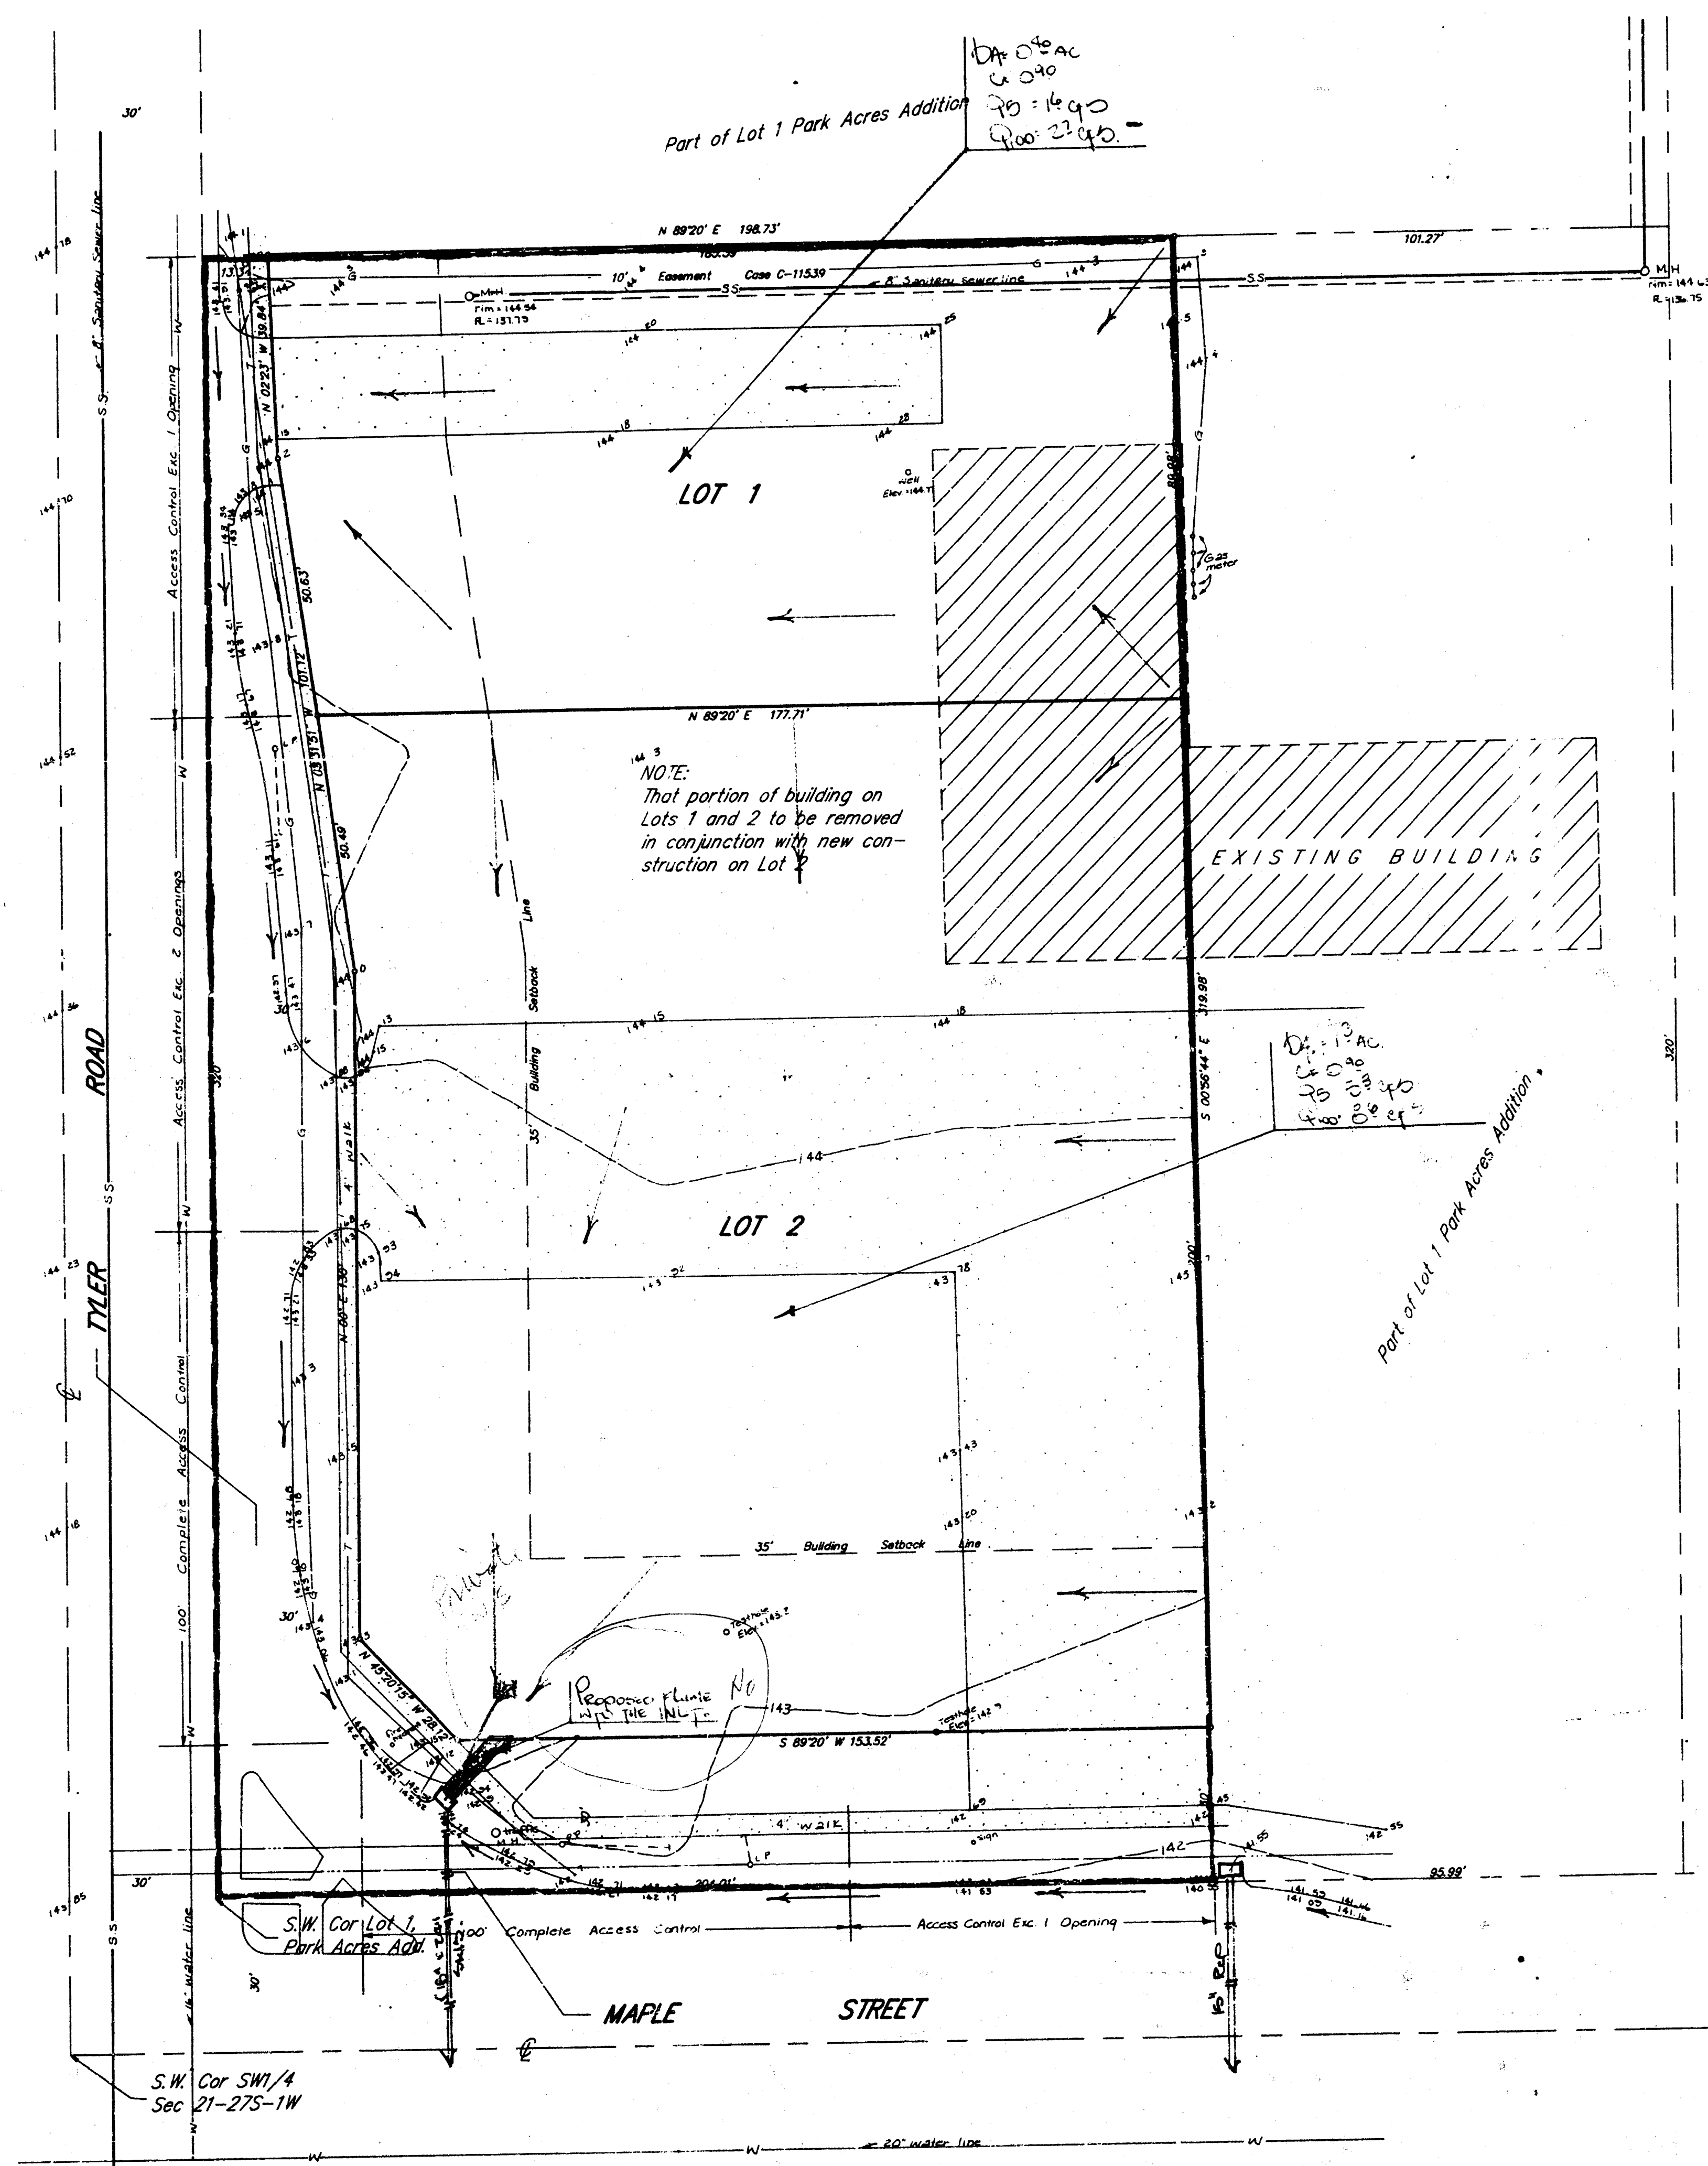

SKETCH PLAT

QUIKTRIP 2ND ADDITION

WICHITA, SEDGWICK COUNTY, KANSAS

Part of Lot 1, Park Acres Addition, Sedgwick County, Kansas.

RON GROVES

DRAINAGE PLAN