
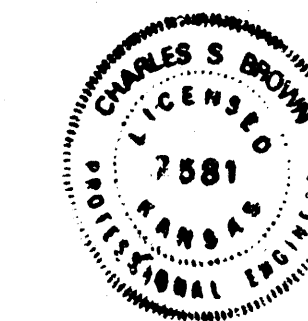


Reflection Ridge 5th Add.

DRAINAGE PLAN **REFLECTION RIDGE 3RD ADDITION** TO WICHITA, SEDGWICK COUNTY, KANSAS AND REFLECTION RIDGE 5TH ADD.

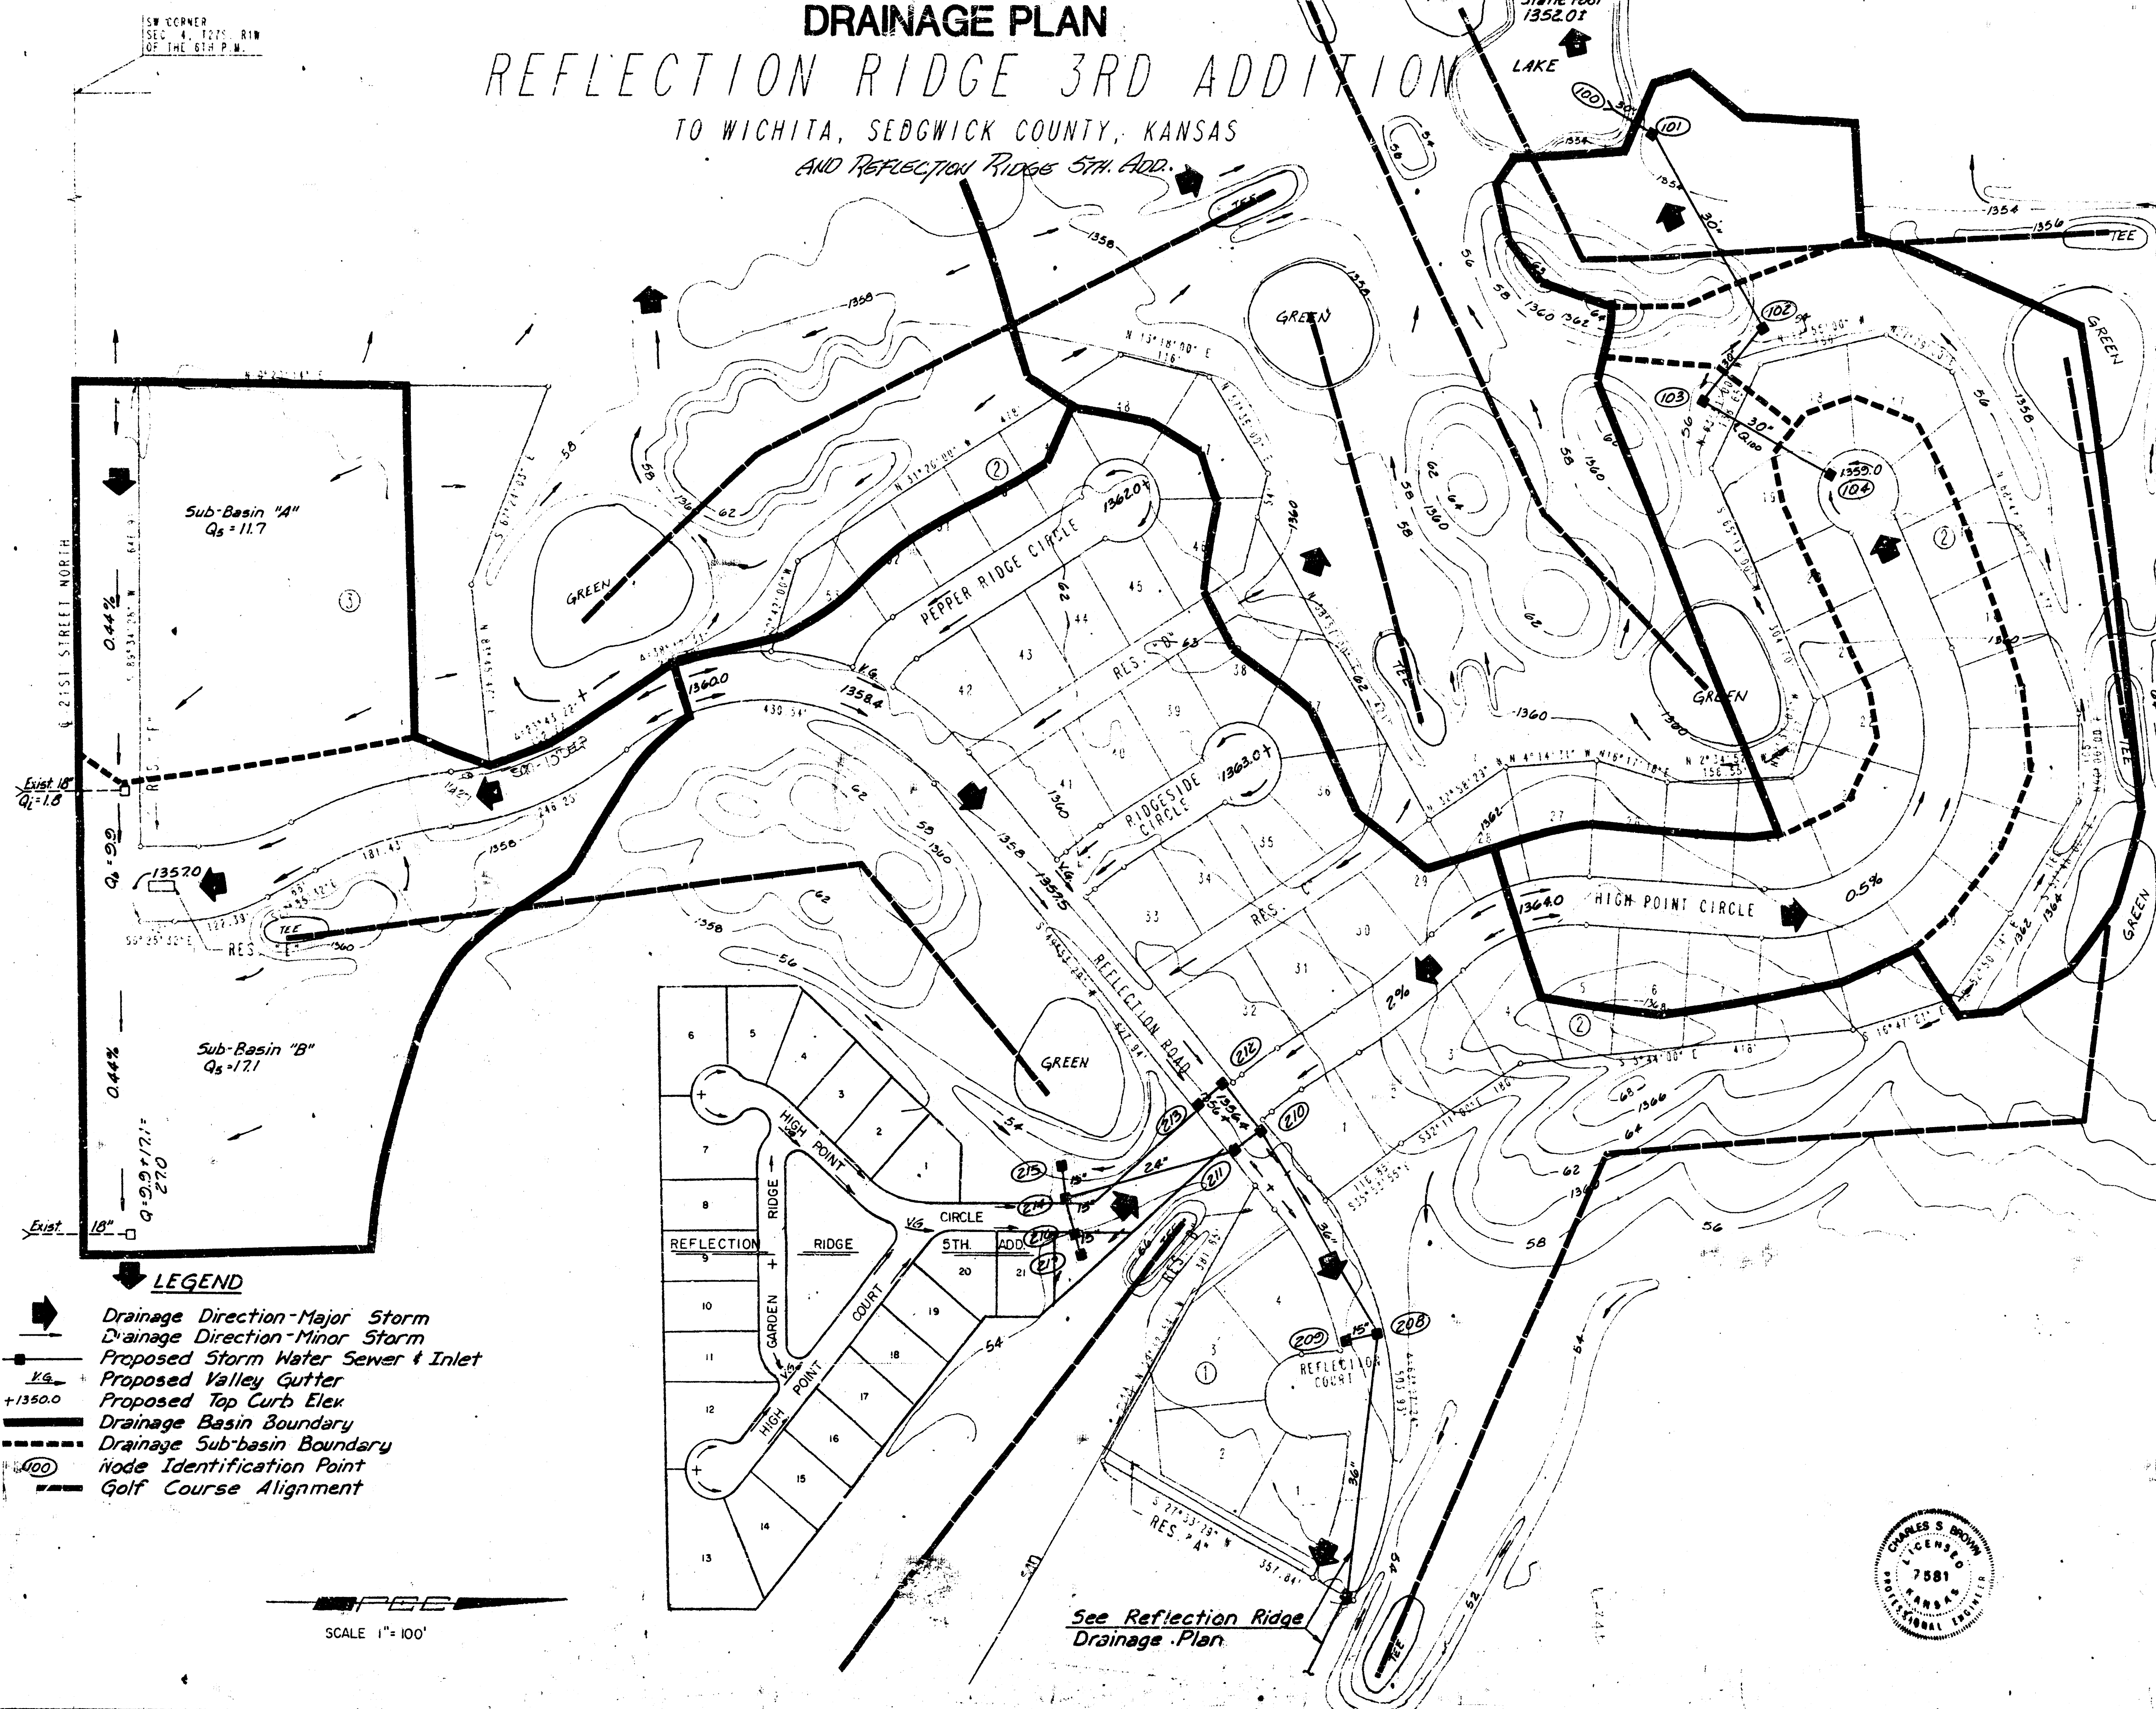

Revised 2.14.89
 1700