


REPROCO 1ST ADDITION
(Drainage)

Bench mark:
1" cut in concrete at NE corner
of Bldg. #5401 M.R. 1999
Elevation = 122.17 City Datum

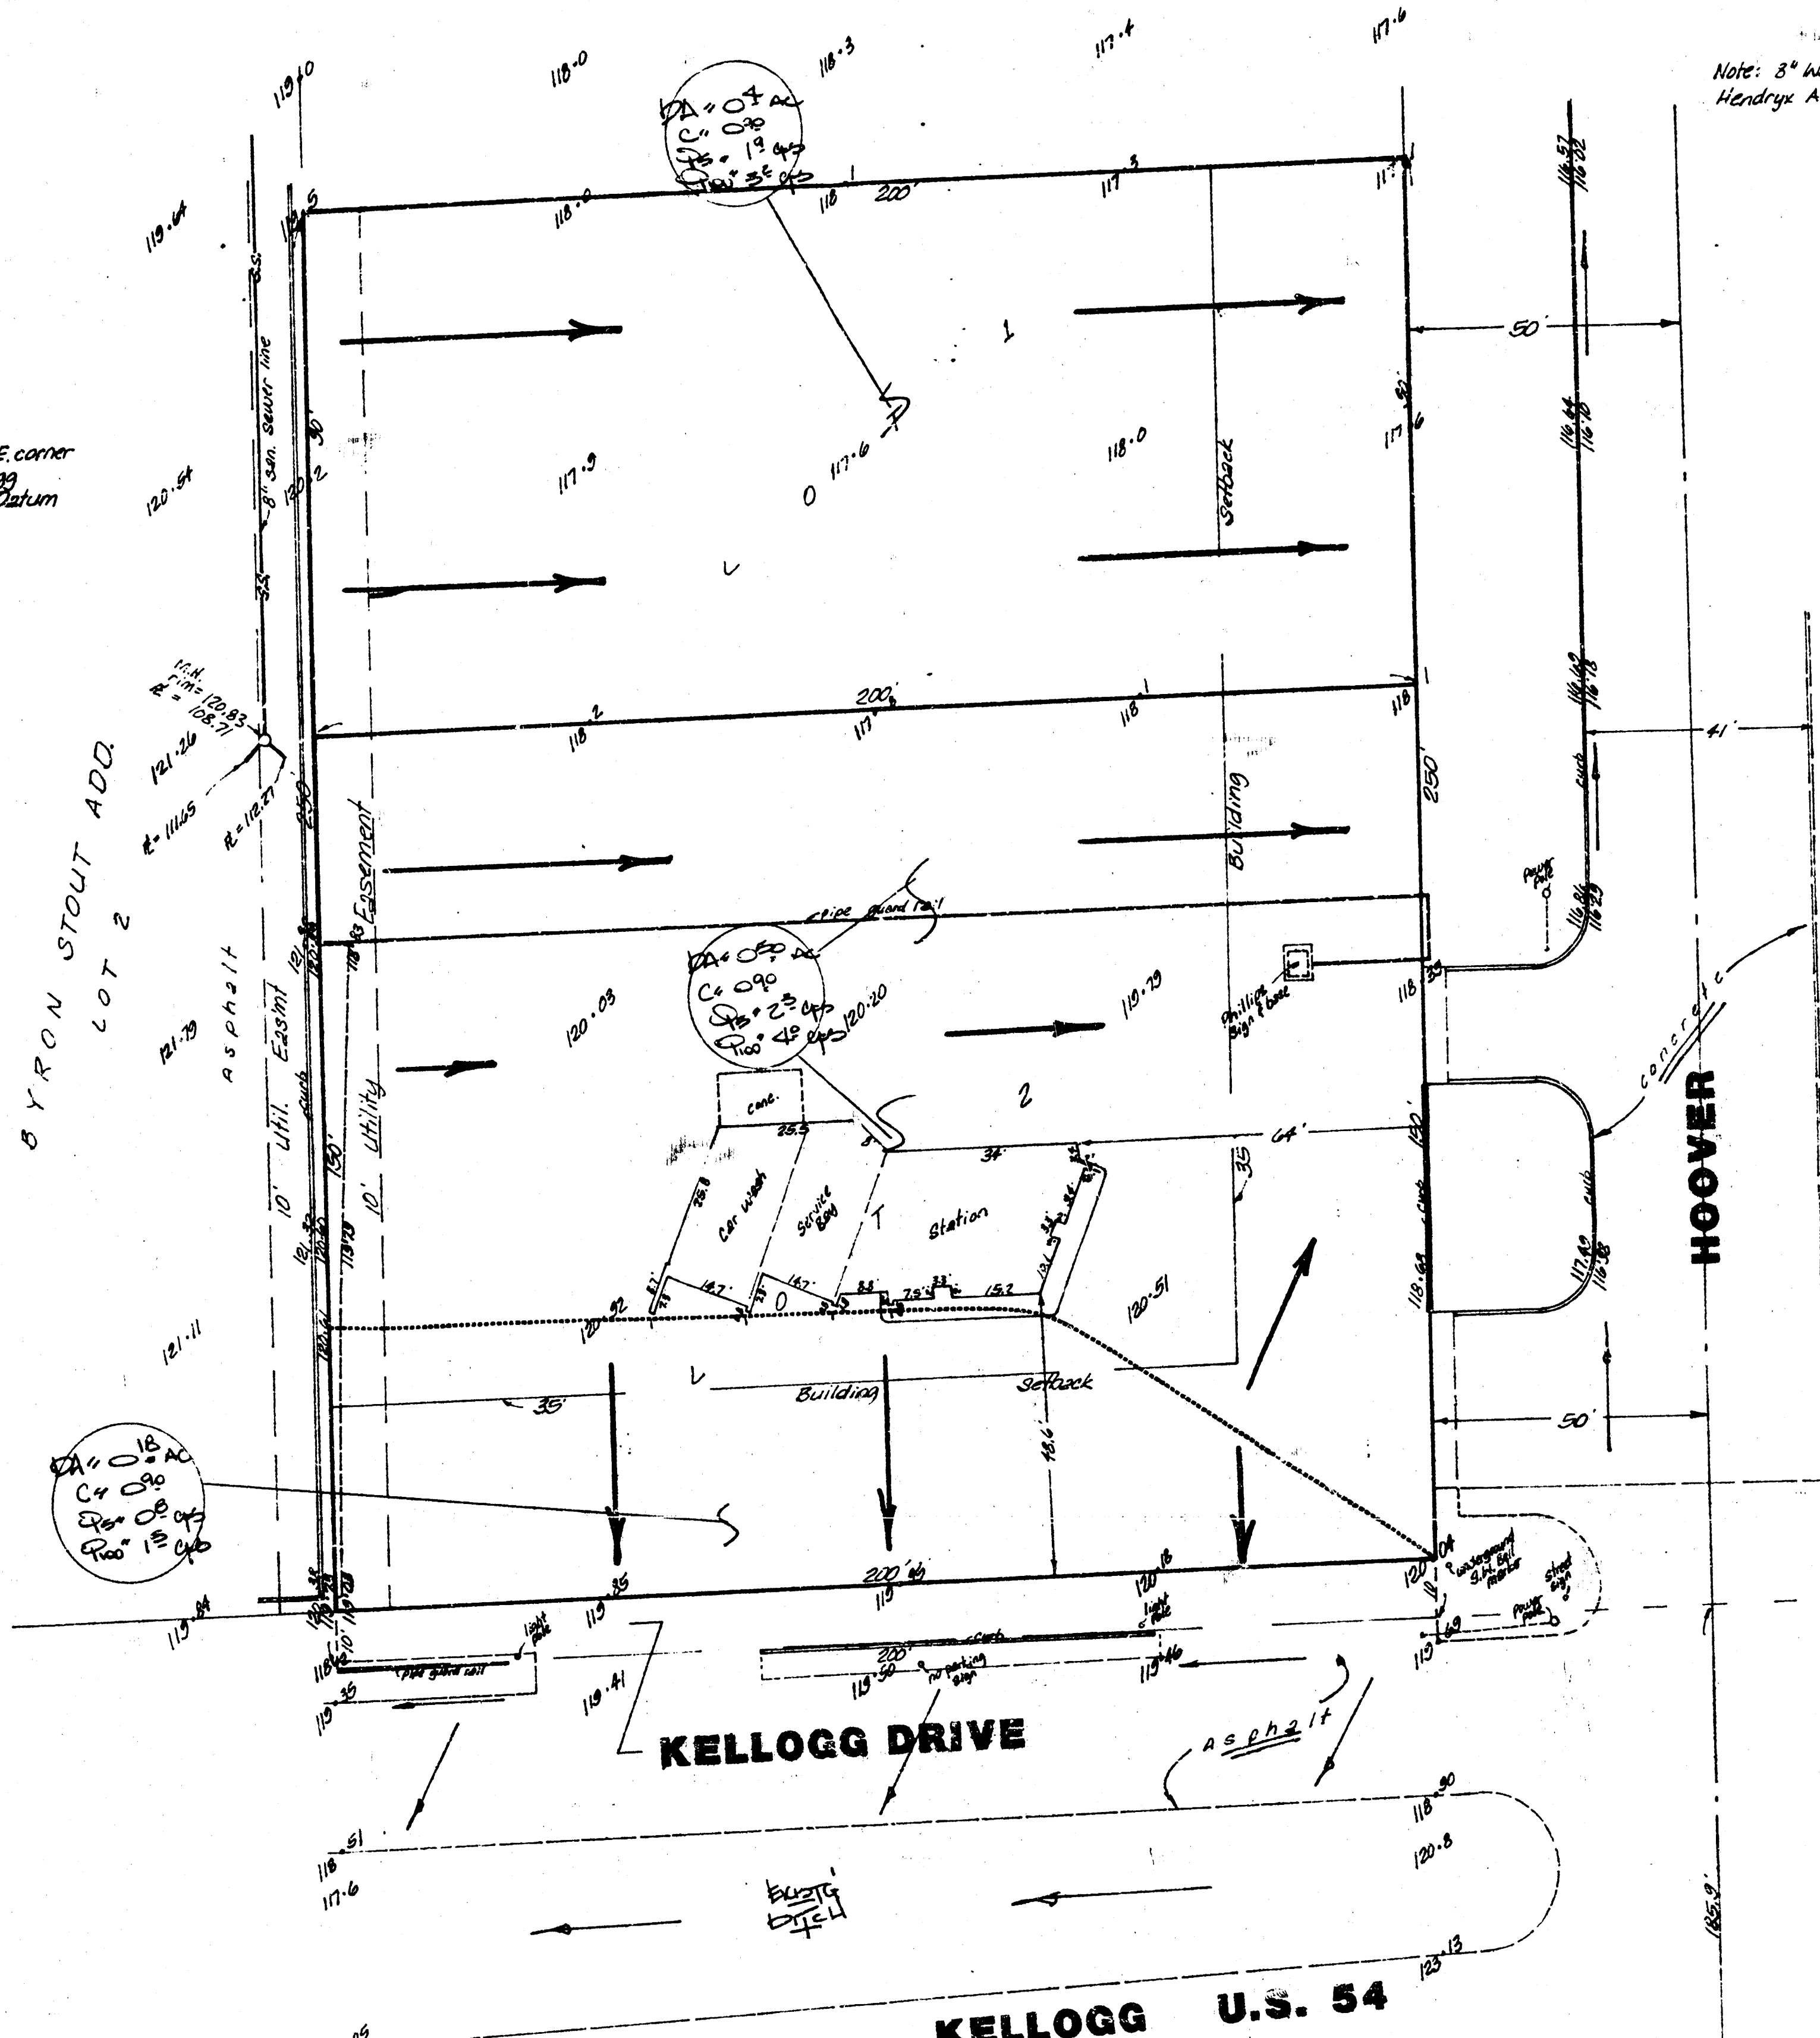

Note: 3" water line in
Handry Ave to the north

Note:
Lots will drain to Kellogg ditch
& directly to Hoover road which
is paved. Lot 1 will drain
entirely to Hoover.
Hoover drains north as
indicated. Kellogg ditches
drain south to the existing ditch
and then both lots will drain
to the streets they cross.

SKETCH PLAT
REPROCO 1ST ADDITION
THE SOUTH 250 FEET OF THE EAST 200
FEET OF LOT 1 REPLAT OF DALE GARST
ADDITION AND PART OF GARST GARDENS,
WICHITA, KANSAS.

OWNER: REPROCO INC.
A DELAWARE CORPORATION

FINAL DRAINAGE PLAN el/et

SE. CO.
NE 4 27TH N.

ED BAUGHMAN COMPANY, P.A.
SURVEYING & ENGINEERING
2102 WEST 12TH ST. SUITE 100
WICHITA, KANSAS 67203
APR 15, 1994