



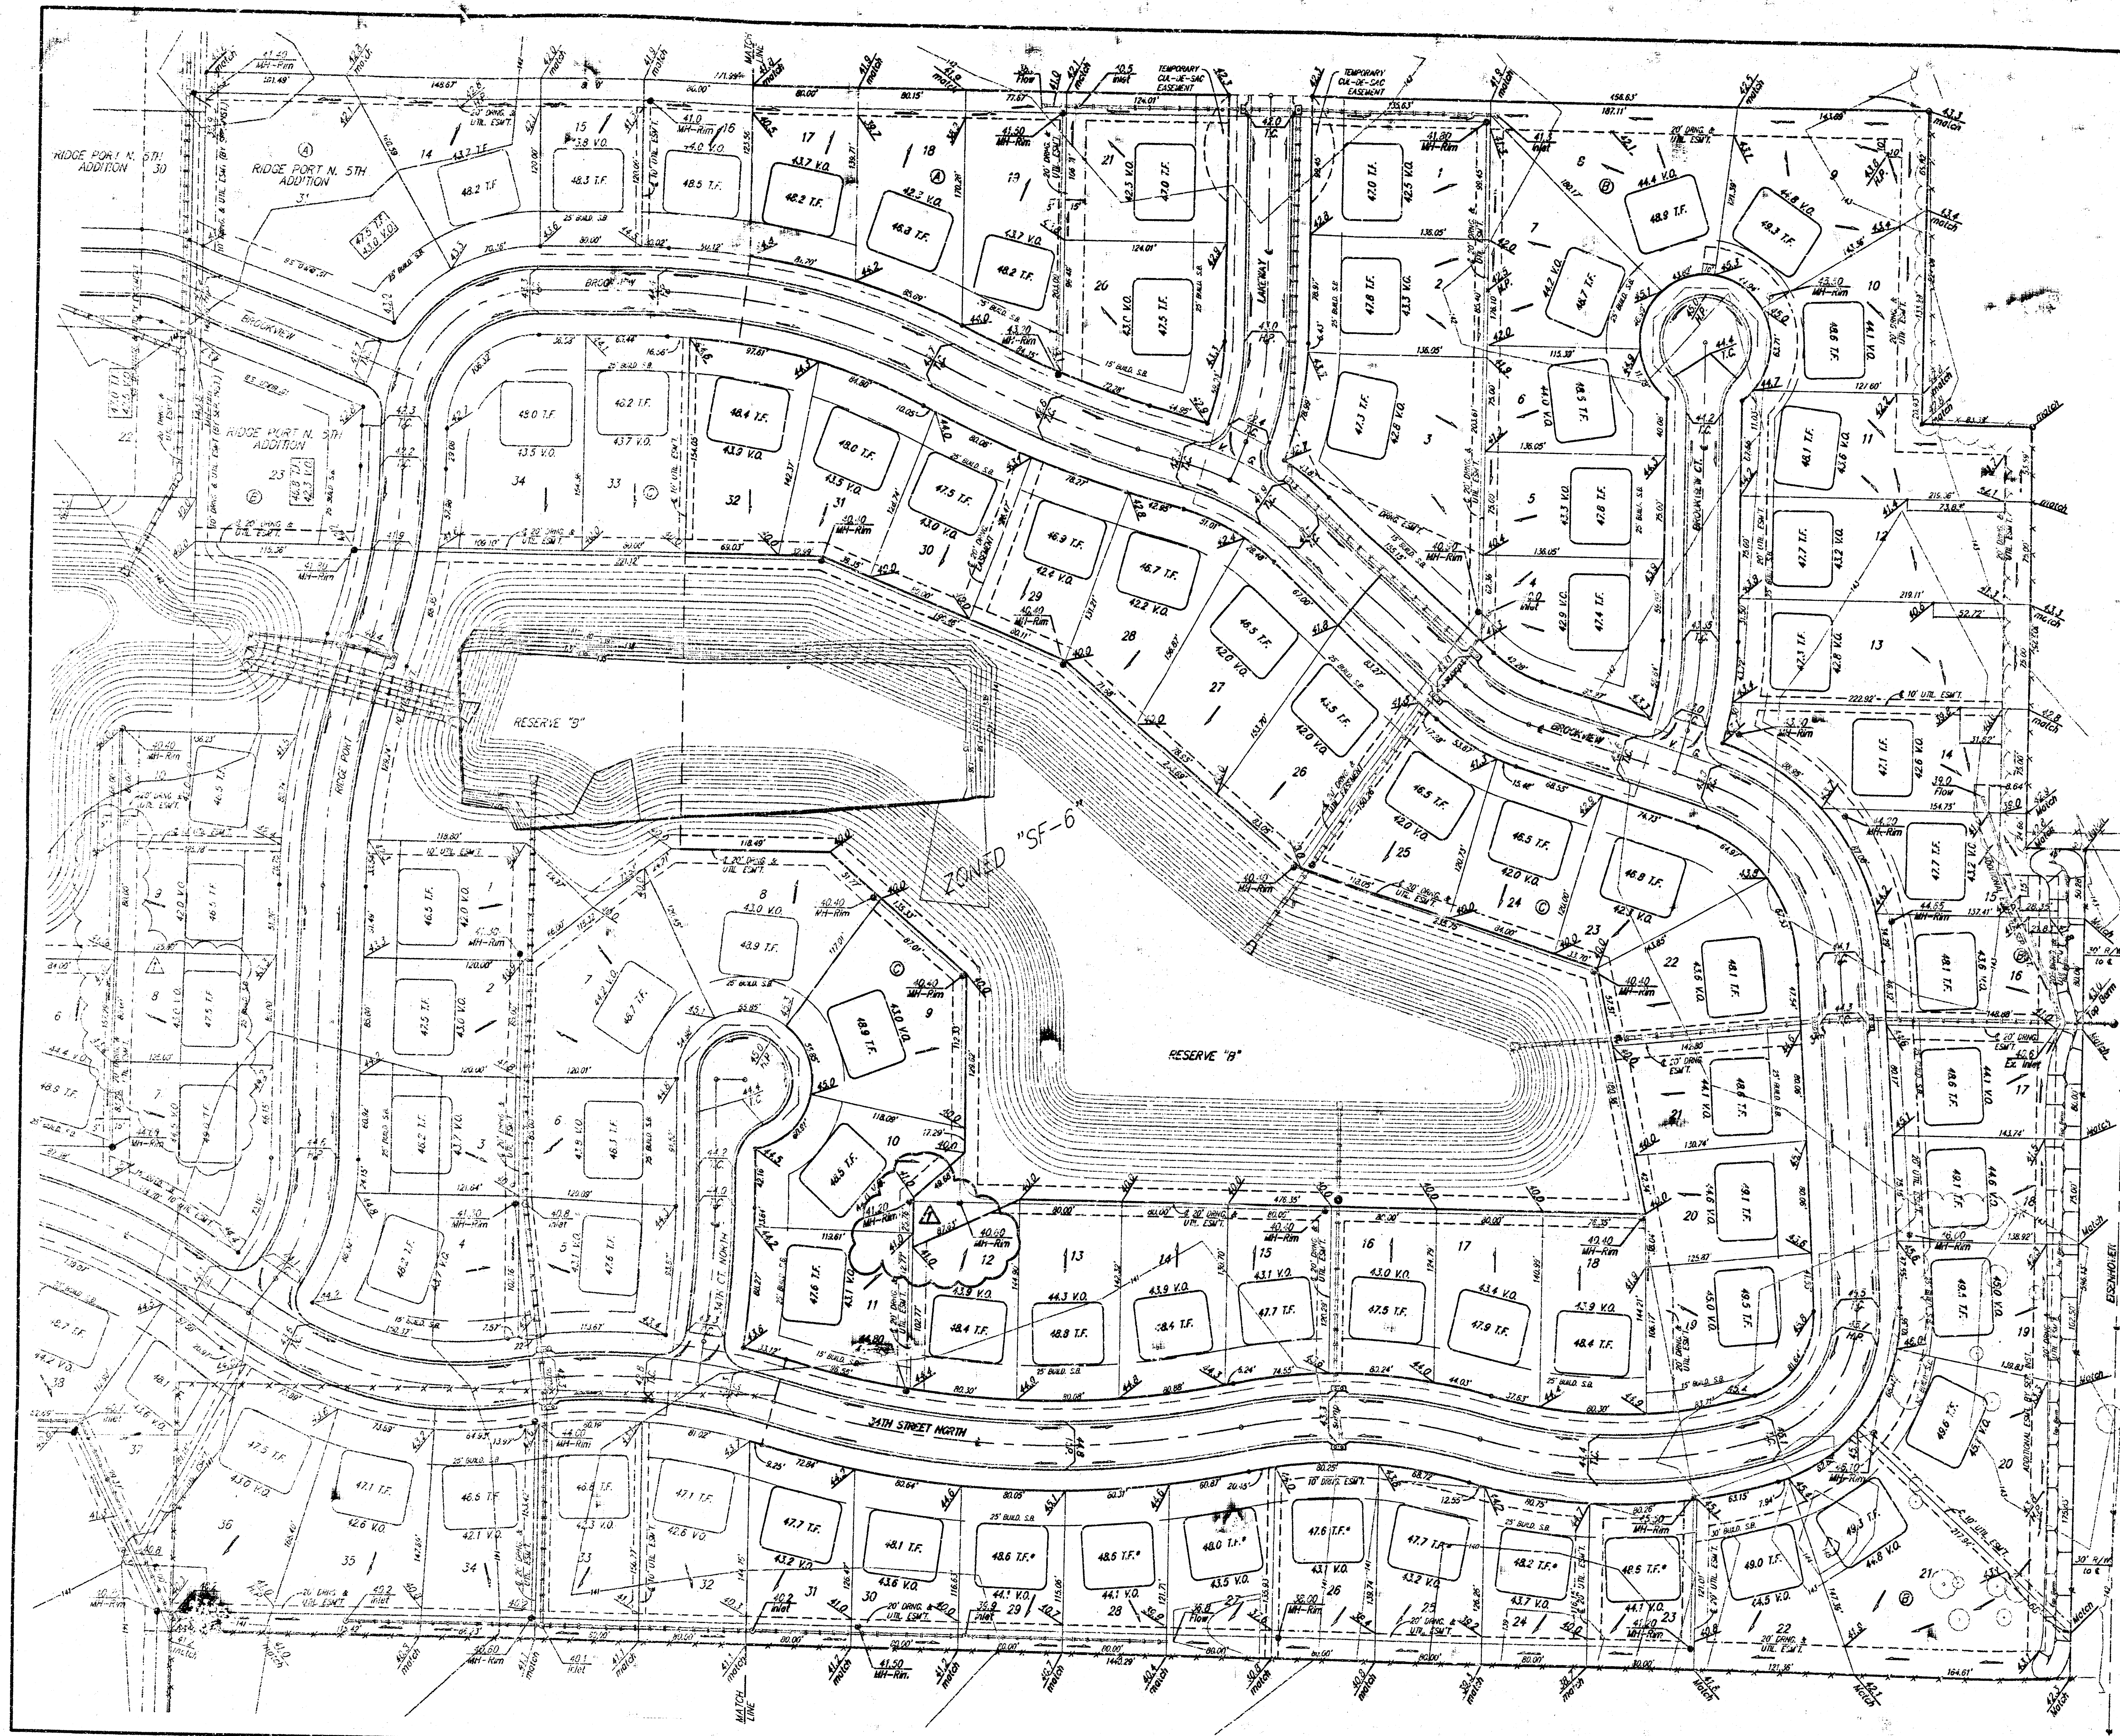

SCALE: 1" = 60'
• = Iron

APPROVED
DRAINAGE PLAN

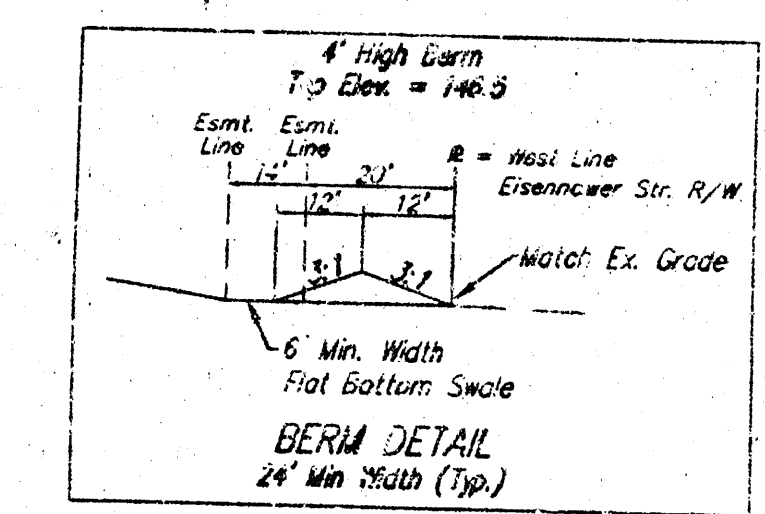

- 1. ONLY REVISION PAGE 2!
- REVISION 8/10/03 by AEG - T.F. & V.O. for Lot 13, Block C
- REVISION 11/25/02 by AEG - berm and grades along east line adjacent to Lot 13 to Ridge Port N. 5th
- REVISION 7/24/02 by AEG per NEM - top of foundations
- REVISION 4/10/02 by UNK per NEM - grades and SMS alignment
- REVISION 4/9/02 by AEG per NEM

RIDGE PORT NORTH 4TH ADDITION GRADING PLAN WICHITA, KANSAS				
BAUGHMAN COMPANY P.A. ENGINEERING, SURVEYING, & PLANNING 315-252-7771 • 315-251-1111 • WICHITA, KANSAS				
PROJECT NUMBER				
DESIGN	DRAWN	APPROVED	DATE	SCALE
	BLG		3/12/2001	NOTED
				SHEET 2 OF 2