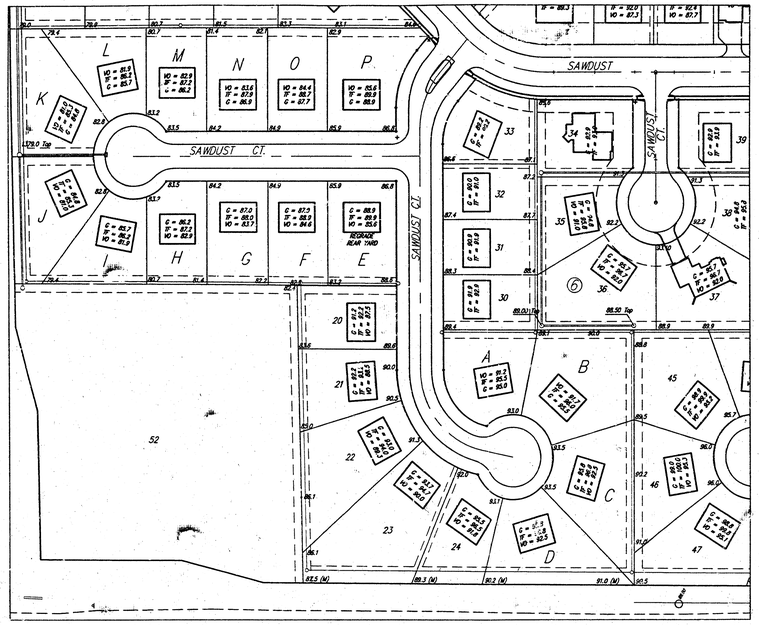

APPROVED
DRAINAGE PLAN

SCALE
1" = 80'

GRADING INDICATED ON THIS PLAN REVISED TO MATCH LOT LINE CHANGES RECORDED IN NOVEMBER 2002. GRADES ARE BASED ON THE ORIGINAL SUBDIVISION PLAN AND MAY NOT BEEN VERIFIED BY AN ASBUILT SURVEY.

KENNETH W. LEE
LICENSED
No. 19373
3/24/03
KANSAS
PROFESSIONAL ENGINEER

SAWMILL CREEK ADDITION
REVISED GRADING BLOCK 6
WICHITA, KANSAS

Ruggles & Bohm, P.A.
Engineering Surveying Land Planning
824 North Main
Wichita, Kansas 67203
(316) 264-5608
(316) 264-1421 fax
E-mail: info@rbkansas.com
www.rbkansas.com

DRAWN BY	KDL
CHECKED BY	KDL
SCALE	1" = 80'
DATE	Jan. 2003
DRAWING NO.	GRADING
PROJECT NUMBER	1
SHEET	1 of 1