


PRELIMINARY PLAT SCHLABACH ADDITION

WICHITA, SEDGWICK COUNTY, KANSAS

A tract in the East 15 Acres of the N.W. 1/4 of the N.W. 1/4 of Sec. 5, Twp. 27-S, R-1-E, described as beginning 427 feet South of the N.E. Corner of said 15 Acres; thence South along the East line of said 15 Acres, 412.49 feet; thence West parallel with the North line of said 15 Acres, 438.5 feet to the West line of said 15 Acres; thence North 412.49 feet; thence East 438.5 feet to beginning.


DEAN SCHLABACH & J. SCHLABACH
2919 WOODLAND
WICHITA, KS 67204
PH: 264-0451

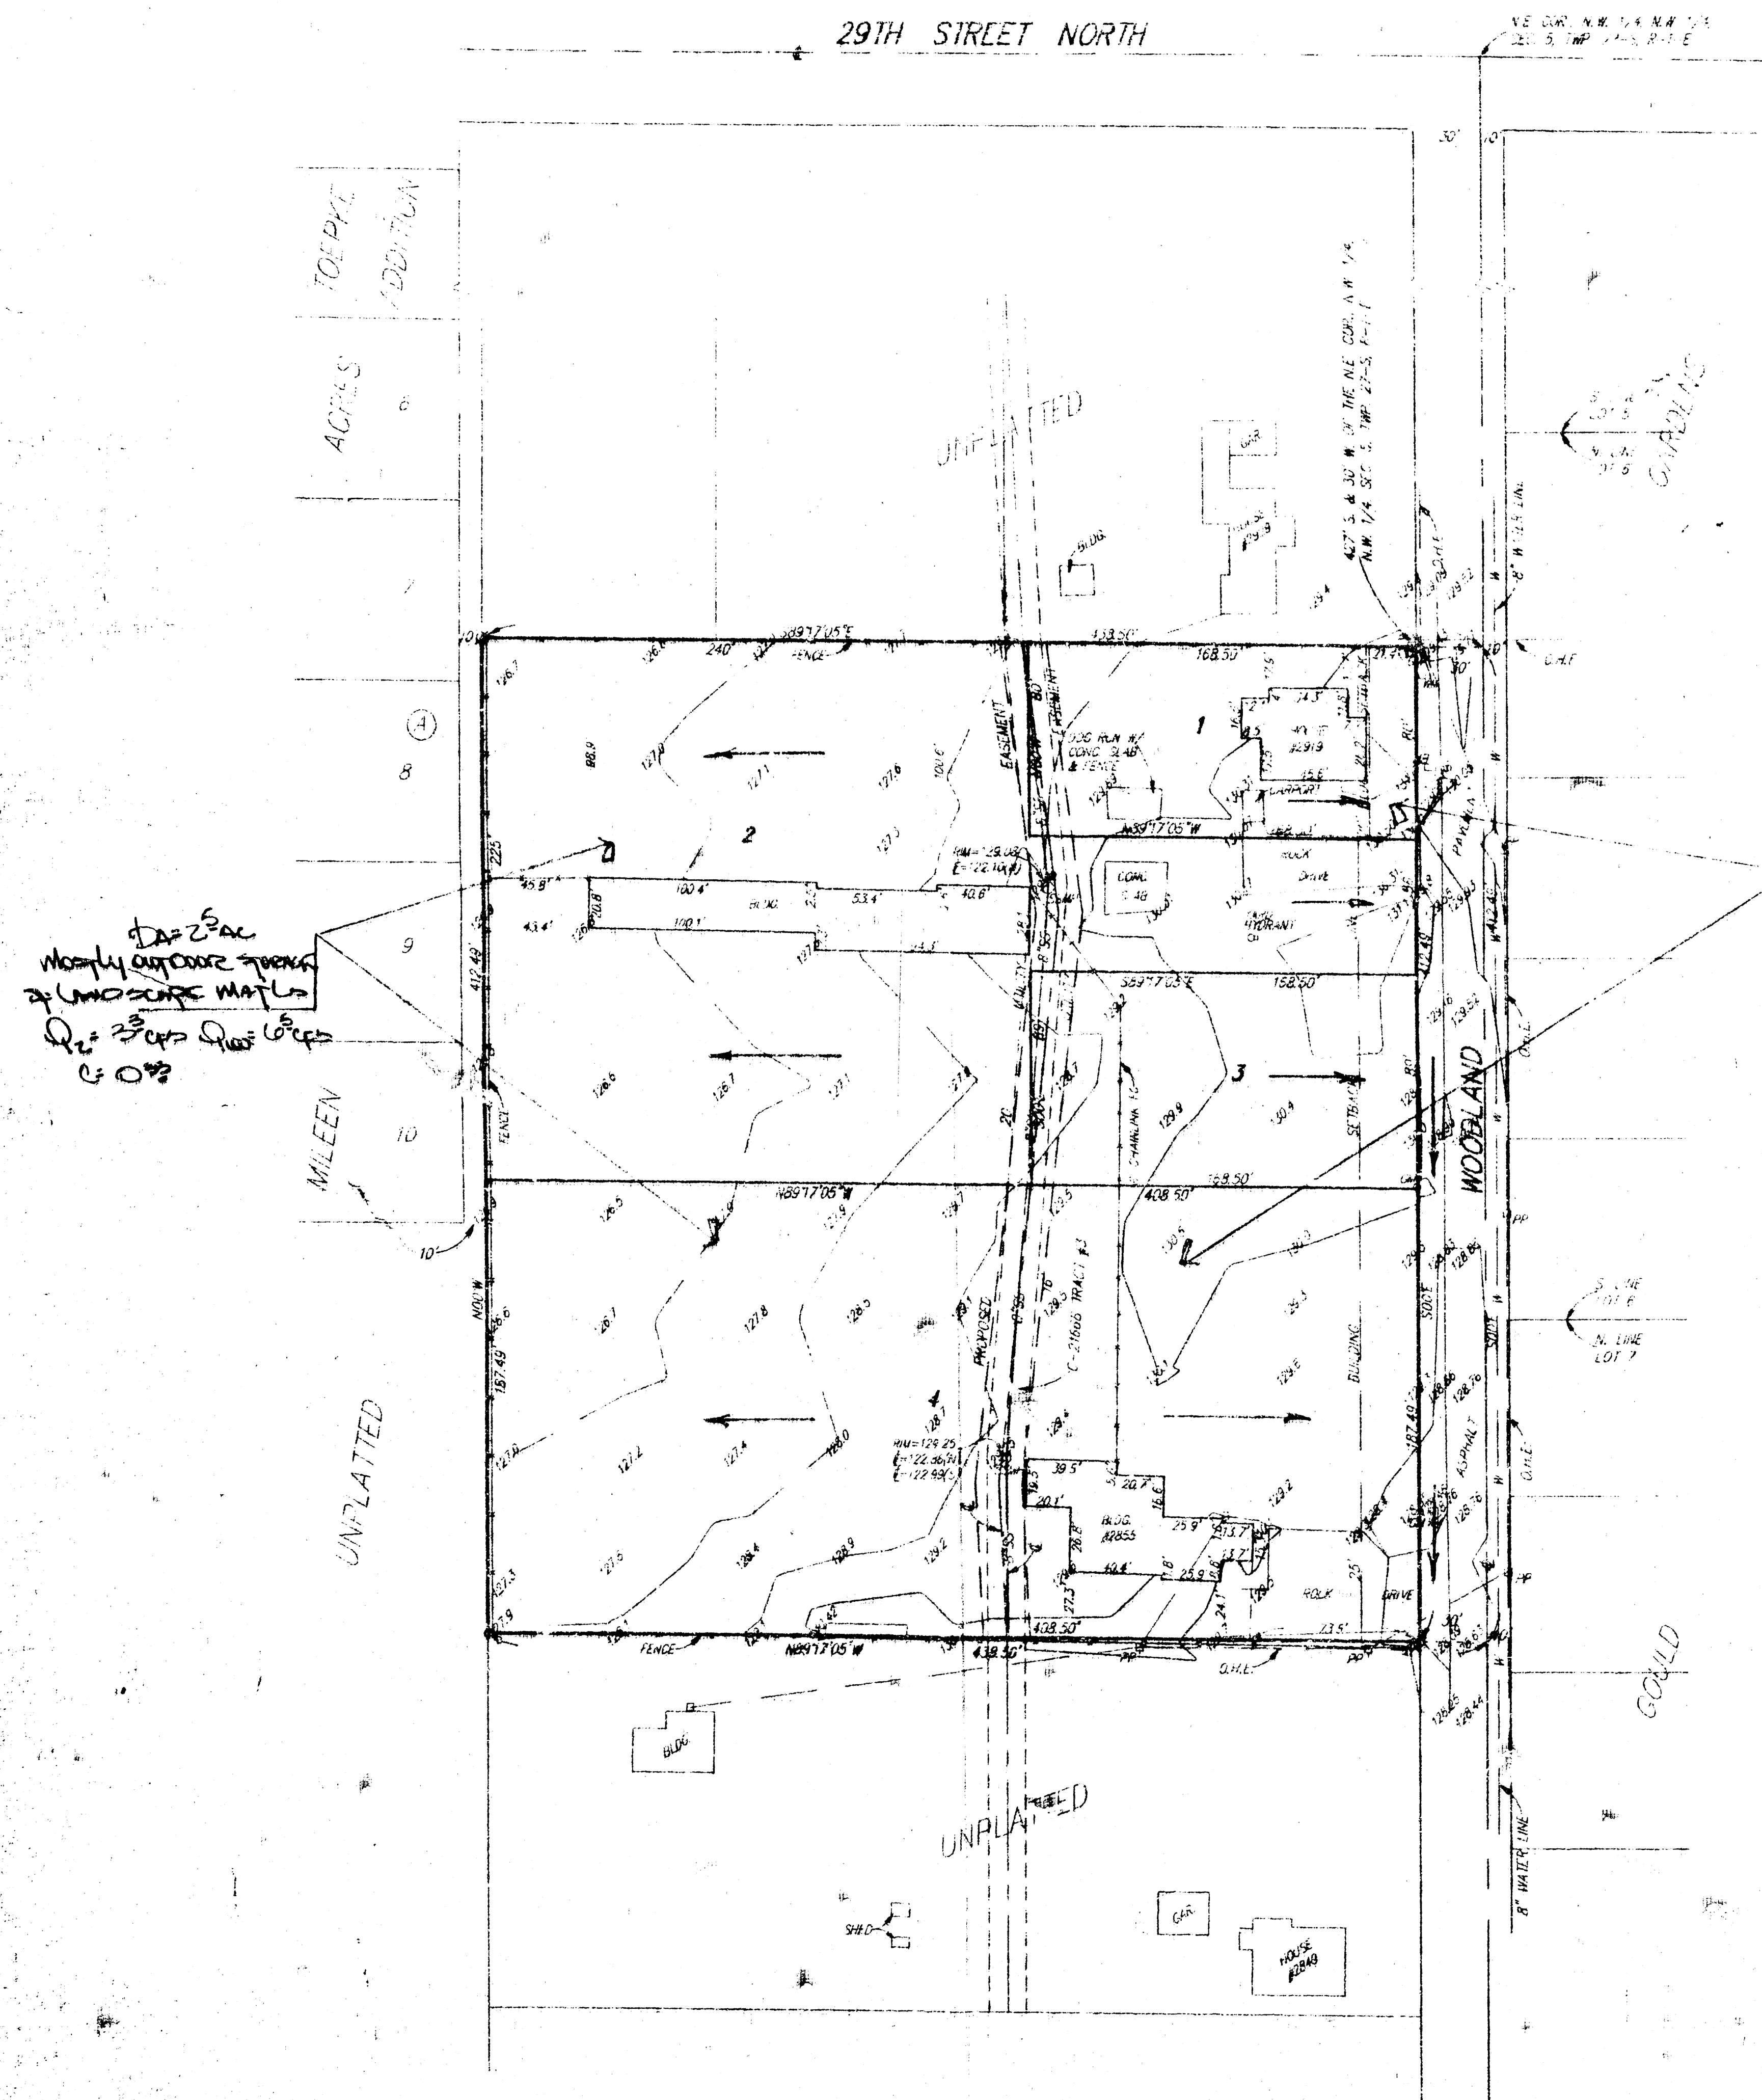




1" = 50'
• = 1/2" REBAR w/ "BAUGHMAN" CAP (SET)
O = 3/4" RUN (FOUND)
X = 1" RUN (FOUND)
FOUND CORNERS ARE OF UNIDENTIFIED
ORIGIN UNLESS IDENTIFIED ON SHEET
BEARING BASE = ASSUMED
BENCHMARK
N.B. 5/8" x 8" P.P. 1/2" x 1/2" (WOODRAID AND
40.2' S. & 29TH STREET NORTH
21.5' - 21.5' (21.5' DATUM)

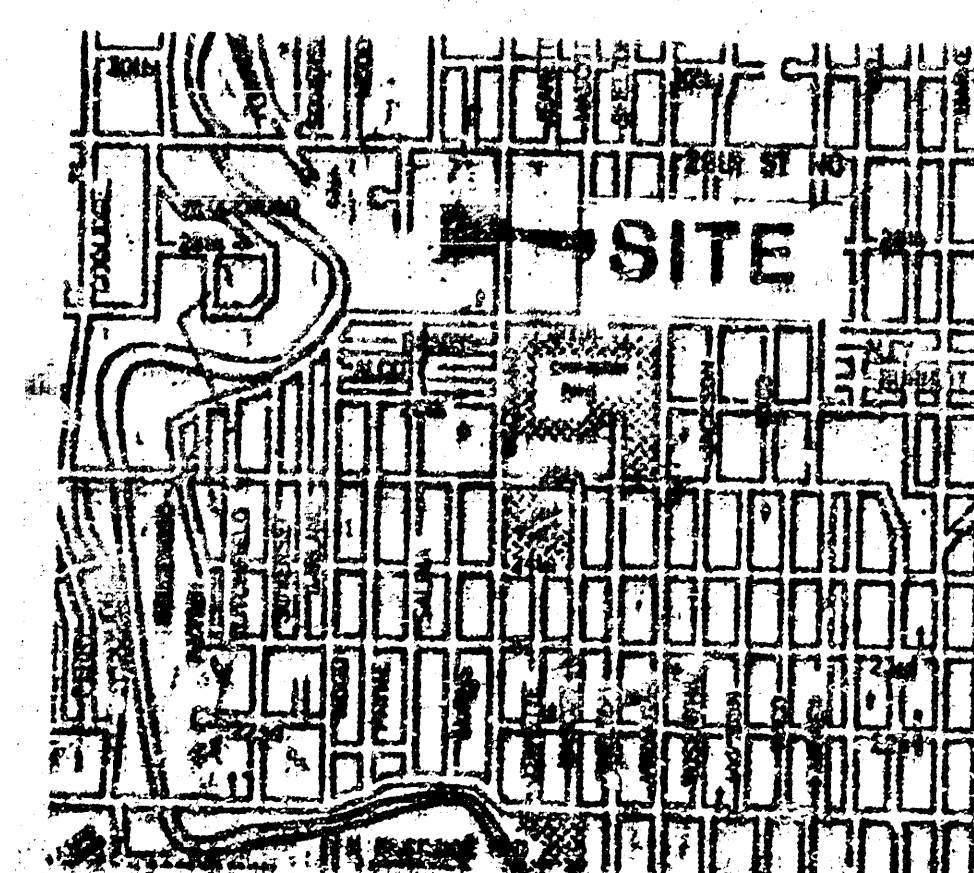


Vicinity Map

Off-site drainage agreement

GENERAL DRAINAGE PLAN NOTES -

The proposed four lot plat drains partially to Woodland but the majority of the site presently drains to the west across other existing large acre parcels. As the lots develop in the future, each lot will need to maintain its drainage and fill such that no additional runoff is directed onto the neighboring lots in an adverse form.
Presently, the majority of the westerly portion of the plat is operating as a landscaping storage facility which maintains its own drainage without any runoff onto the parcels west of this plat.

DRAINAGE PLAN

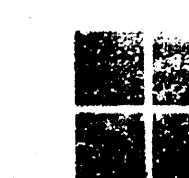

BAUGHMAN COMPANY P. A.
SURVEYING & ENGINEERING

316/262-7271 • 315 ELLIS • WICHITA, KANSAS 67201

15 MAR 1993