


STERLING FARMS 6TH ADDITION TO WICHITA, SEDGWICK COUNTY, KANSAS DRAINAGE PLAN

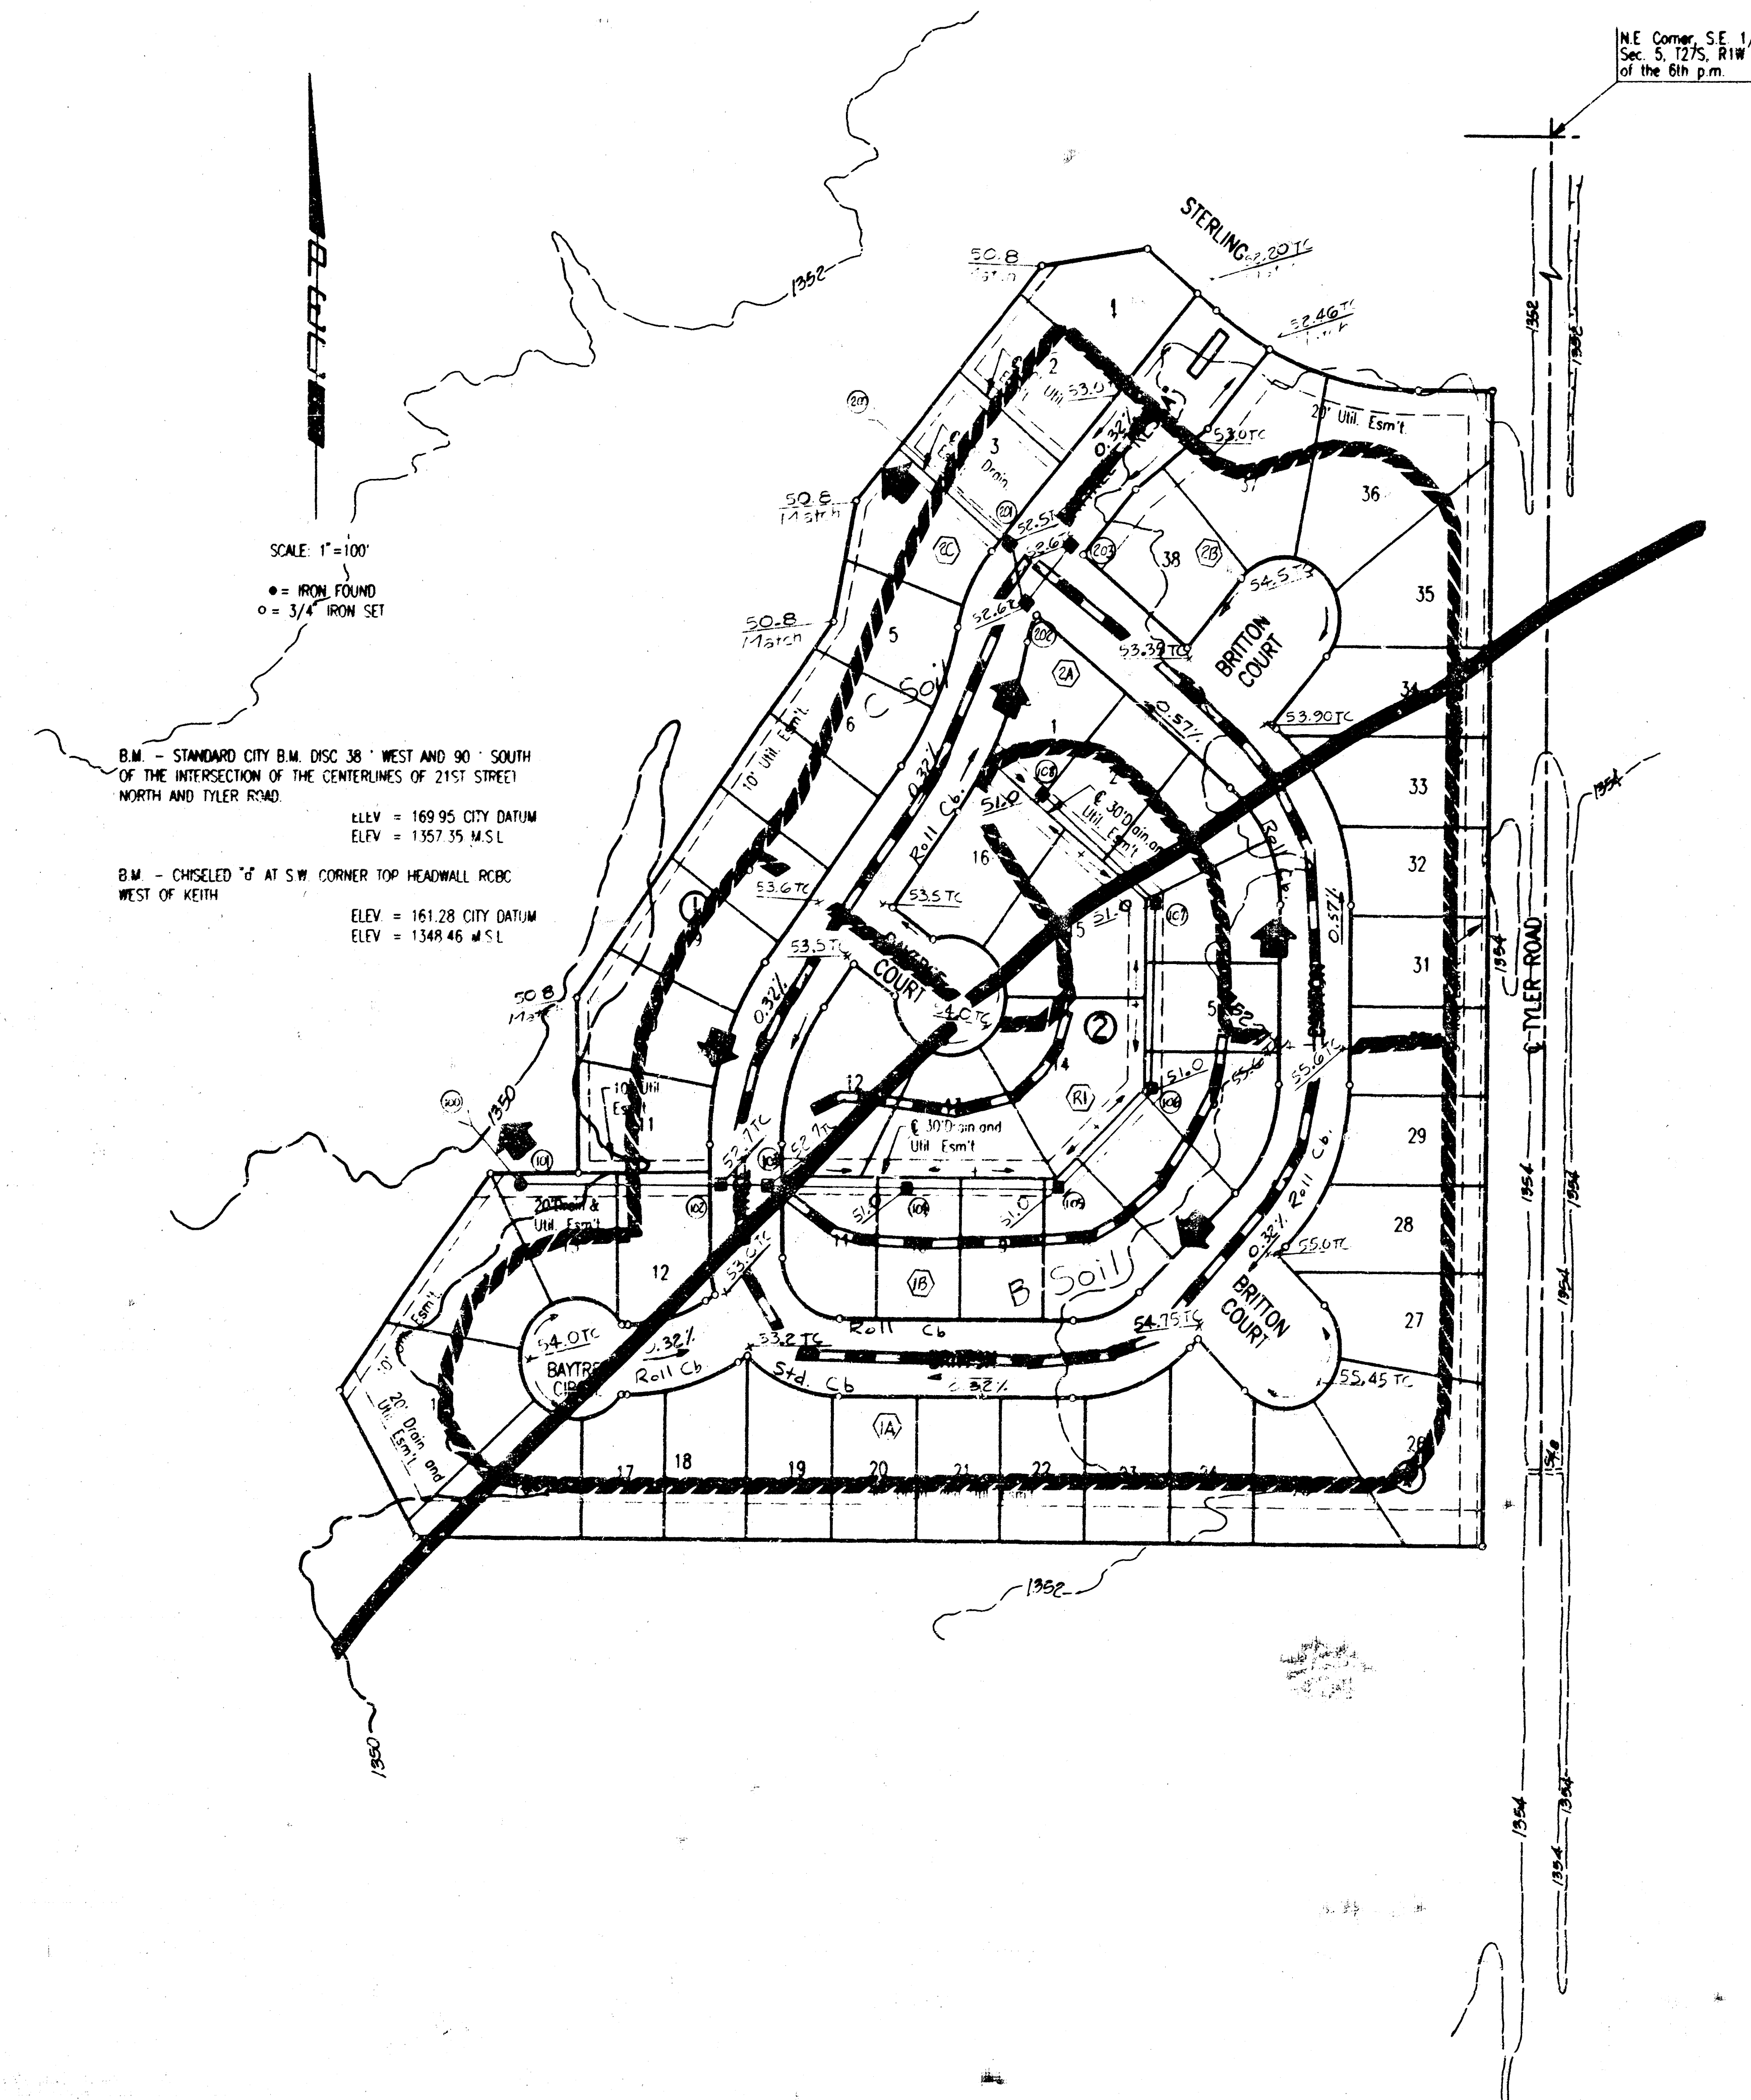

STERLING FARMS 6TH ADDITION TO WICHITA, SEDGWICK COUNTY, KANSAS FOUR CORNER LOT GRADING

