



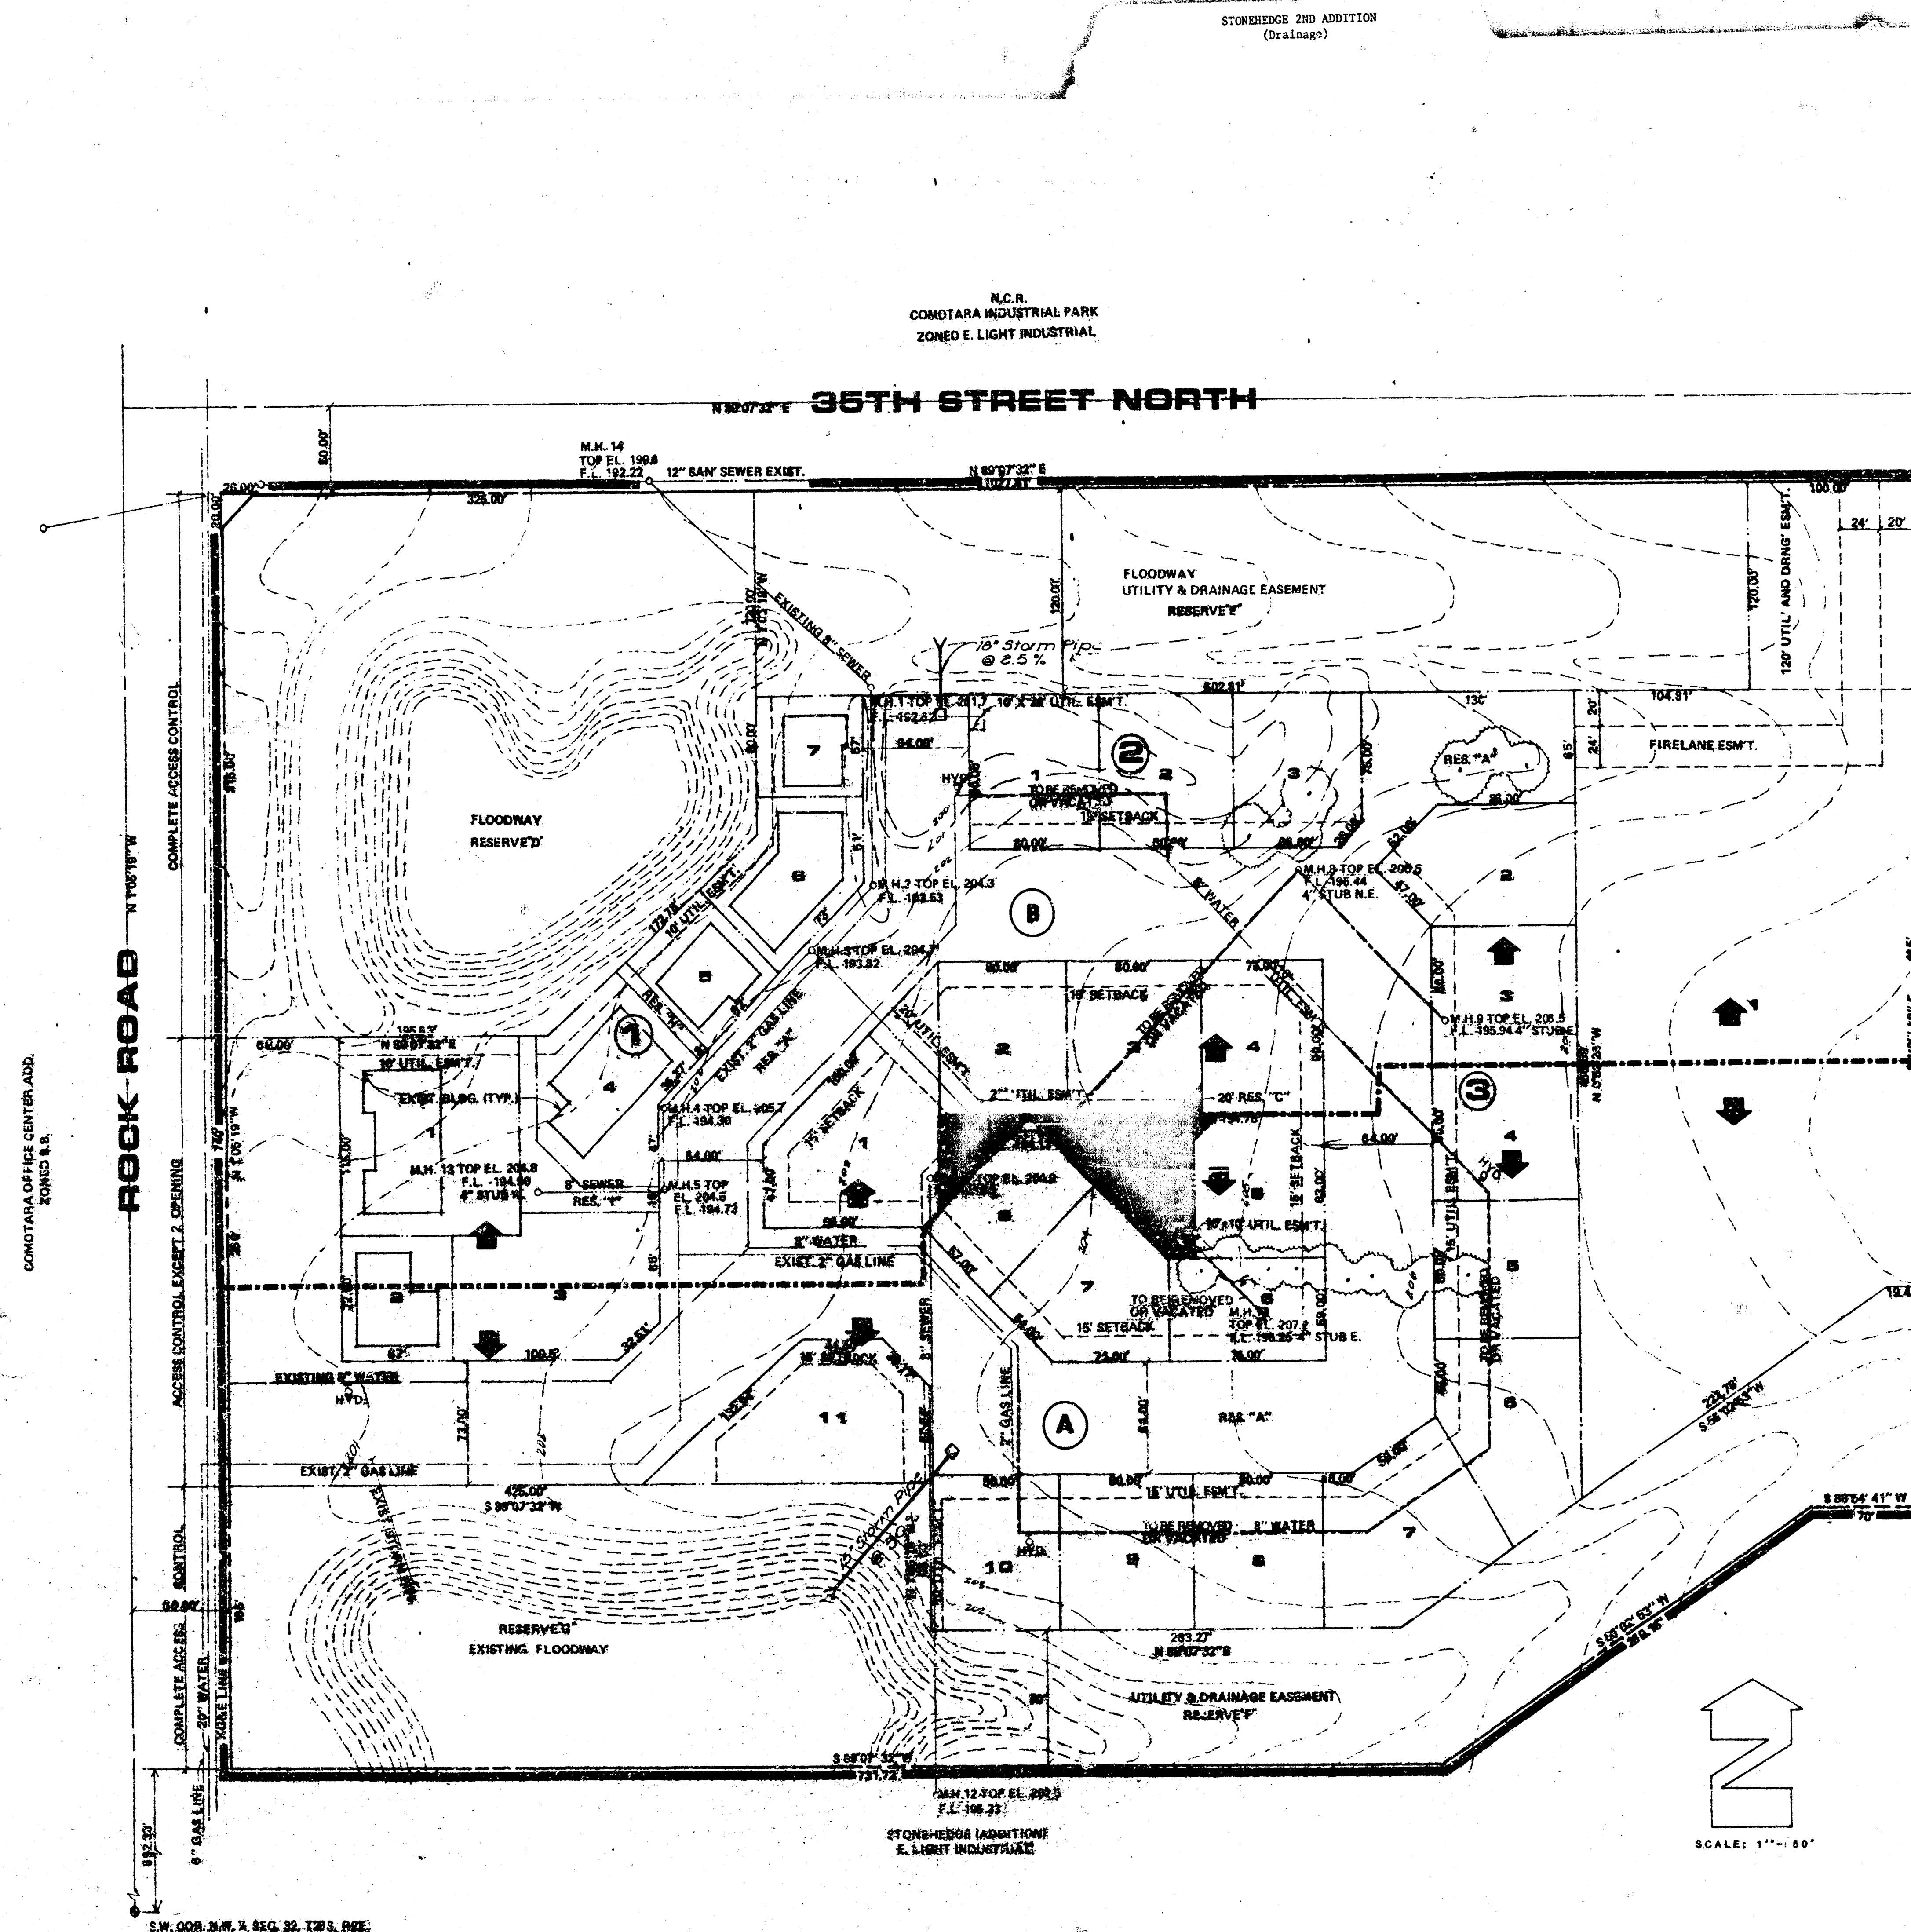

NOTES:

1. RESERVE "A" IS AN ACCESS ESM.T. FOR THE USE OF SIDEWALKS, FIRELANES, CONSTRUCTION AND MAINTENANCE OF PUBLIC UTILITIES, PARKING, OPEN SPACE, AND PRIVATE DRIVES.
 2. RESERVE "B", "C", "H", & "I" ARE FOR UTILITIES, DRAINAGE, OPEN SPACE, LANDSCAPING AND IRRIGATION SYSTEMS.
 3. RESERVE "D" & "G" ARE PLATTED FOR FLOODWAY PURPOSES.
 4. RESERVES "E" & "F" ARE PLATTED FOR FLOODWAY AND CONSTRUCTION AND MAINTENANCE OF PUBLIC UTILITIES.
- MINIMUM PAD ELEVATION 202.0, CITY OF WICHITA DATUM.
 R.M. R.R. SPIKE W. FACE OF POWER POLE 50' E. AND 15' S. OF THE CENTERLINE OF ROCK ROAD AND 35TH STREET NORTH ELEV. 196.82
 SEE SHEET 2 FOR DRAINAGE AND UTILITY CONCEPT

COMOTARA INDUSTRIAL PARK 2ND ADDITION
 E. LIGHT INDUSTRIAL

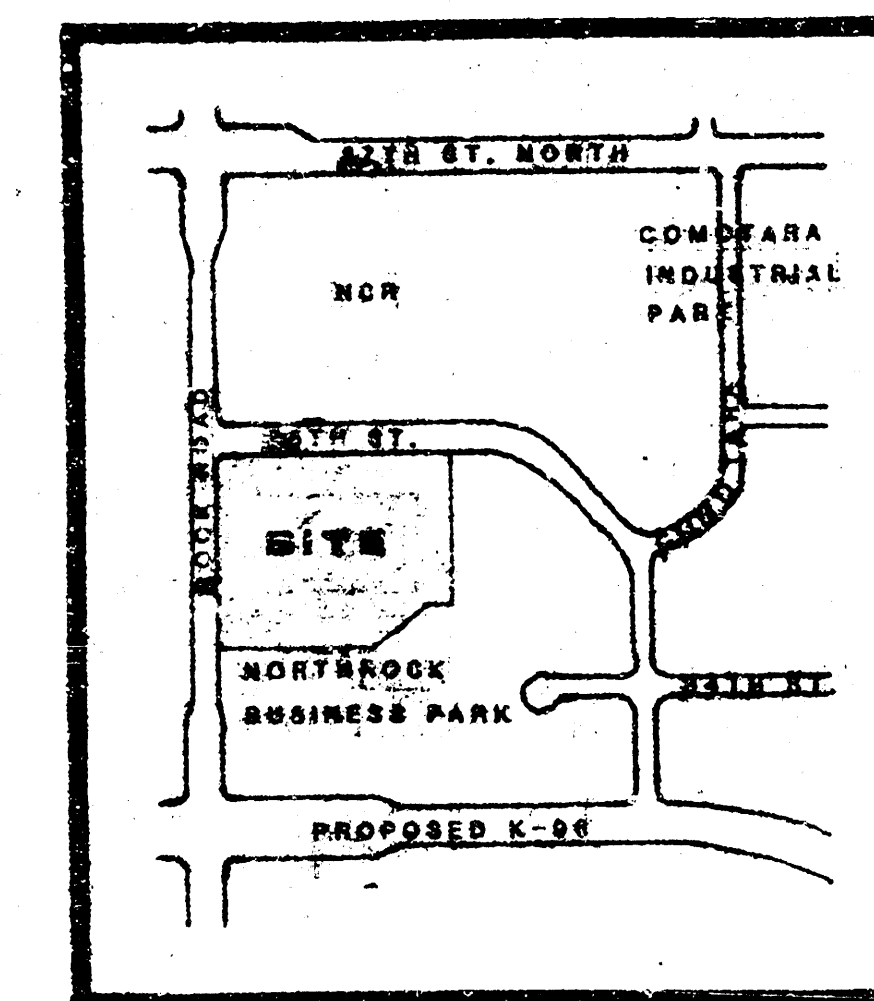

LOCATION MAP

DRAINAGE AND UTILITY PLAN

STONEHEDGE ADDITION (2ND)

SHEET 1

BILL G. YUNG DESIGN
 8225 E. 35TH ST. NORTH, WICHITA, KS. 67226
 316-643-1111

project
 STONEHEDGE 2ND ADDITION

sheet
 1

of
 2

date
 rev.

NOV. 13, 1994
 NOV. 20, 1994
 NOV. 20, 1994

sheet title
 PRELIMINARY PLAN