

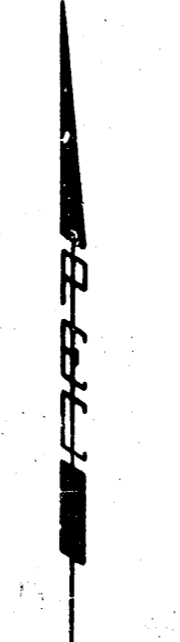


AREA MAP OF
SUMMERFIELD 3RD ADDITION

OWNERS: DONALD C. AND JUDITH A. SLAWSON
 104 S. BROADWAY
 SUITE 200
 WICHITA, KANSAS 67202
 ENGINEER: PROFESSIONAL ENGINEERING CONSULTANTS, P.A.
 303 S. TOPEKA
 WICHITA, KANSAS 67202

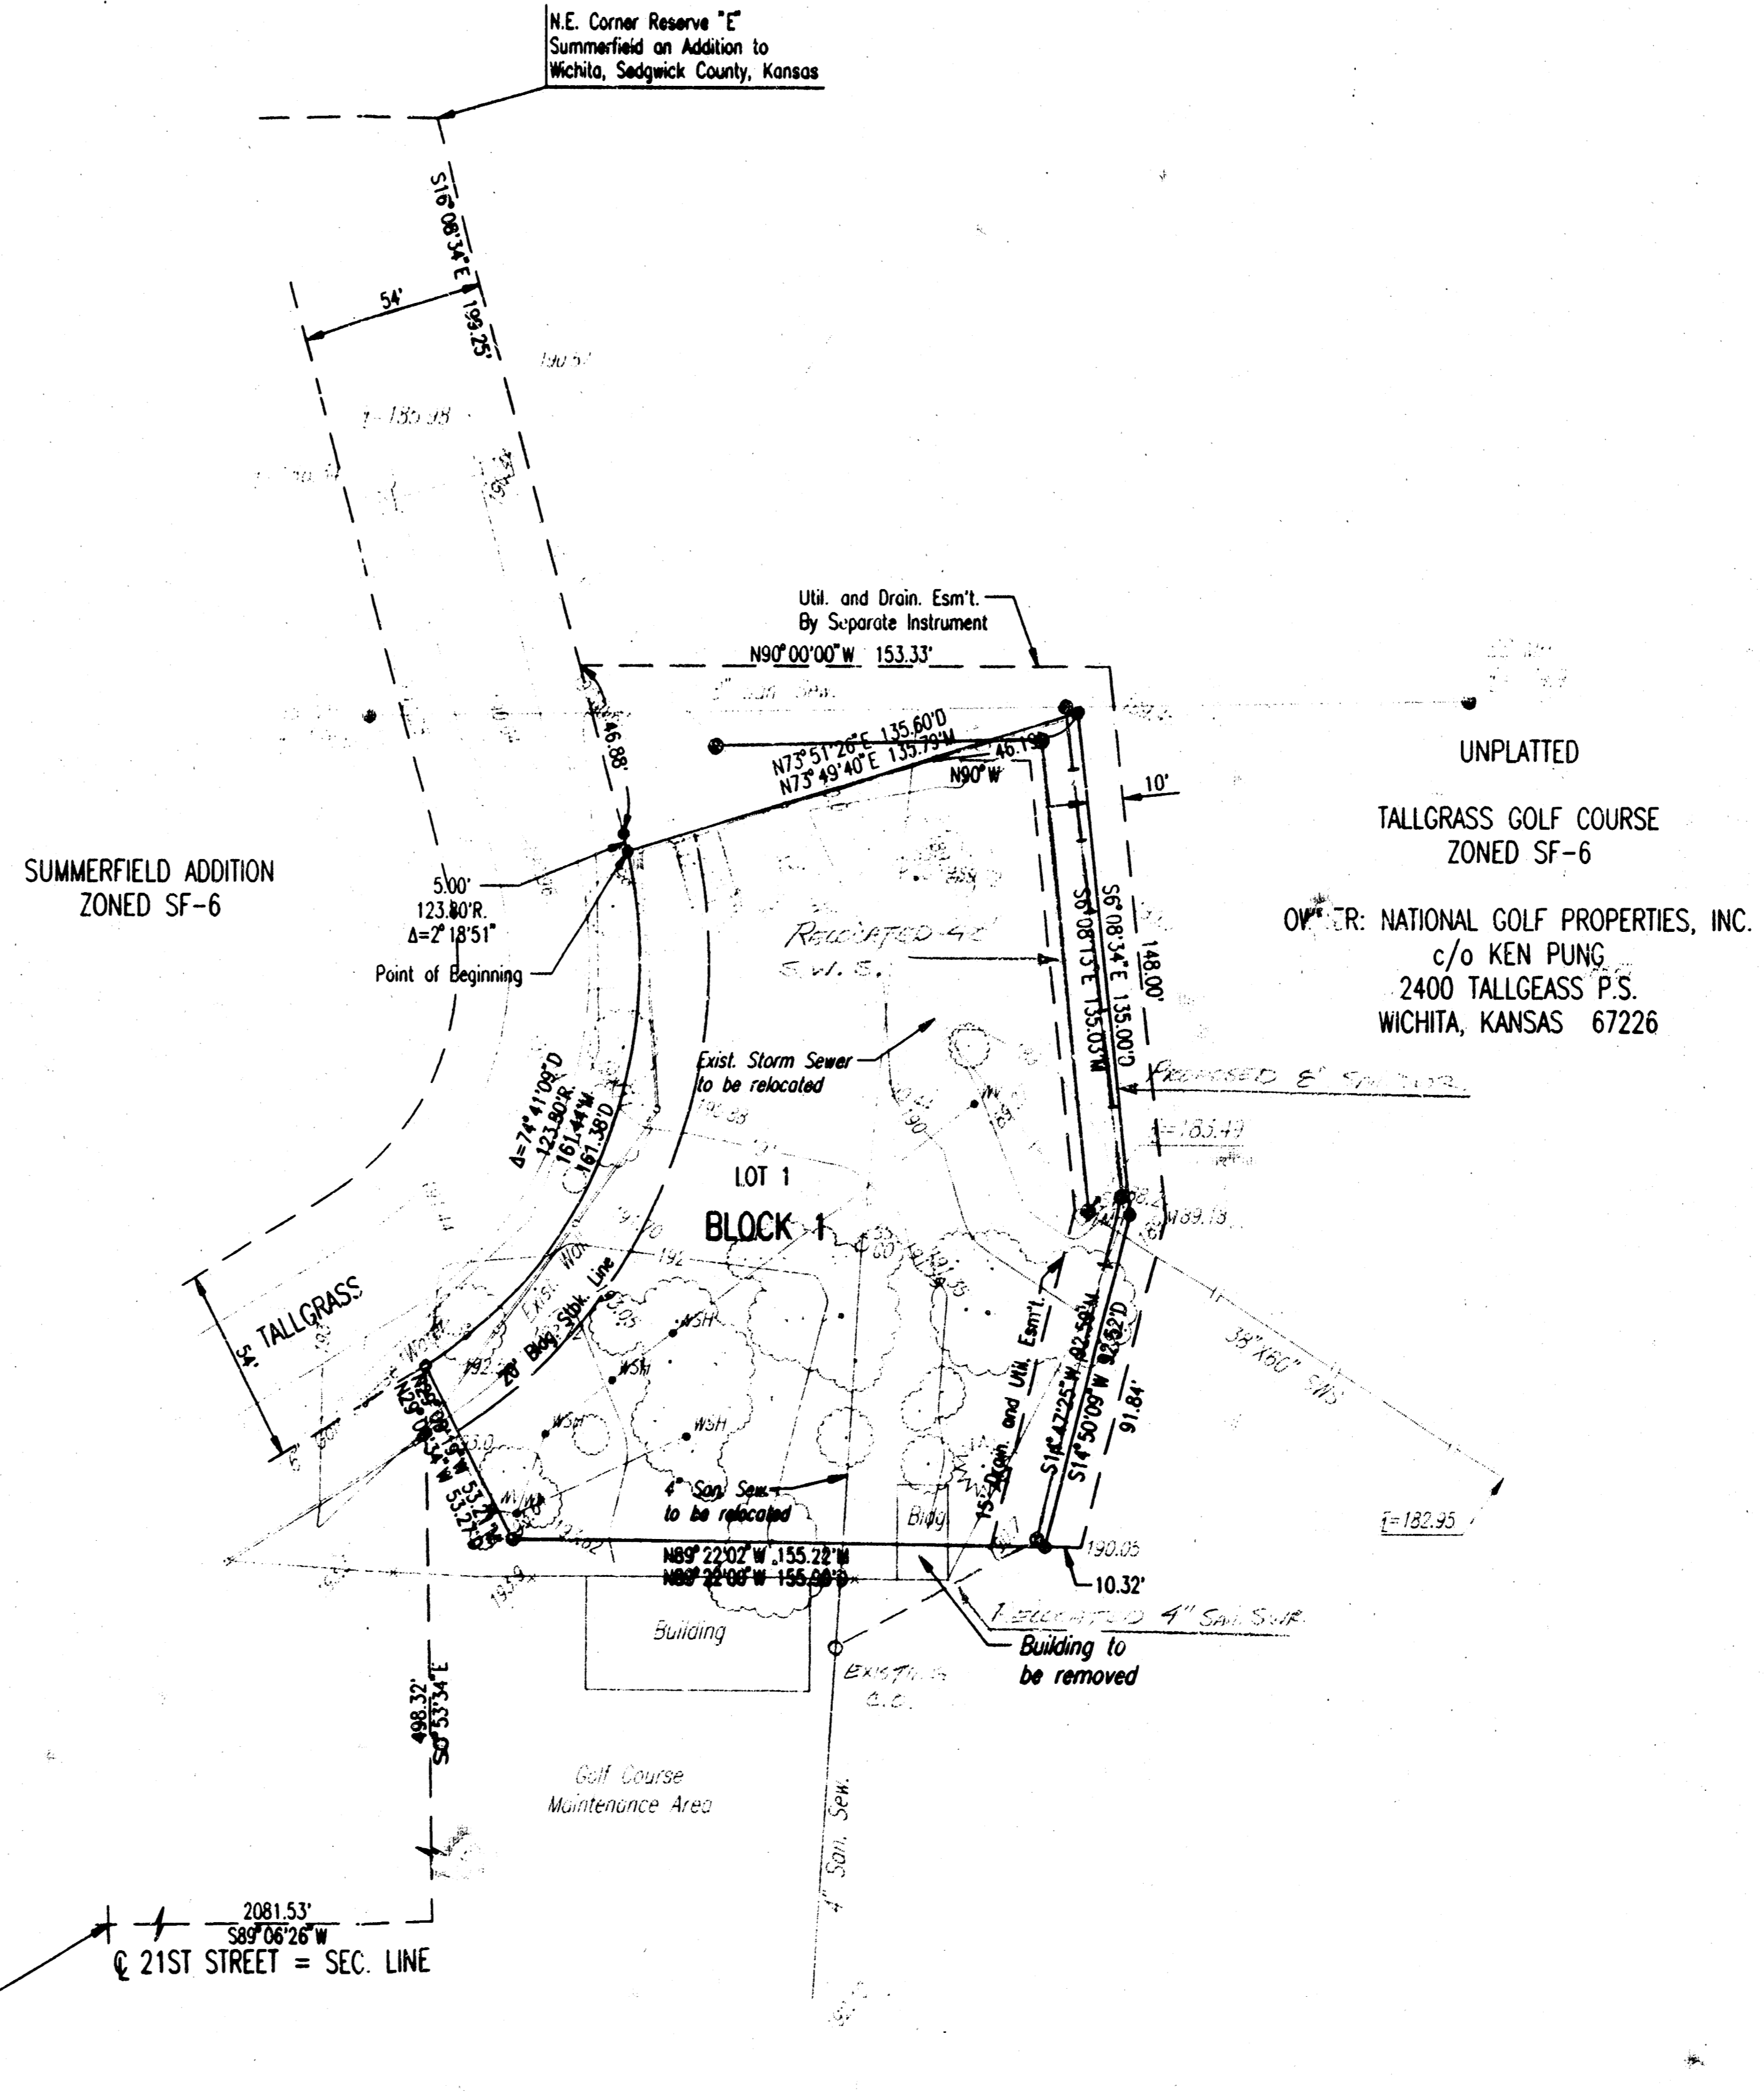

SCALE: 1"=40'
 NOVEMBER, 1996
 ● = IRON FOUND
 M=MEASURED DISTANCE AND BEARING
 D=DEEDED DISTANCE AND BEARING
 TOPOGRAPHY BY ARMSTRONG LAND SURVEY, P.A. MAY, 1996
 B.M. - CITY OF WICHITA BENCH MARK DISC, 45' NORTH AND 48' EAST
 OF THE CENTERLINES OF ROCK ROAD AND 21ST STREET NORTH.
 ELEV.=214.588
 B.M. - CITY OF WICHITA BENCH MARK DISC, 44' SOUTH AND 48' EAST
 OF THE CENTERLINES OF WEBB ROAD AND 21ST STREET NORTH.
 ELEV.=205.238

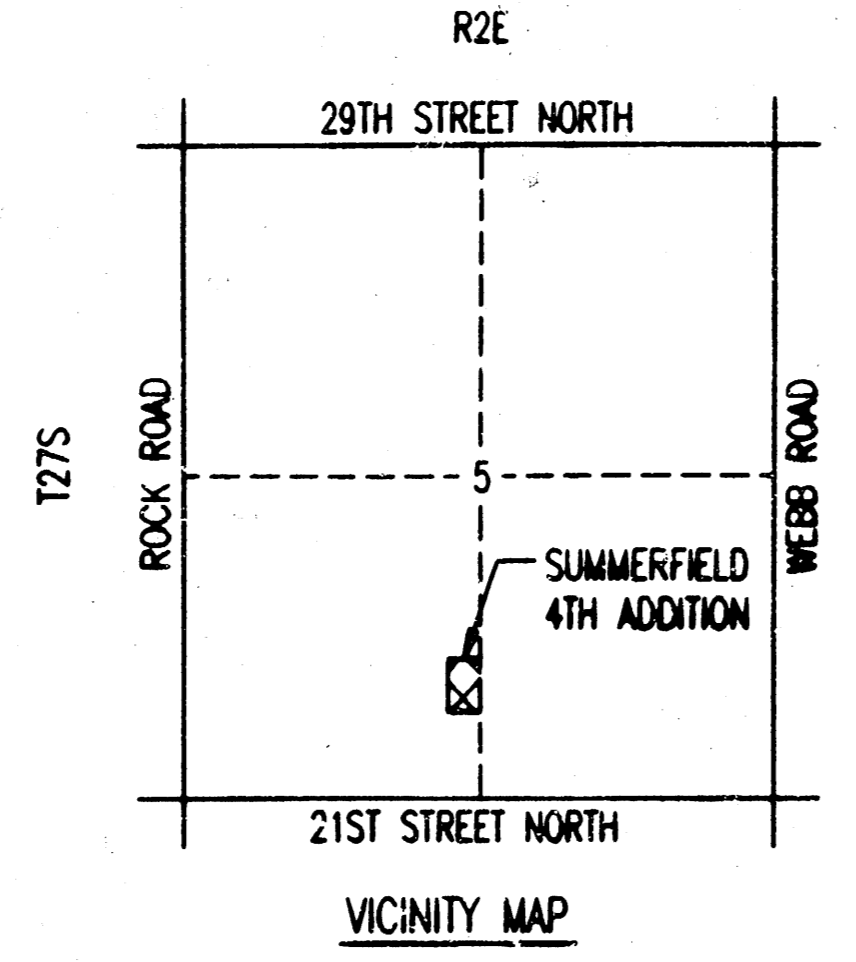

DSR: SANCHEZ OPER: DEP SCALE: 1"=40.00
 G: 11/05/96 06:23:43 ARZ:ARZ:DMC 10-31-1996 11:00:13 am