


DRAINAGE PLAN

TIMBER GROVE LAKES COMMERCIAL ADDITION

WICHITA, KANSAS

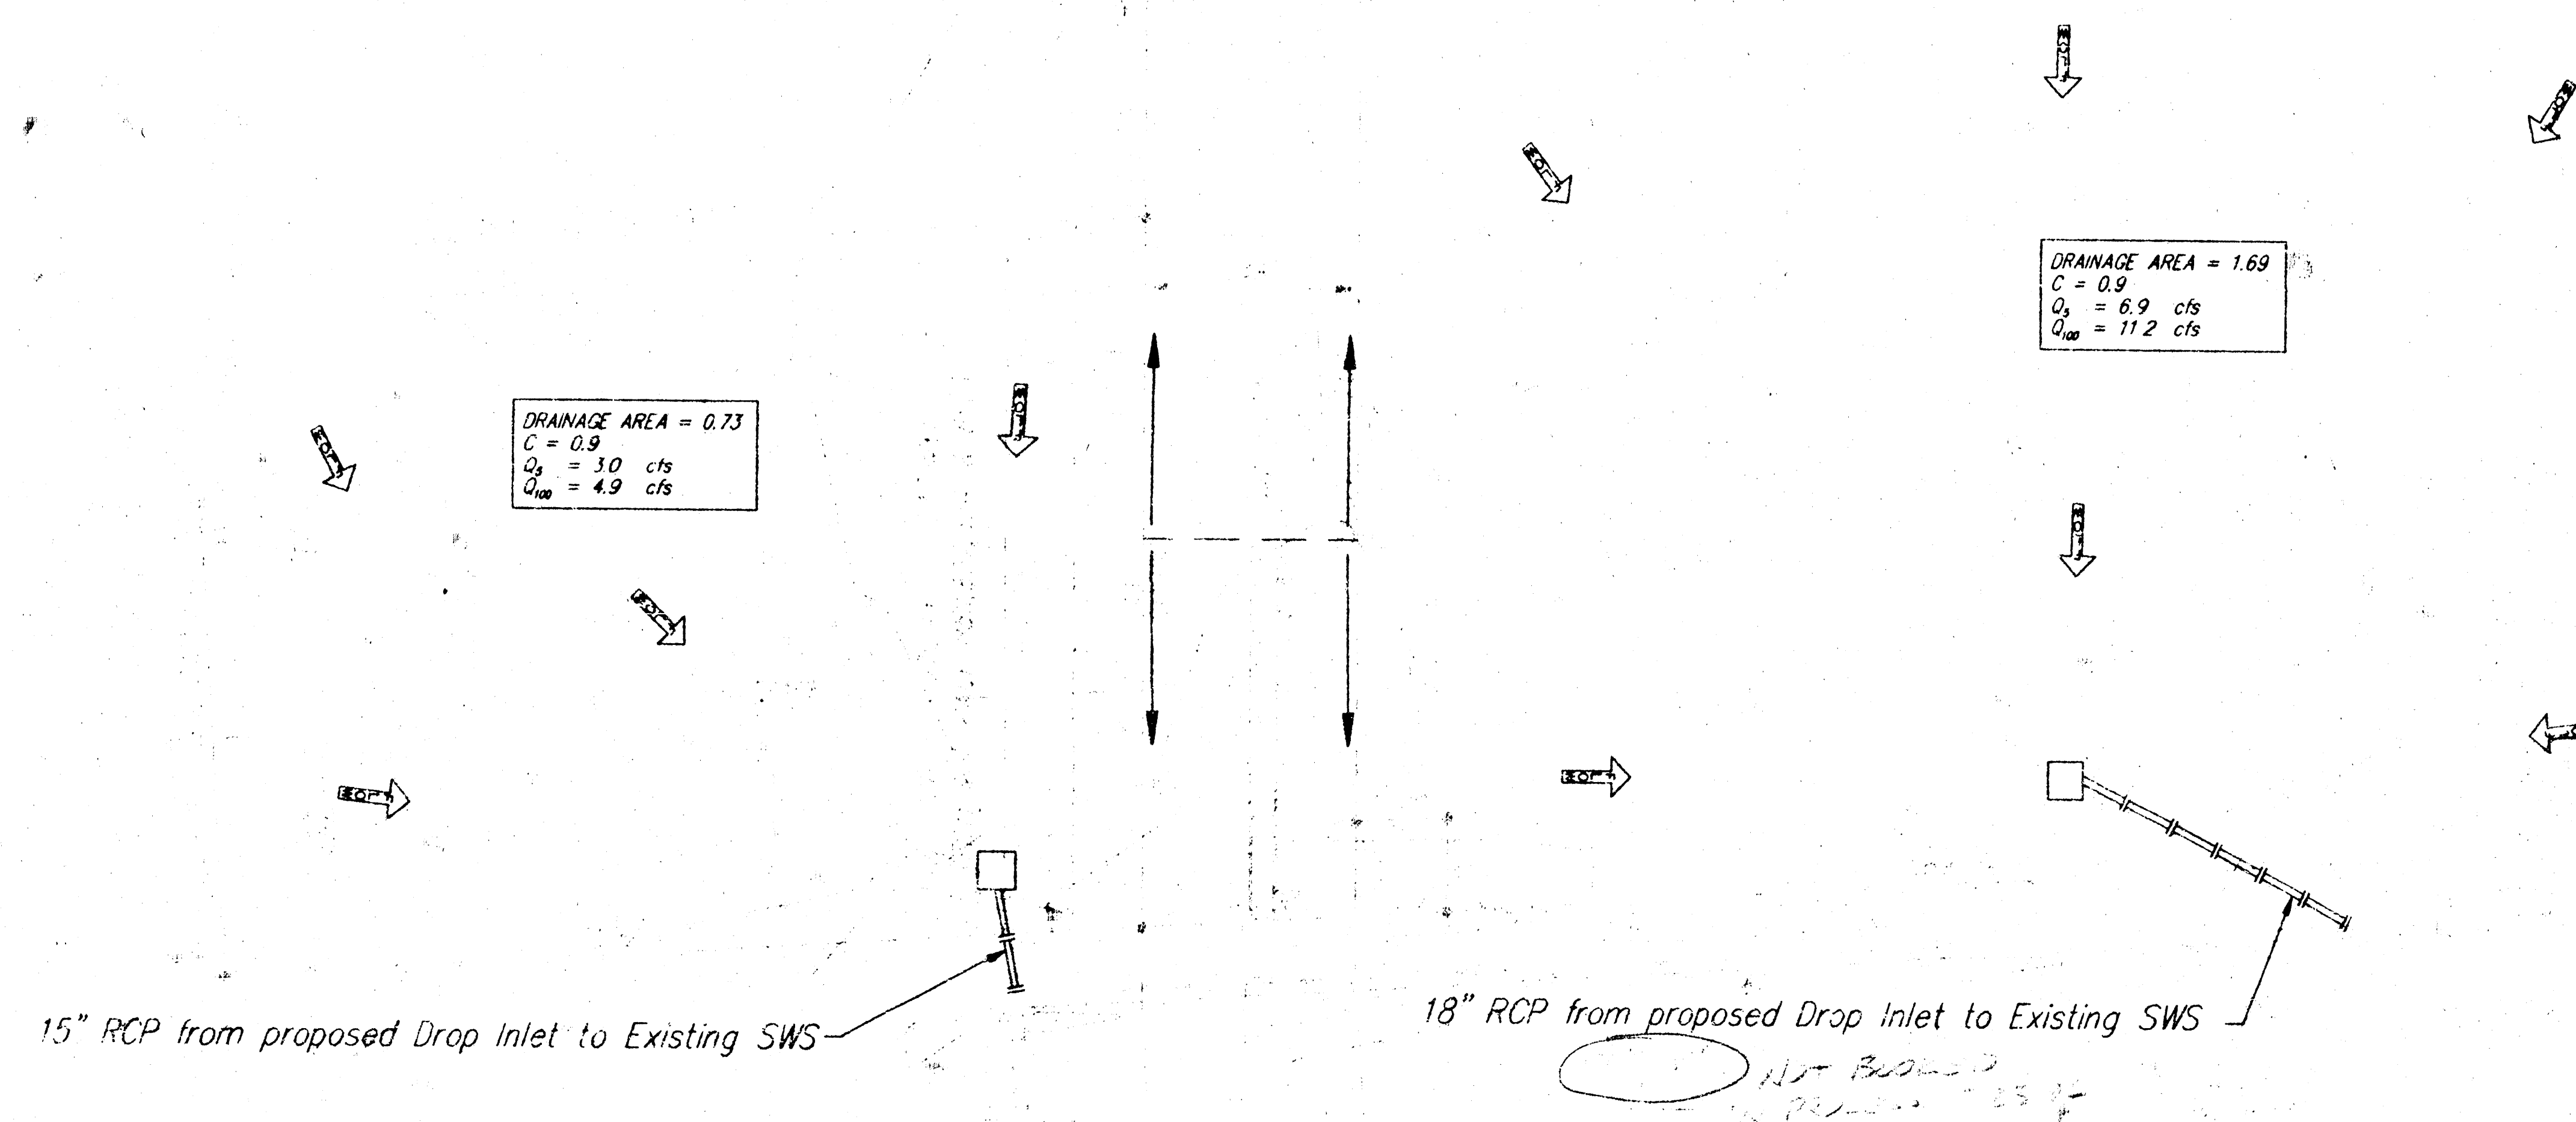

MINIMUM BUILDING PAD ELEVATIONS
FOR LOWEST OPENING OF STRUCTURE

Lot & Block	Elevation	
	City Datum	M.S.L.
1 - BLK A	141.6	1329.0
2 - BLK A	141.6	1329.0

BENCH MARK: City disc located on the
N.E. Corner of Central
and Maize in island.
Elev. - 146.00 (city datum)

Scale: 1" = 30'

- = 1/2" REBAR W/ "BAUGHMAN" CAP (SET)
- ⊗ = CROSS CUT (FOUND)
- = 1/2" IRON (FOUND)

TIMBER GROVE LAKES COMMERCIAL ADDITION			
DRAINAGE PLAN			
BAUGHMAN+ COMPANY P.A. ENGINEERING & SURVEYING 310.267-7271 • 310 ELLIS • WICHITA, KANSAS 67201			
PROJECT NUMBER			
DESIGN	DRAWN	DATE	SCALE
JOS	JOS	May 7, 1994	1" = 30'
SHEET			1