


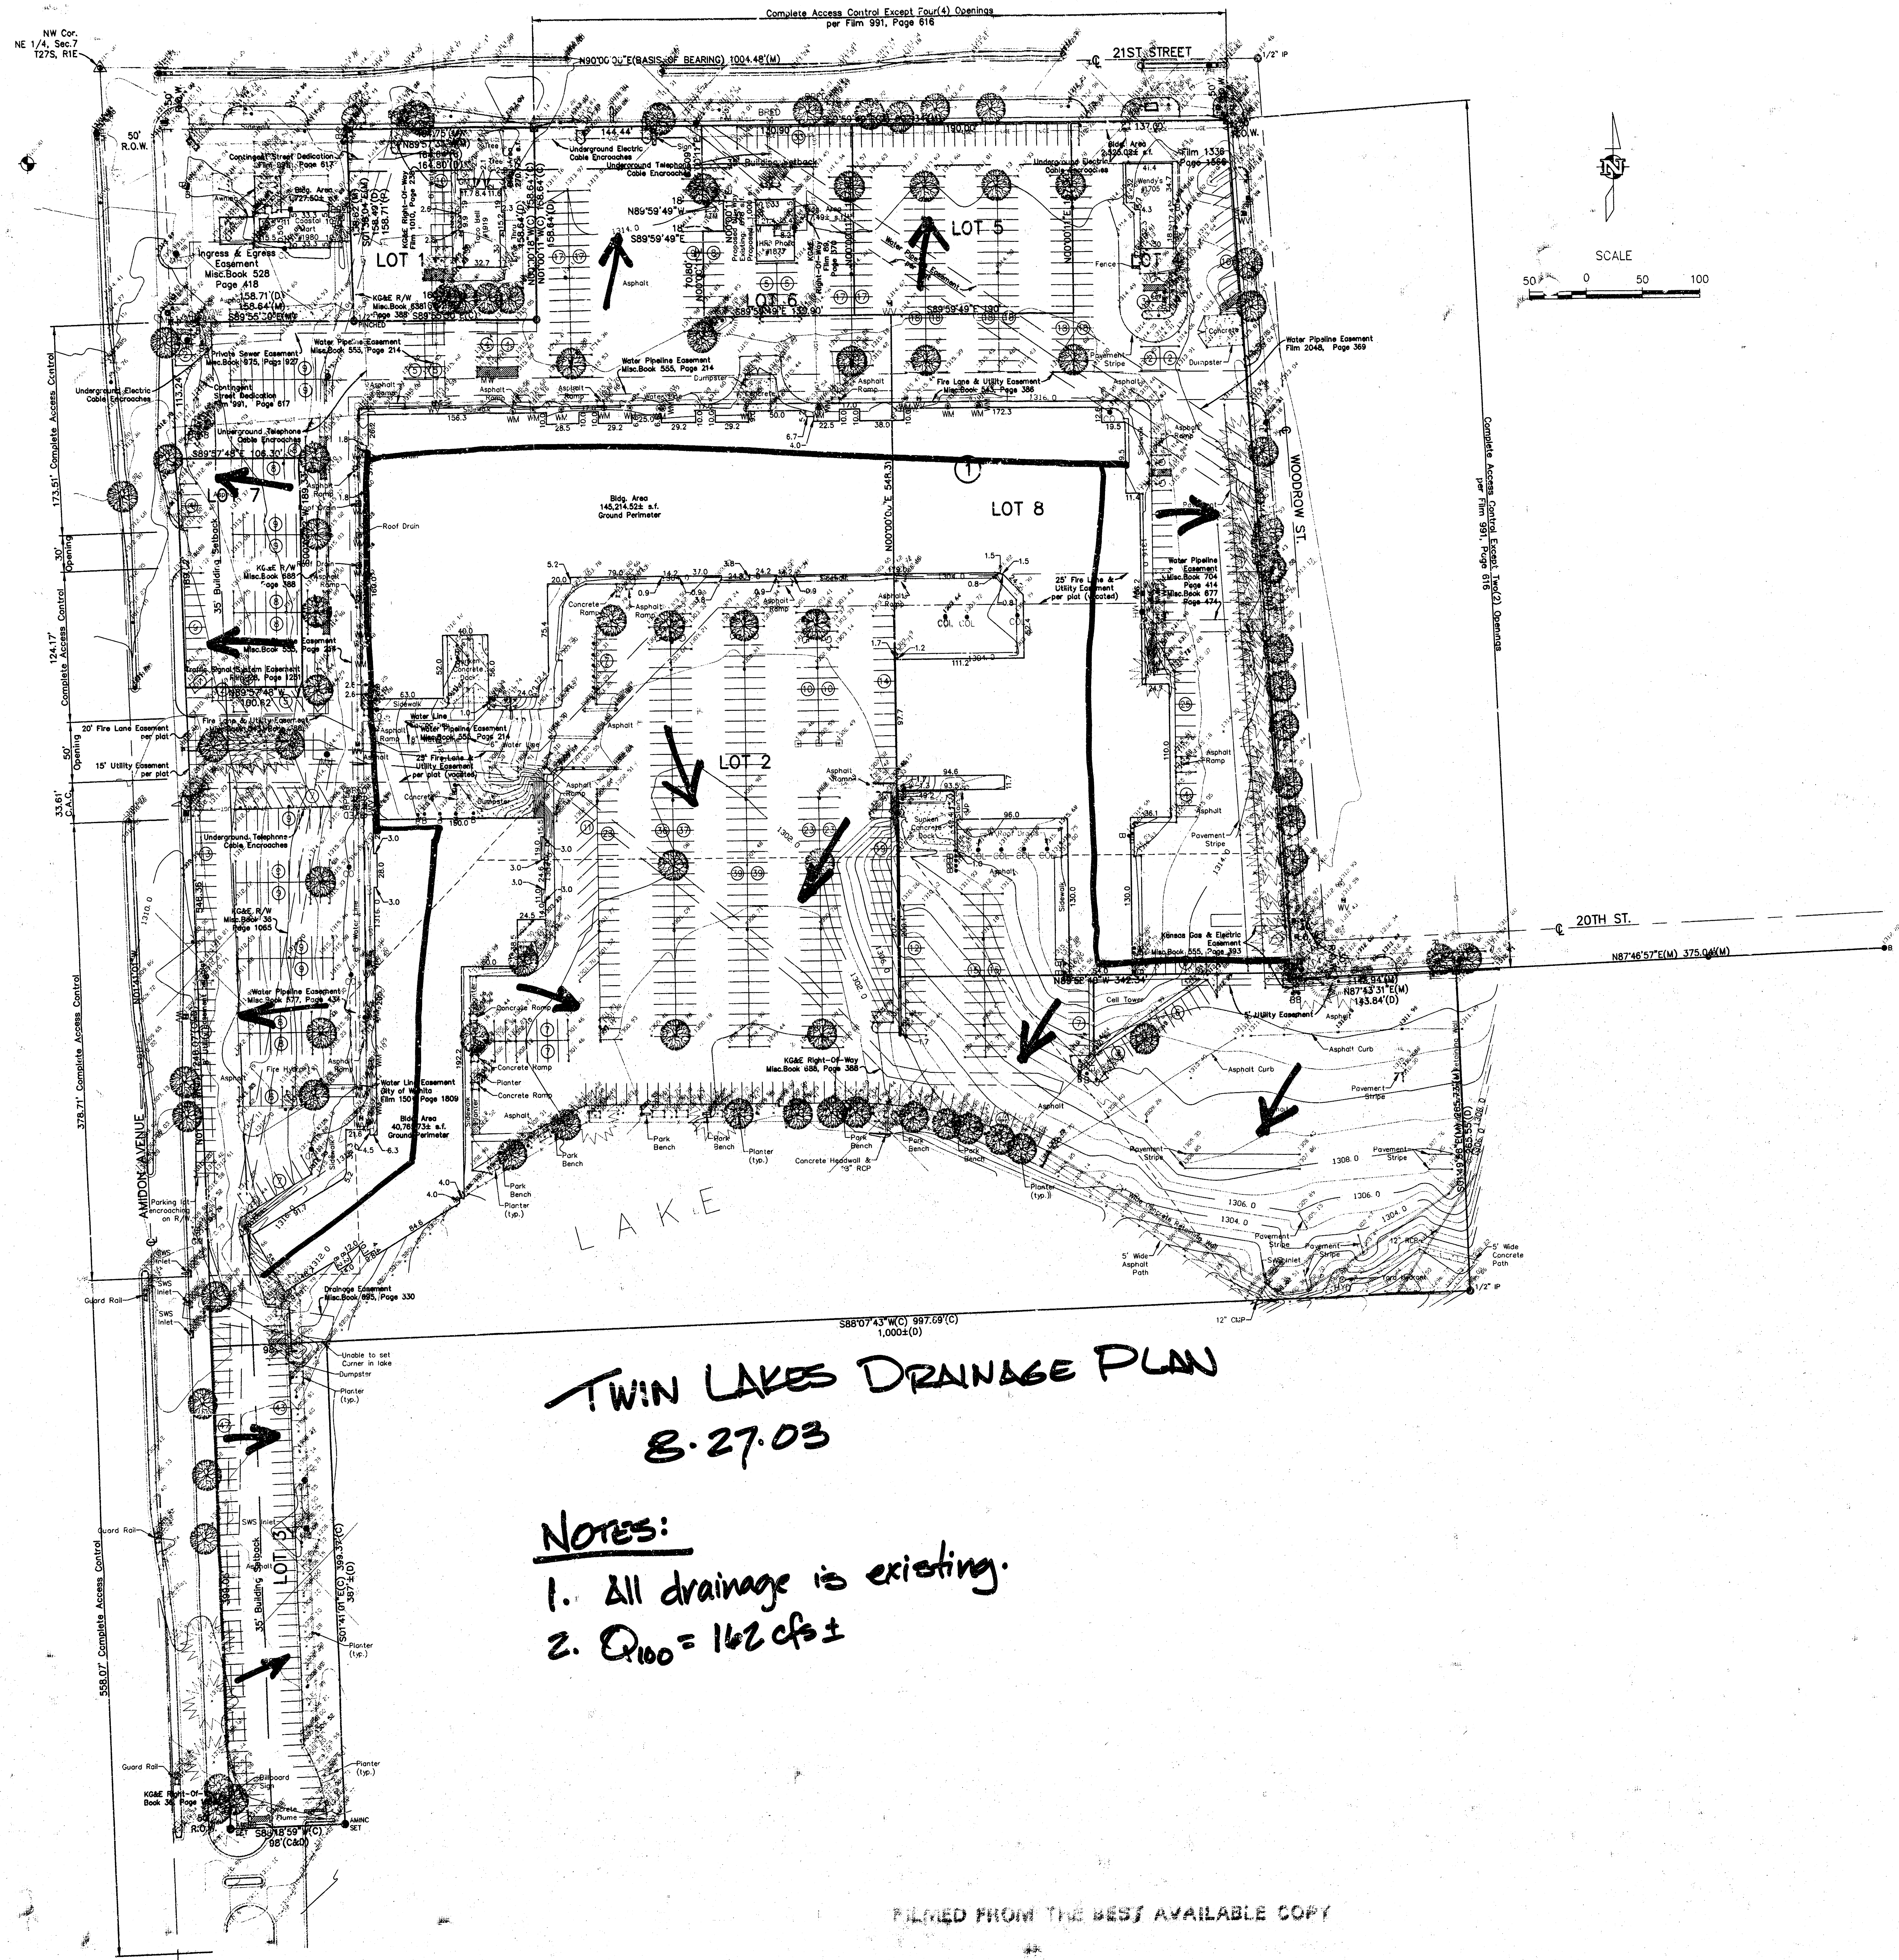

TWIN LAKES DRAINAGE PLAN 8.27.03

NOTES:

1. All drainage is existing.
2. $Q_{100} = 162 \text{ cfs} \pm$