


SKETCH PLAT
VENTURE PARK ADDITION

PART OF THE NW¼ OF SEC 20, TWP. 27-S, R-2-E OF THE 6TH
PM, SEDGWICK COUNTY, KANSAS

FRANK L. CARNEY


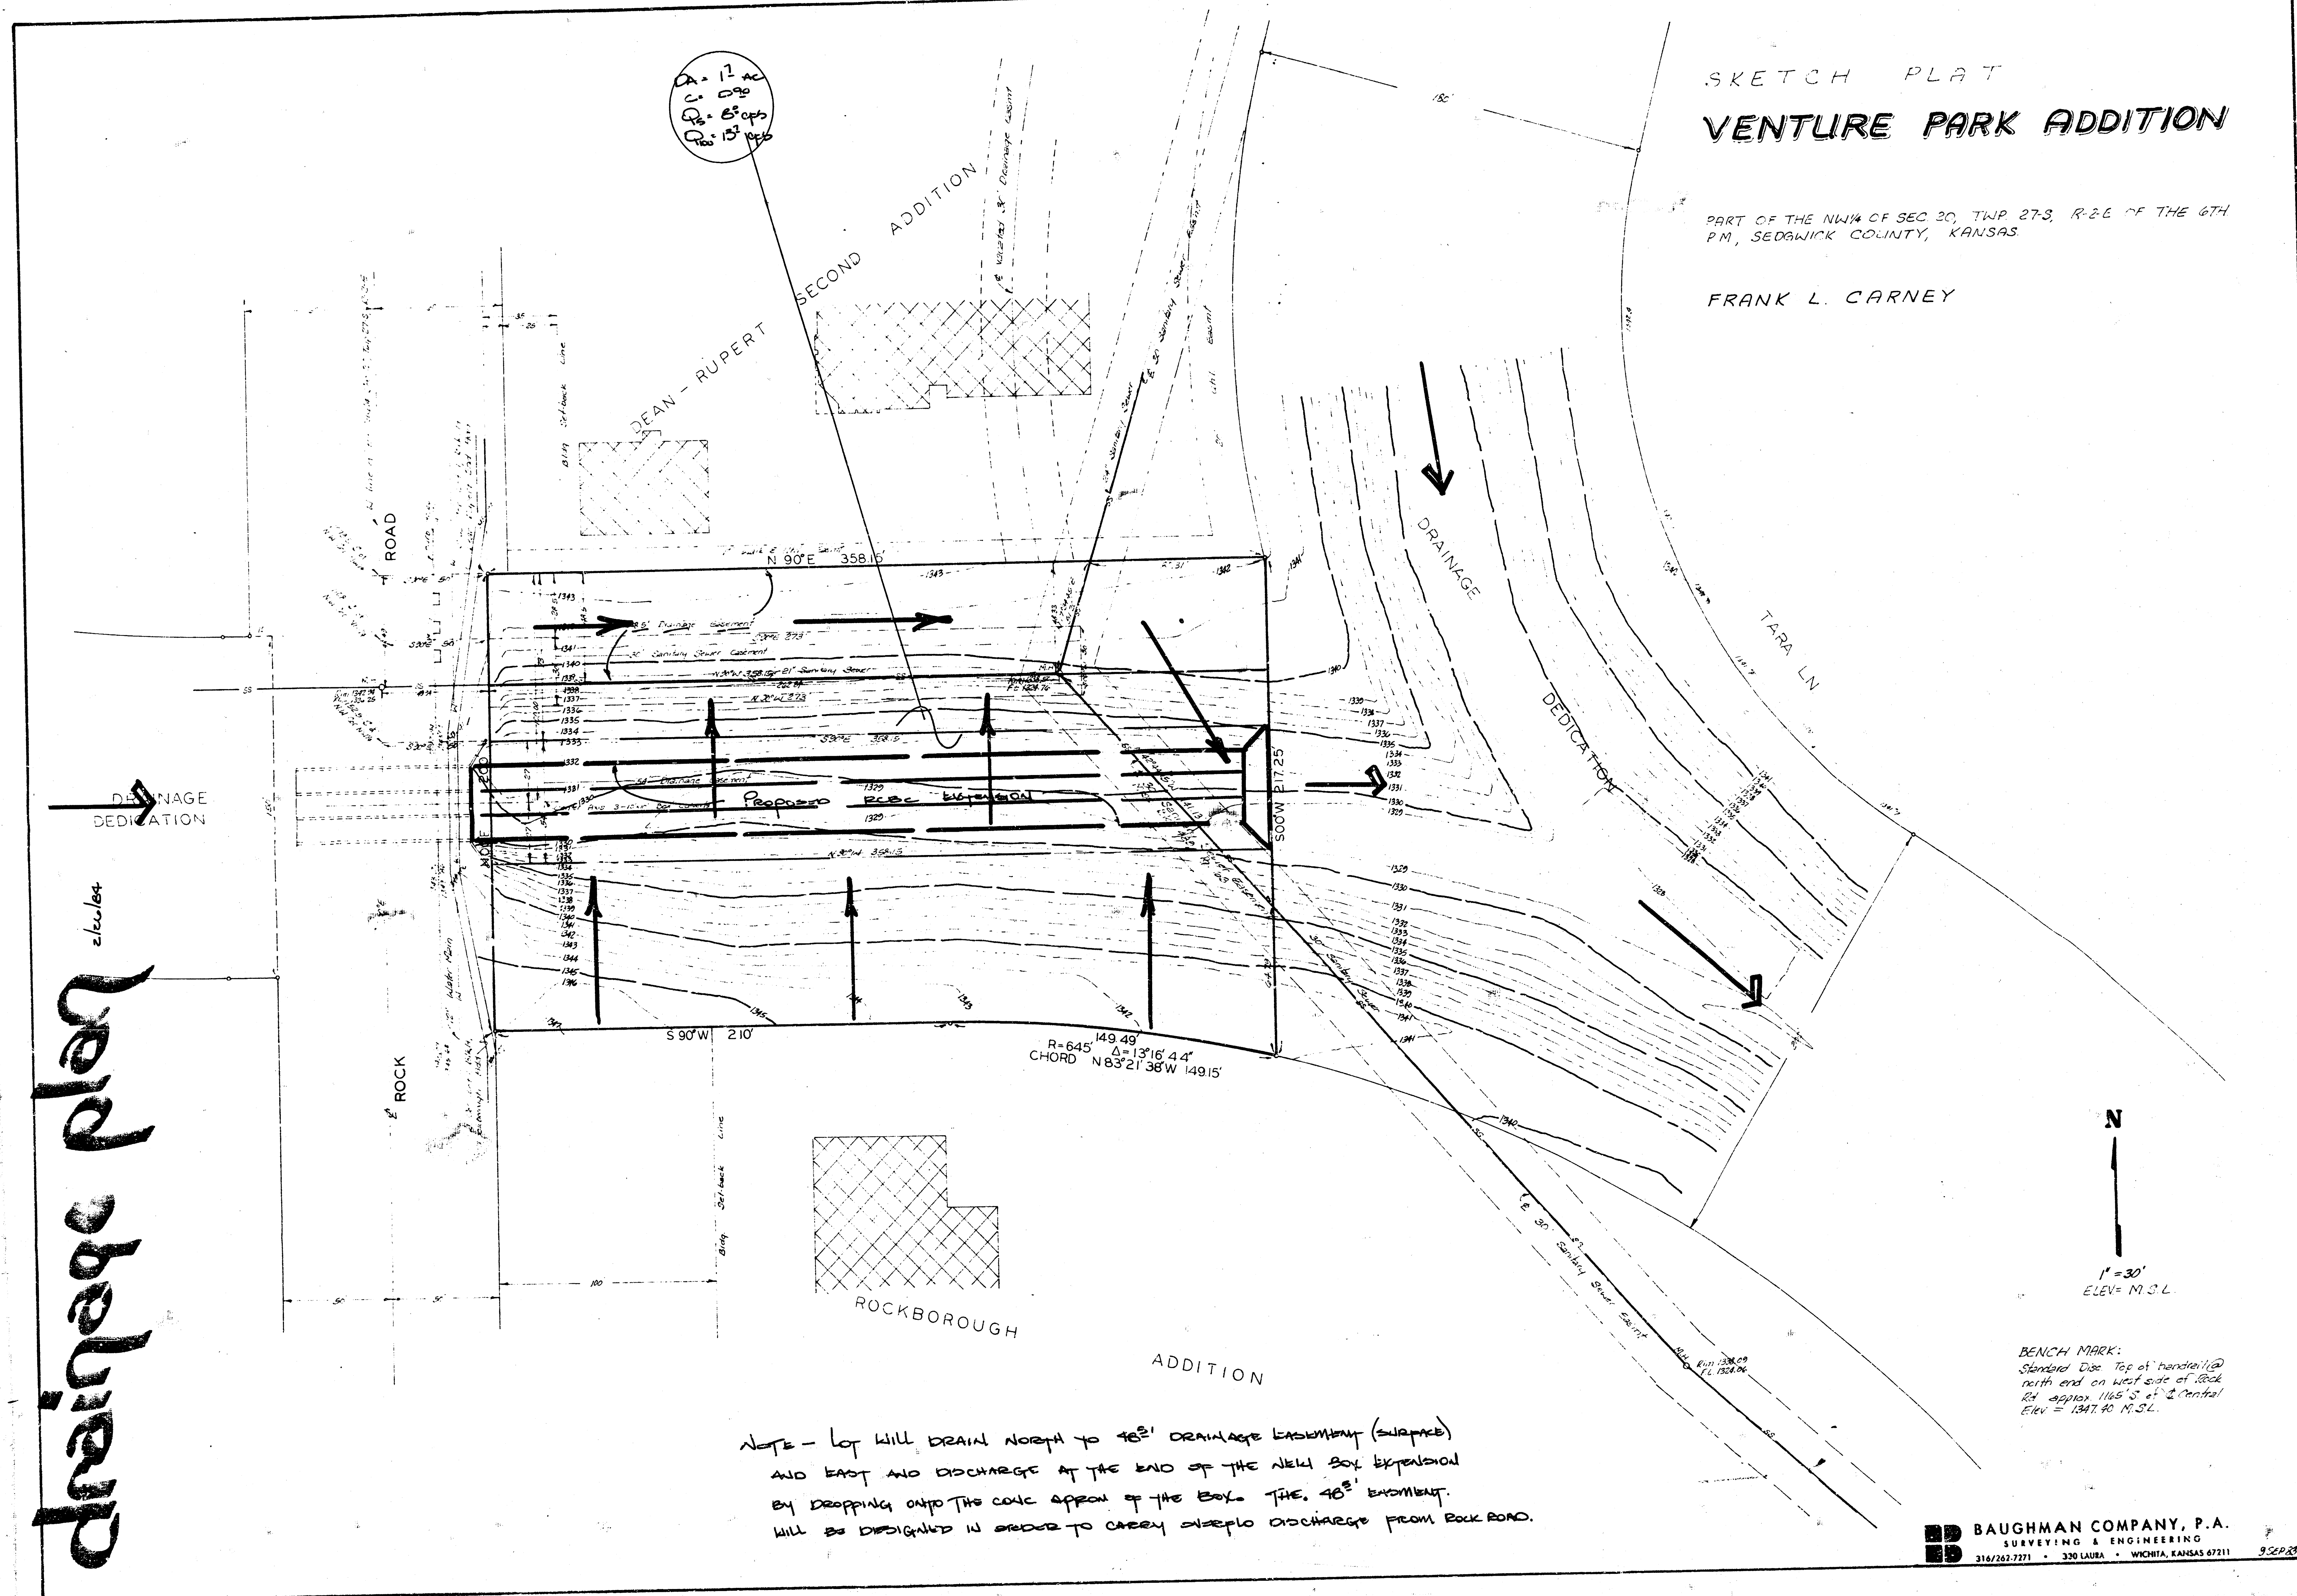

BENCH MARK:
Standard Disc Top of handrail @
north end on west side of Rock
Rd. approx. 1165' S. of 2 Central
Elev. = 1347.40 M.S.L.

BAUGHMAN COMPANY, P.A.
SURVEYING & ENGINEERING
316/267-7271 • 330 LAURA • WICHITA, KANSAS 67211