


Jesse Williams Addn

7

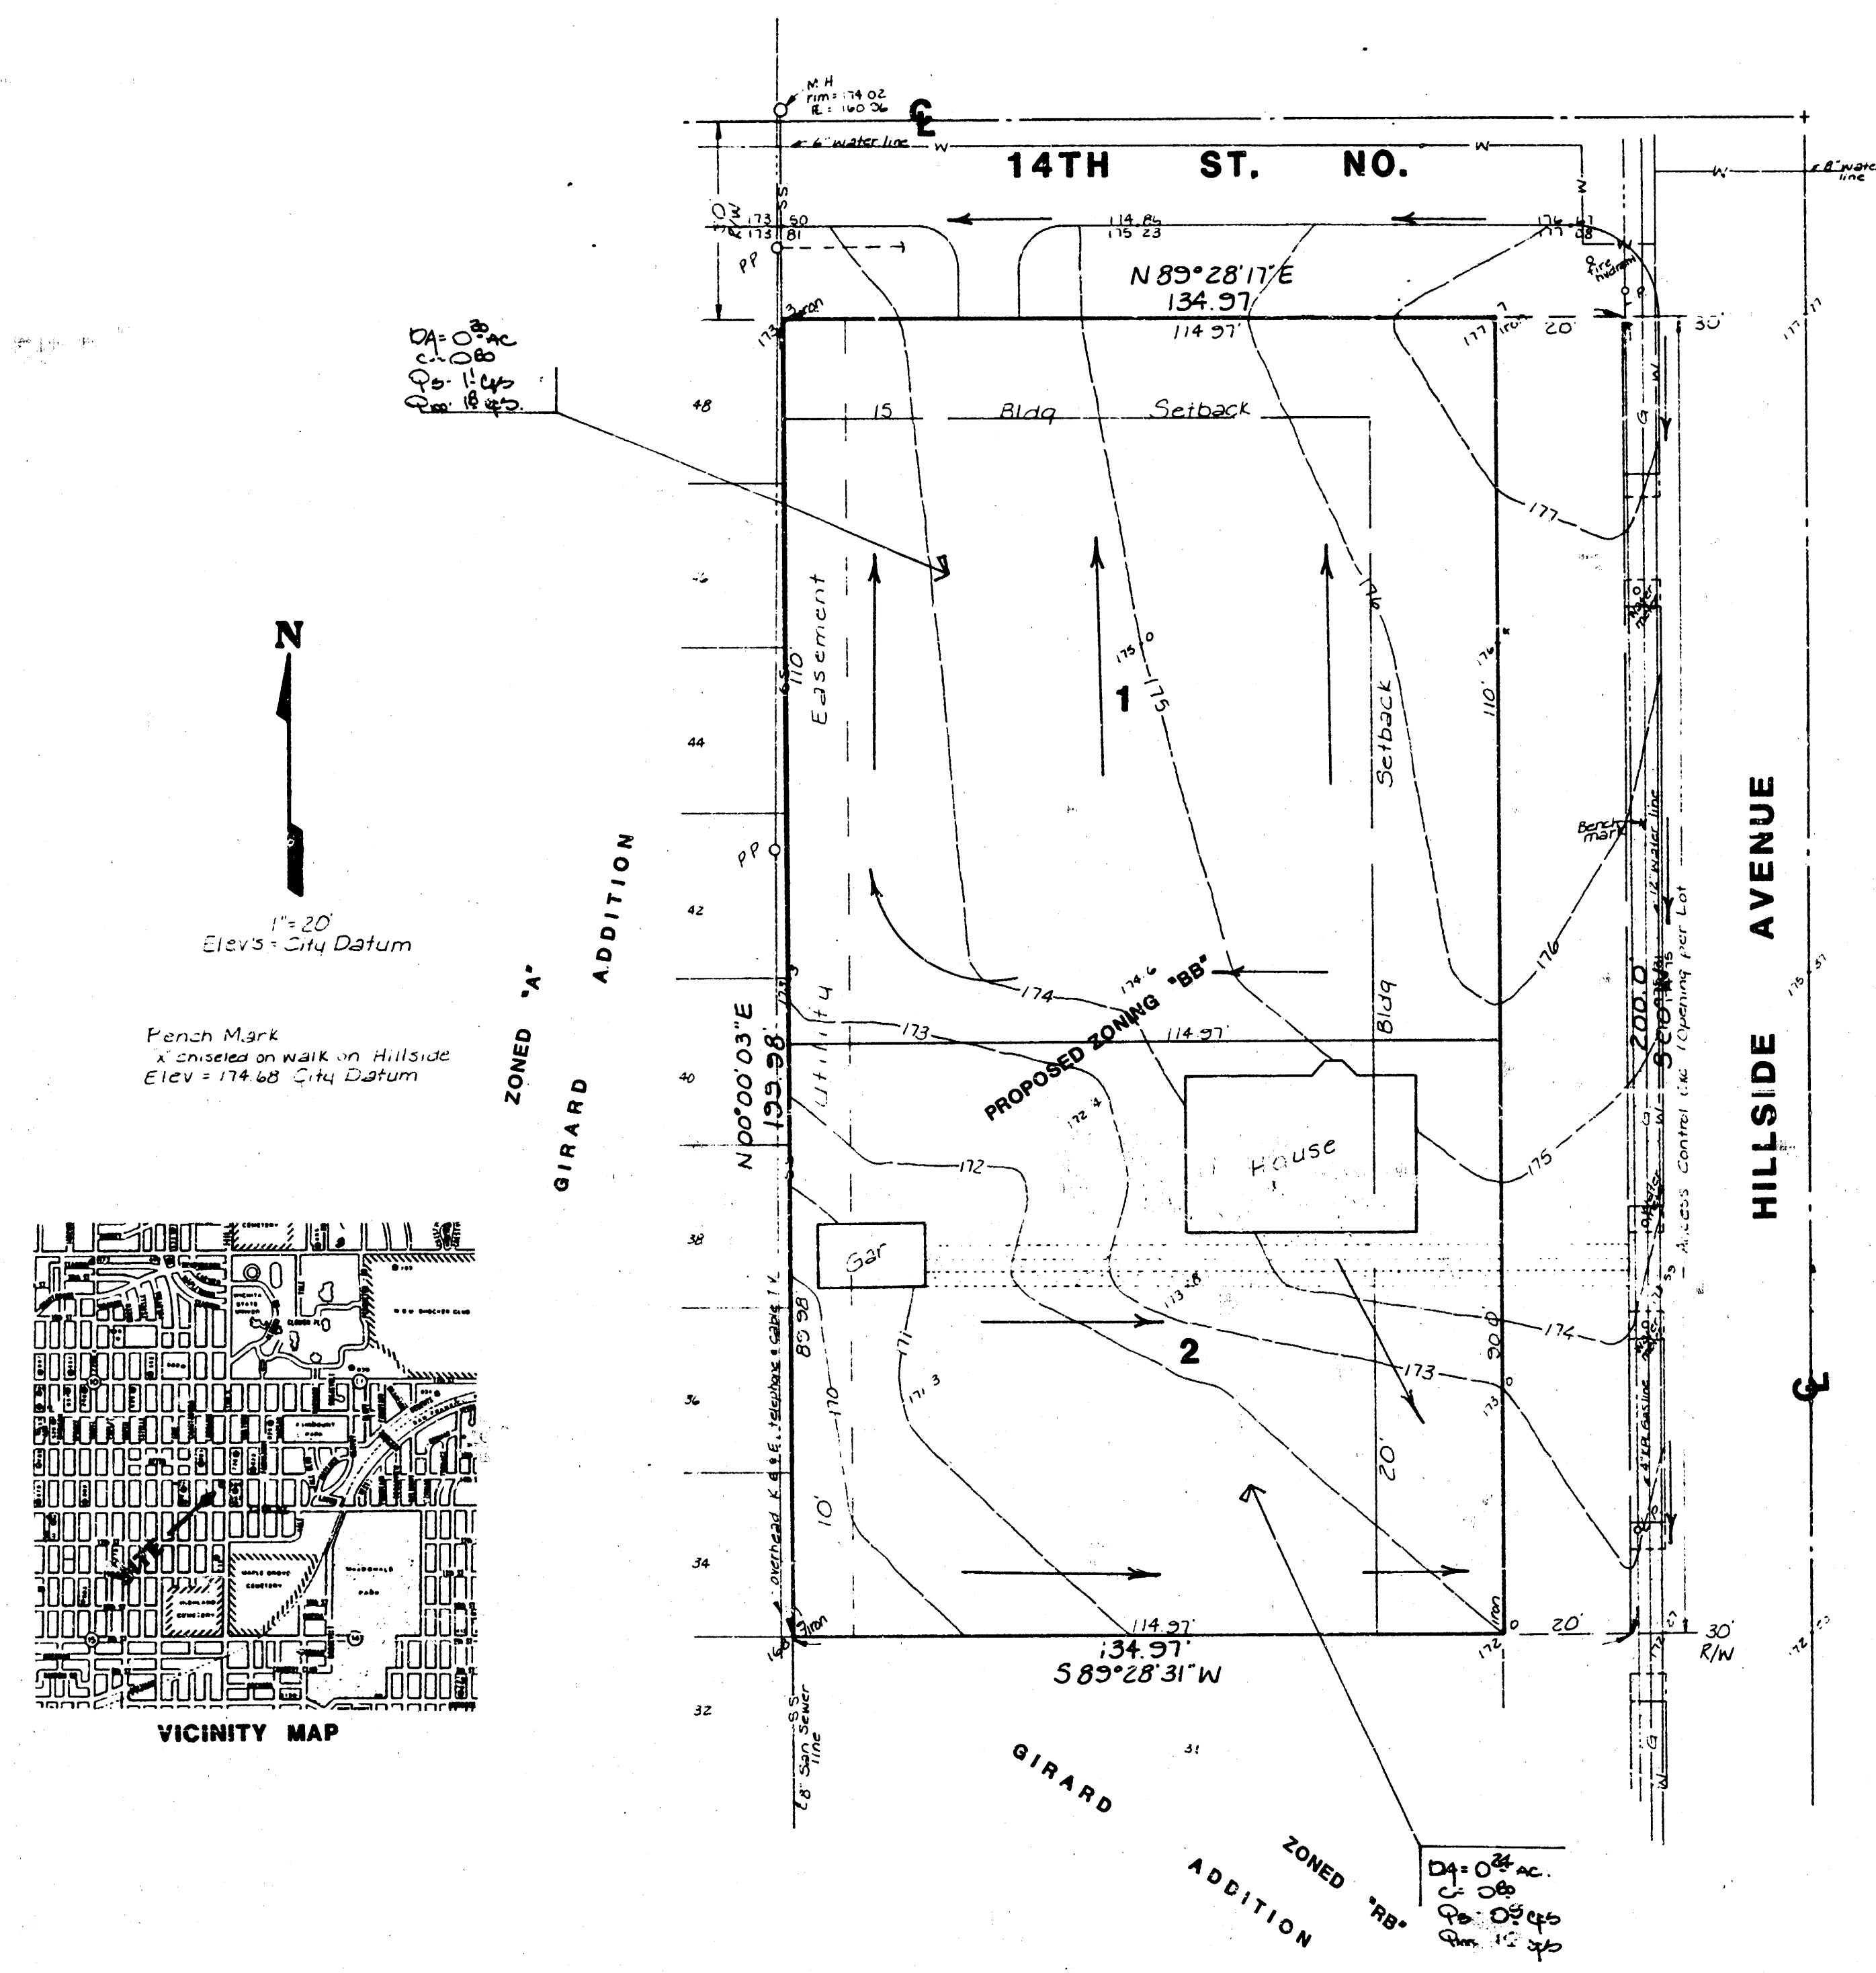

SKETCH PLAT

JESSE WILLIAMS ADDITION

LOTS 33, 35, 37, 39, 41, 43, 45, 47 ON HILLSIDE AVENUE IN GIRARD ADDITION, WICHITA, KANSAS

OWNER: JESSE AND GLORIA WILLIAMS

DRAINAGE PLAN

ED BAUGHMAN COMPANY, P.A.
SURVEYING & ENGINEERING
312-282-7271 • 313 PLUS • WICHITA, KANSAS 67211

2-5-20