




SCALE: 1"=6'

2000 2001 2002

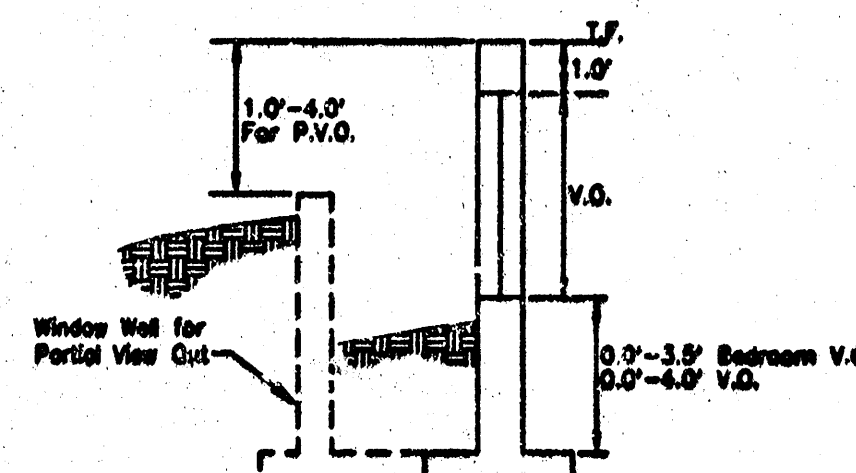

VIEW CUT & PARTIAL VIEW CUT DETAIL

APPROVED
CHANGE PLAN


LEGEND

VO	<i>VIEW OUT</i>
WO	<i>WALK OUT</i>
PVO	<i>PARTIAL VIEW OUT</i>
PWO	<i>PARTIAL WALK OUT</i>
NO VO	<i>NO VIEW OUT</i>

BENCHMARKS

BM #1 1/2 MILE EAST OF ROCK ROAD ON 21ST
COW BENCH MARK. NE COR. HUBGUARD ON RCBC.
ELEV. = 190.04

BM #2 TOP OF "T" POST + 7' NORTH OF THE SE
CORNER RESERVE "L" (SOUTH OF LOT 15, BLK. 5)
ELEV. = 195.00

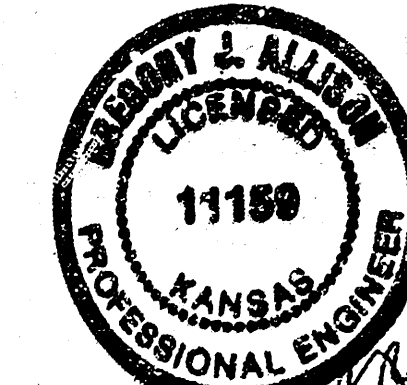

WILSON FARM SECOND ADDITION

GRADING PLAN

MEMO FOR THE RECORD



MID-KANSAS ENGINEERING

06186\90223\GRAD\CEAD1.DWG Thu Mar 30 09:50:35 2000