


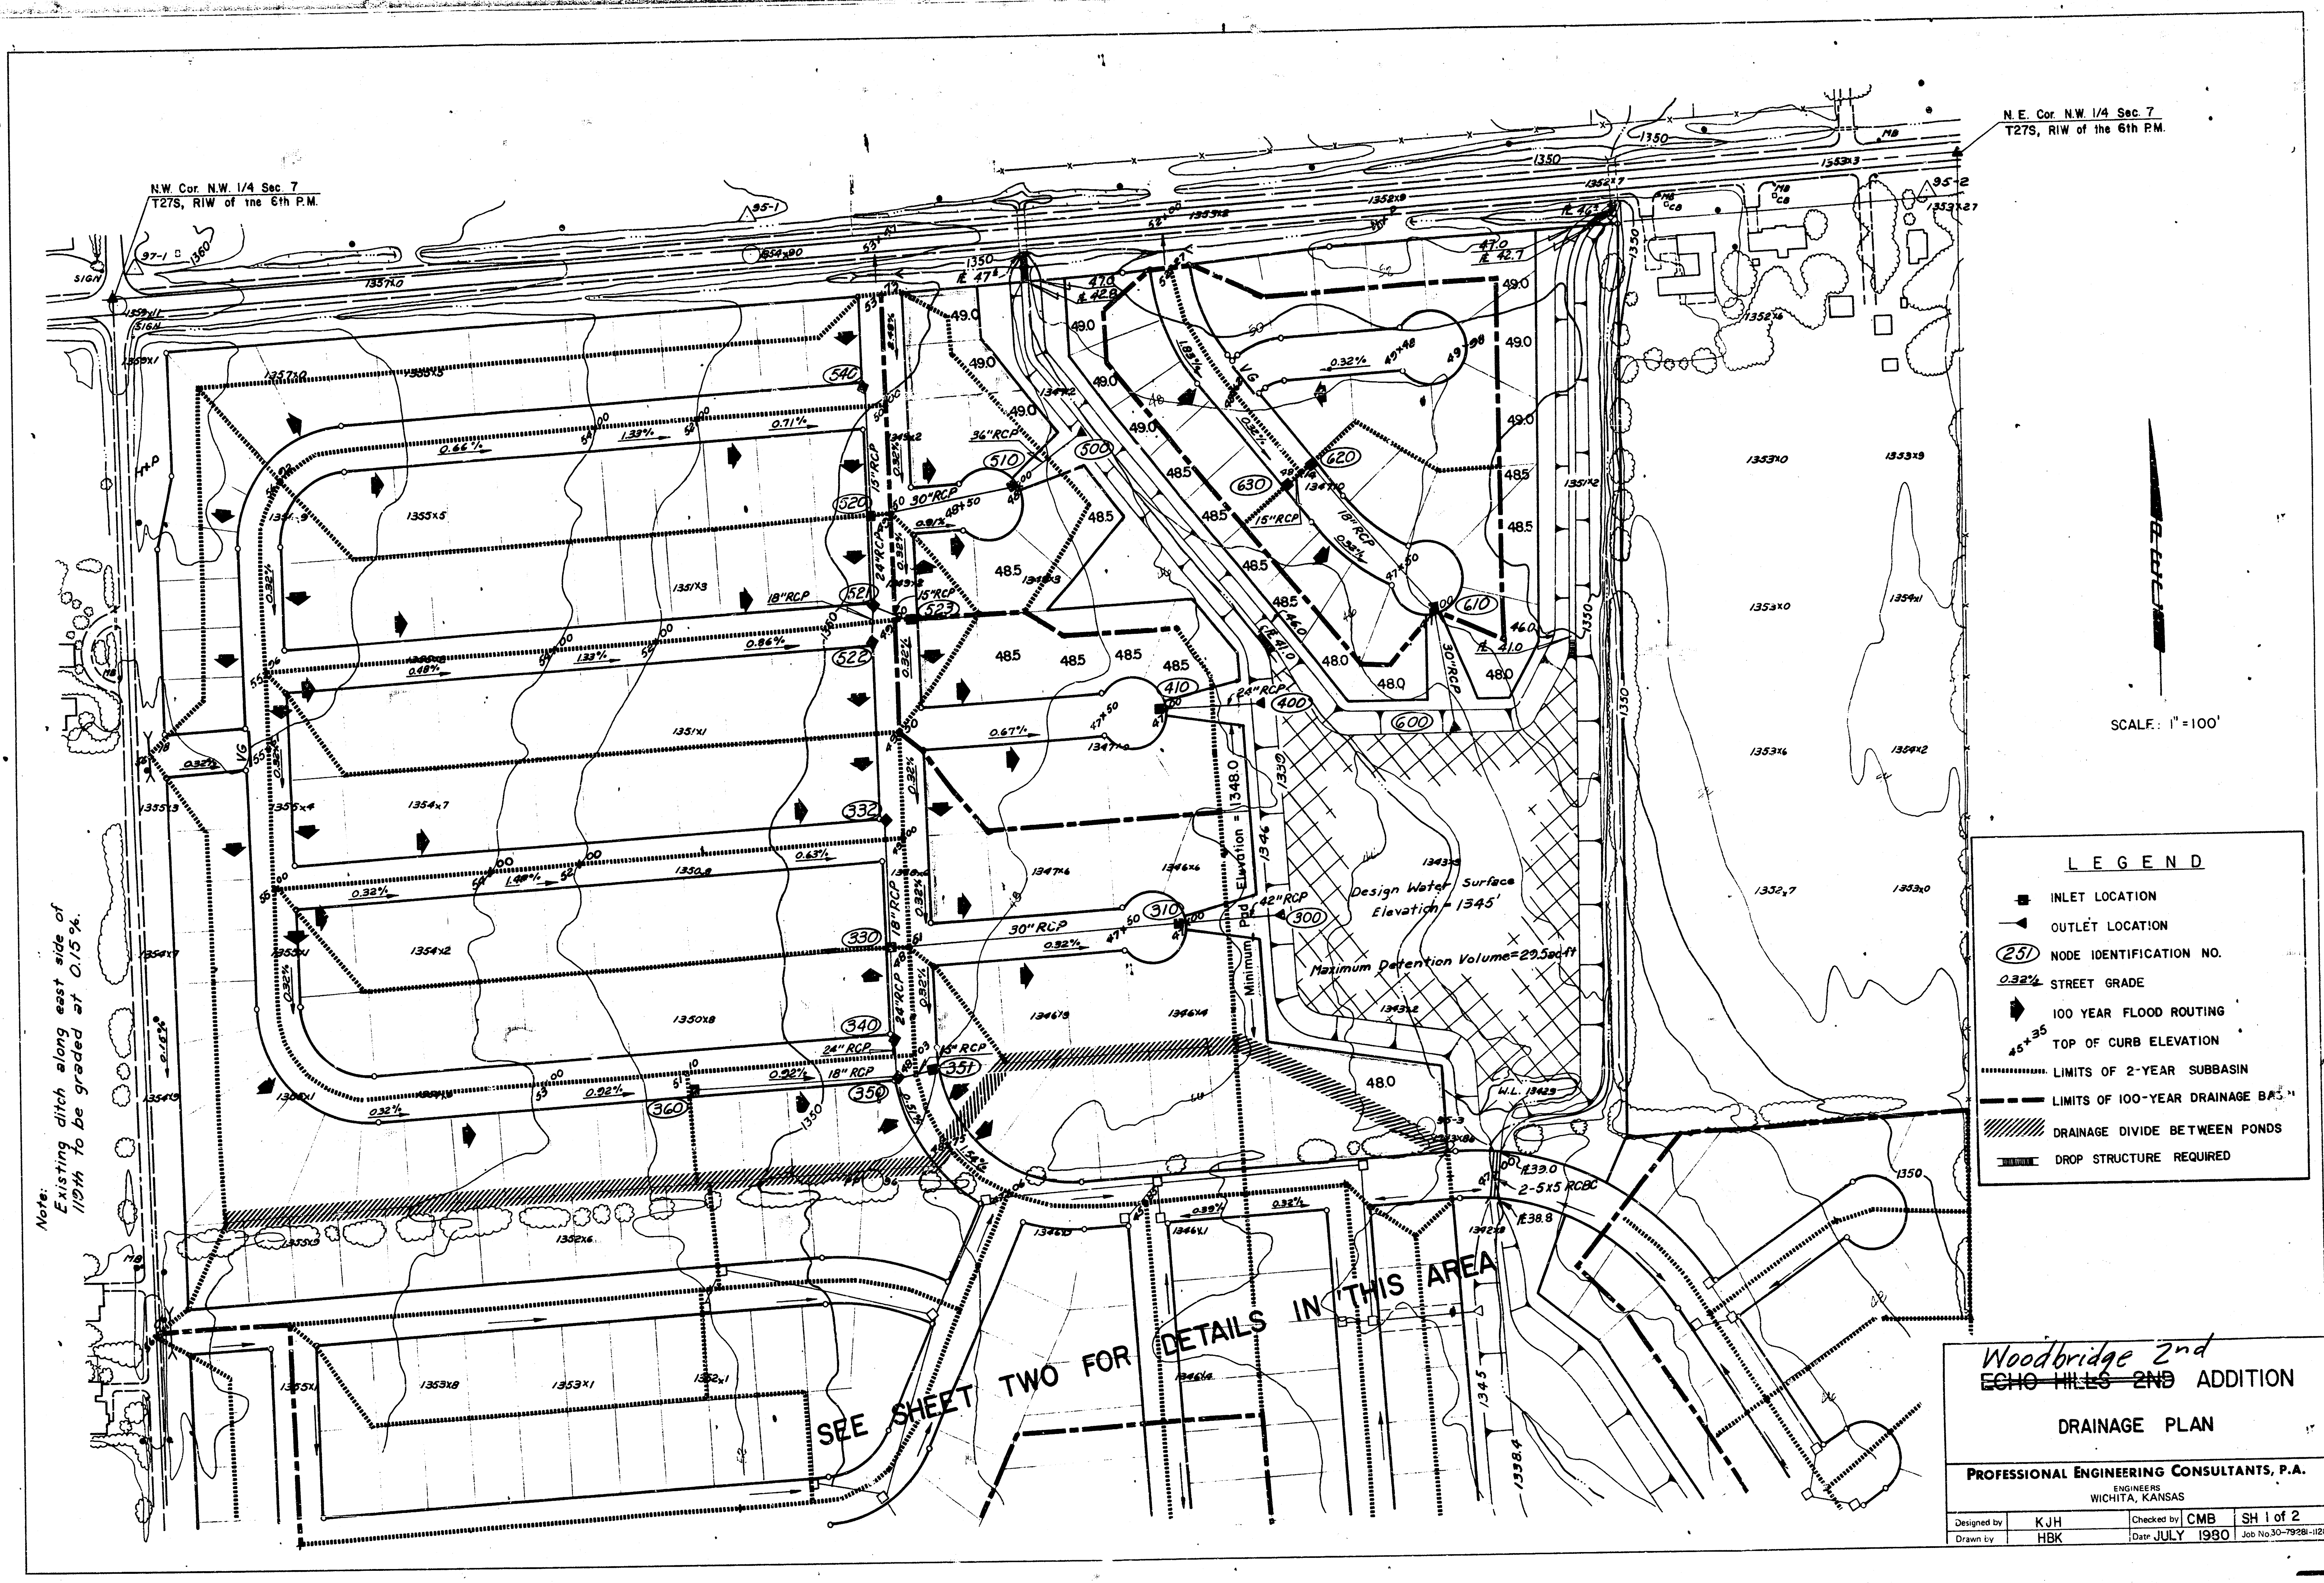

N.E. Cor. NW 1/4 Sec. 7  
T27S, R1W of the 6th P.M.

N.W. Cor. NW 1/4 Sec. 7  
T27S, R1W of the 6th P.M.

SCALE: 1"=100'

- LEGEND**
- INLET LOCATION
  - OUTLET LOCATION
  - NODE IDENTIFICATION NO.
  - STREET GRADE
  - 100 YEAR FLOOD ROUTING
  - TOP OF CURB ELEVATION
  - LIMITS OF 2-YEAR SUBBASIN
  - LIMITS OF 100-YEAR DRAINAGE BASIN
  - DRAINAGE DIVIDE BETWEEN PONDS
  - DROP STRUCTURE REQUIRED

Woodbridge 2nd  
ECHO HILLS 2ND ADDITION  
DRAINAGE PLAN

PROFESSIONAL ENGINEERING CONSULTANTS, P.A.  
ENGINEERS  
WICHITA, KANSAS

|             |        |            |           |                     |
|-------------|--------|------------|-----------|---------------------|
| Designed by | K.J.H. | Checked by | C.M.B.    | SH 1 of 2           |
| Drawn by    | H.B.K. | Date       | JULY 1980 | Job No. 30-7958-100 |