


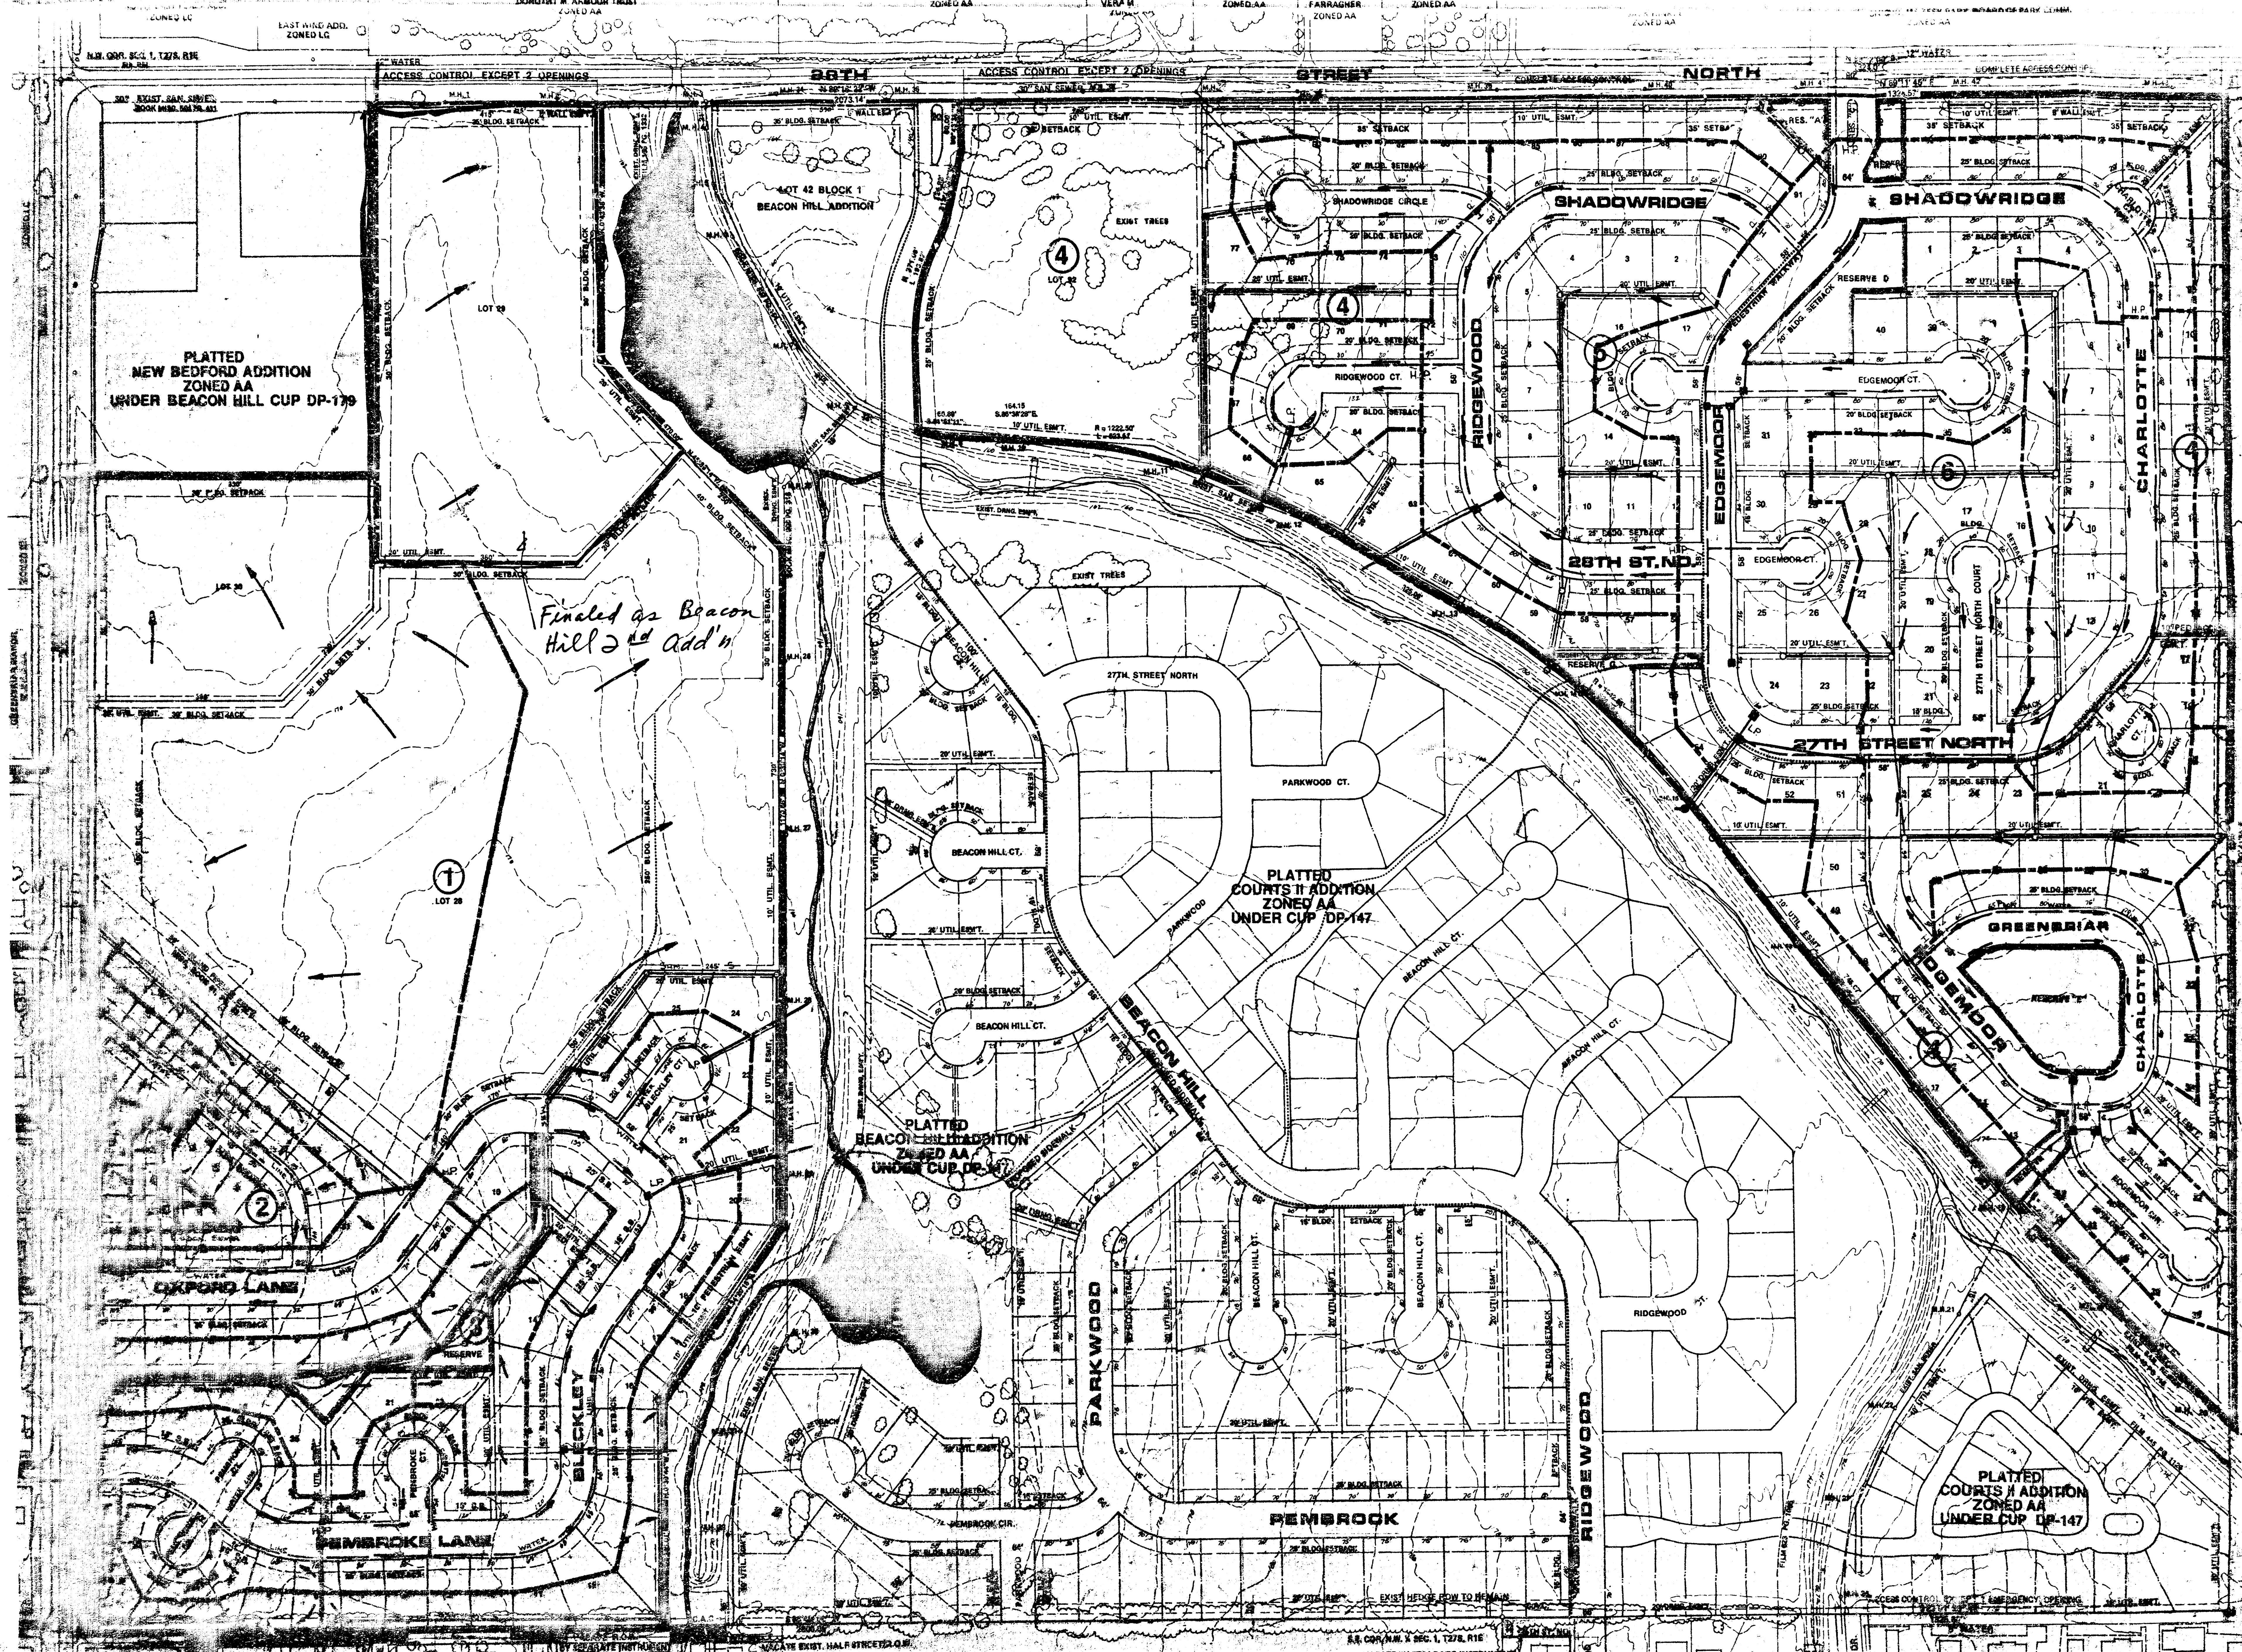

Finished as Beacon Hill 2nd Add'n

PLATTED COURTS II ADDITION
ZONED AA
UNDER CUP DP-147

PLATTED BEACON HILL ADDITION
ZONED AA
UNDER CUP DP-147



- NOTES**
- 1) SETBACKS ARE NOTED ON C.U.P., D.P.-147.
 - 2) BENCHMARK OF CITY OF WICHITA S.M. D.P.C. 34' N & 22' E OF CL OF BOTH ELEV. 100.00.
 - 3) RESERVES A, B, C, D, E, F, G, H, I, J, K, L, ARE TO PERMIT UTILITIES CONFINED TO EASEMENTS ONLY. DRAINAGE CONFINED TO EASEMENTS ONLY. LANDSCAPING, SIDEWALKS, AND OTHER SIMILAR RECREATION IMPROVEMENTS.