


# SEE REVISED SHEET

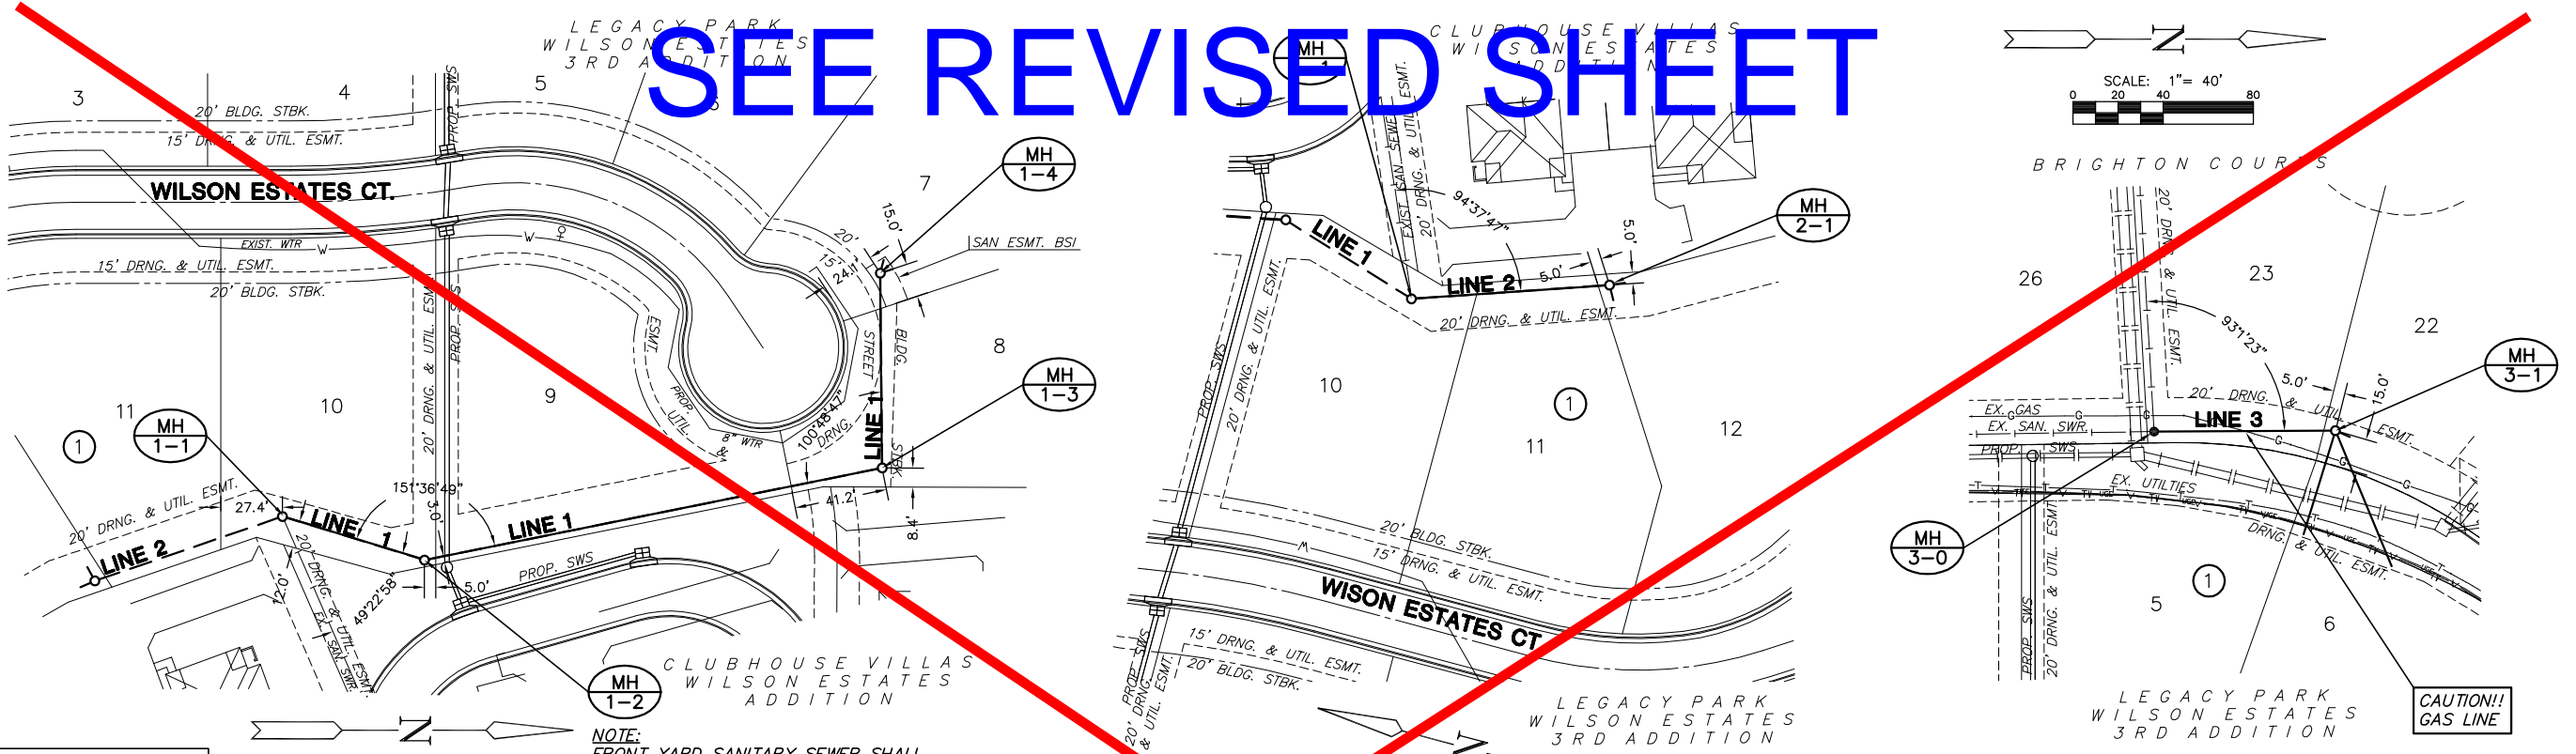


NOTE:  
CONTRACTOR TO VERIFY SIZE AND  
DEPTH OF THE EXISTING UTILITIES  
PRIOR TO CONSTRUCTION.

NOTE:  
FRONT YARD SANITARY SEWER SHALL  
BE SAND BACKFILLED & FLUSHED.  
STA. 12+72.8 TO STA. 13+59.3, LINE 1.

**PLAN LINE 1**

**PLAN LINE 2**

**PLAN LINE 3**

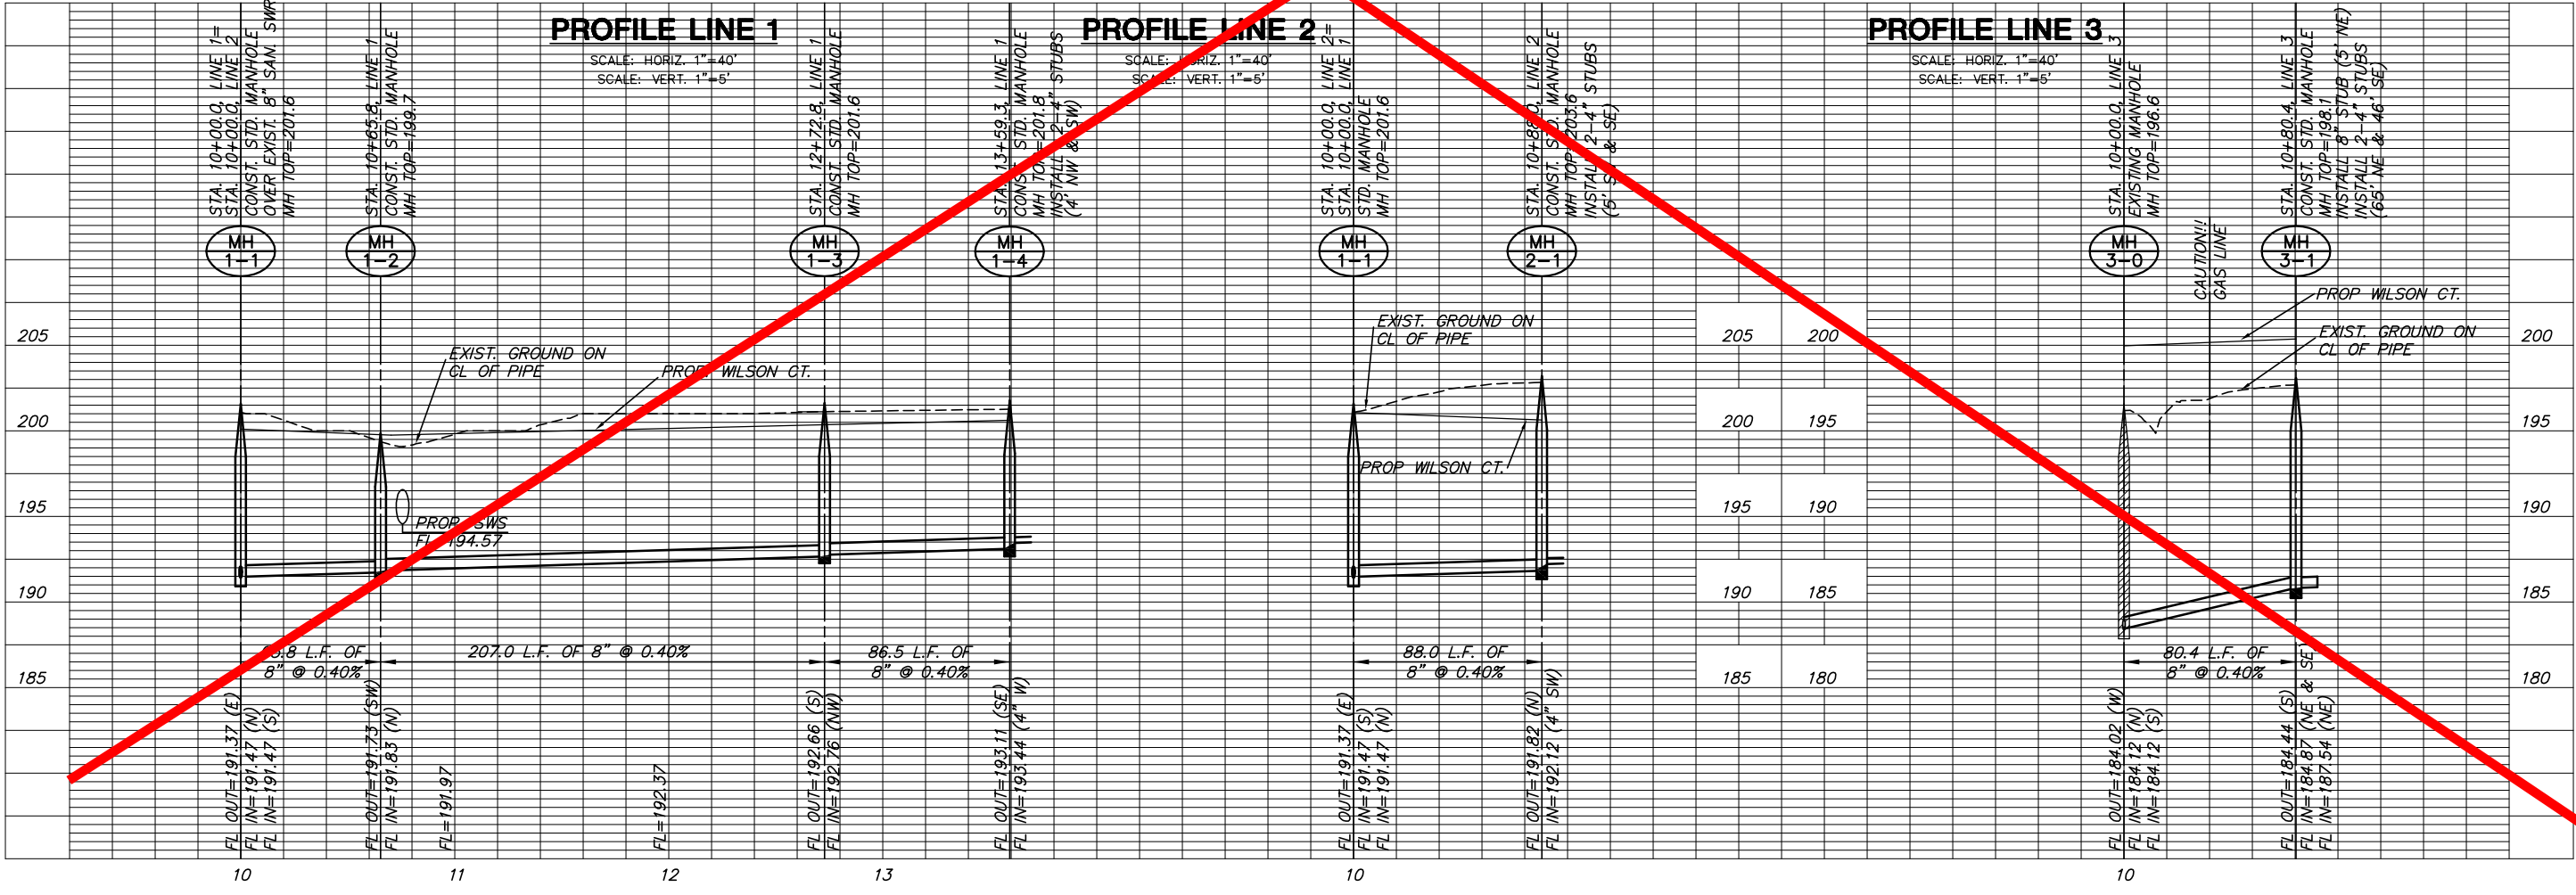

**PROFILE LINE 1**

**PROFILE LINE 2**

**PROFILE LINE 3**

**PUBLIC IMPROVEMENT PLANS FOR  
LEGACY PARK  
WILSON ESTATES 3RD ADD.  
WICHITA, KANSAS**

**LINE 1, 2, & 3**  
SHEET TITLE  
PROJECT NUMBER  
05753

DESIGN BY  
SRS  
DRAWN BY  
KWS  
CHECKED BY  
GLA

ISSUED  
JUNE 2006  
REVISED

SHEET NO.  
**5 of 25**