


SEE REVISED SHEET

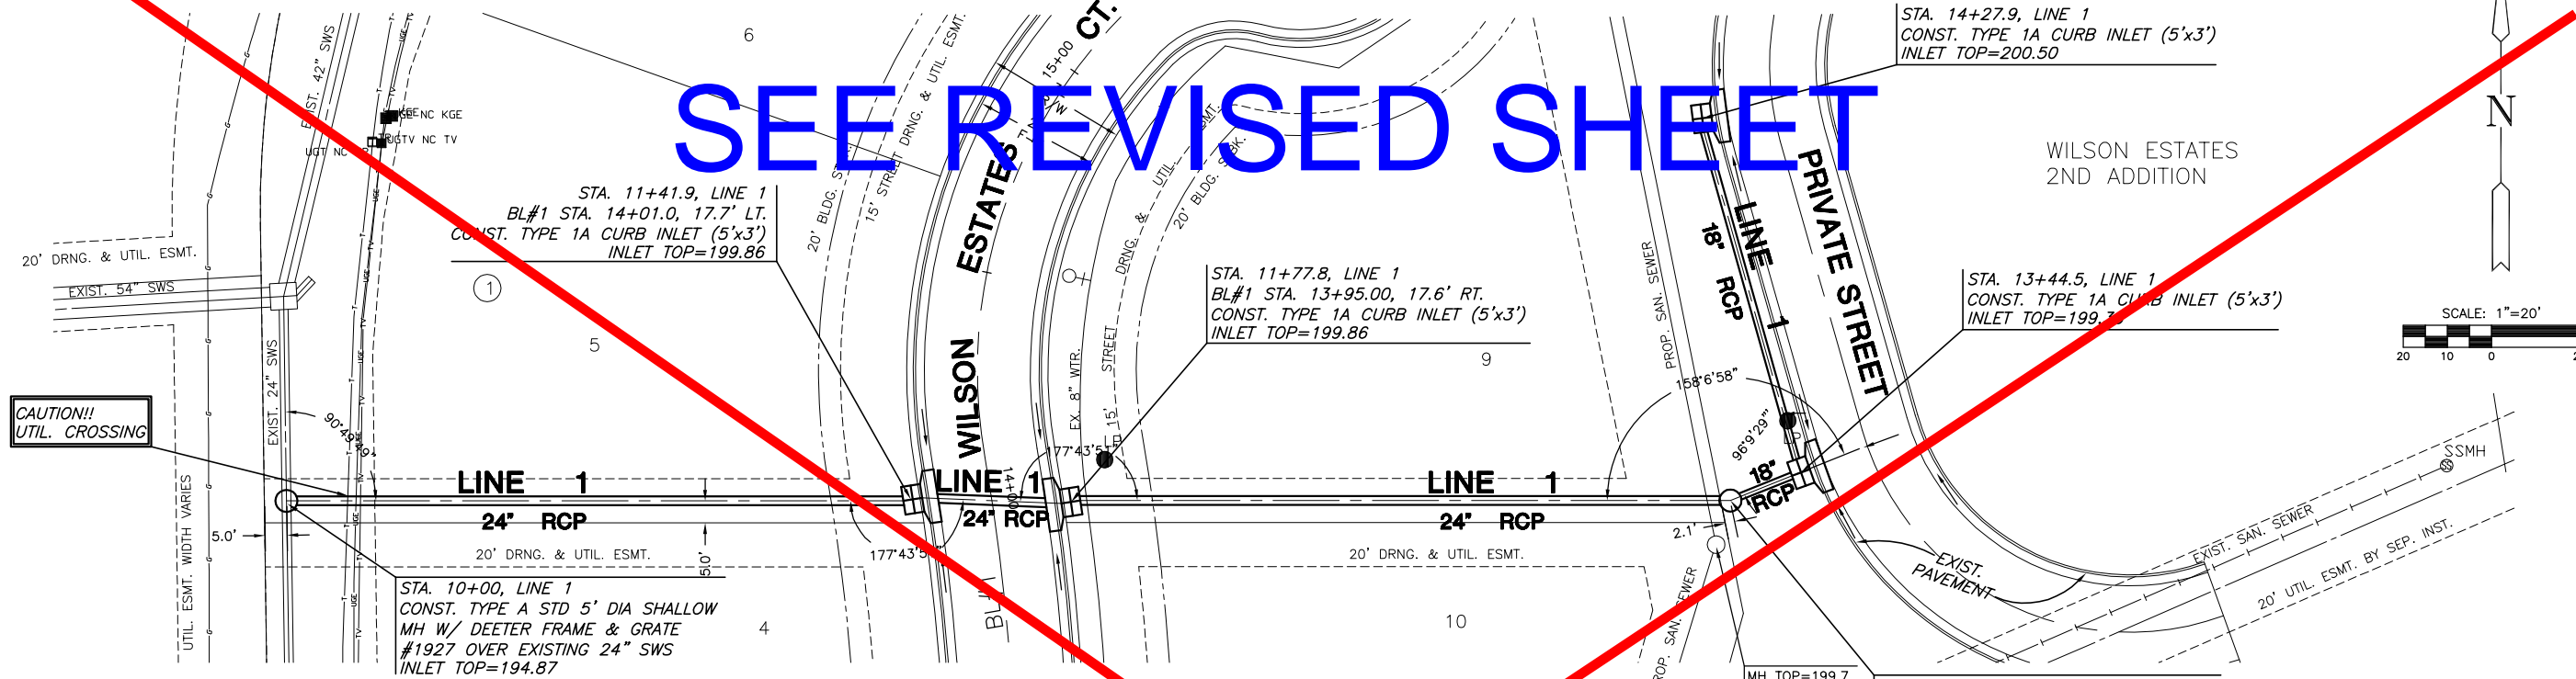


CAUTION!!
UTIL. CROSSING

NOTE:
CONTRACTOR TO VERIFY SIZE AND DEPTH OF THE EXISTING UTILITIES PRIOR TO CONSTRUCTION.

PLAN LINE

PROFILE LINE

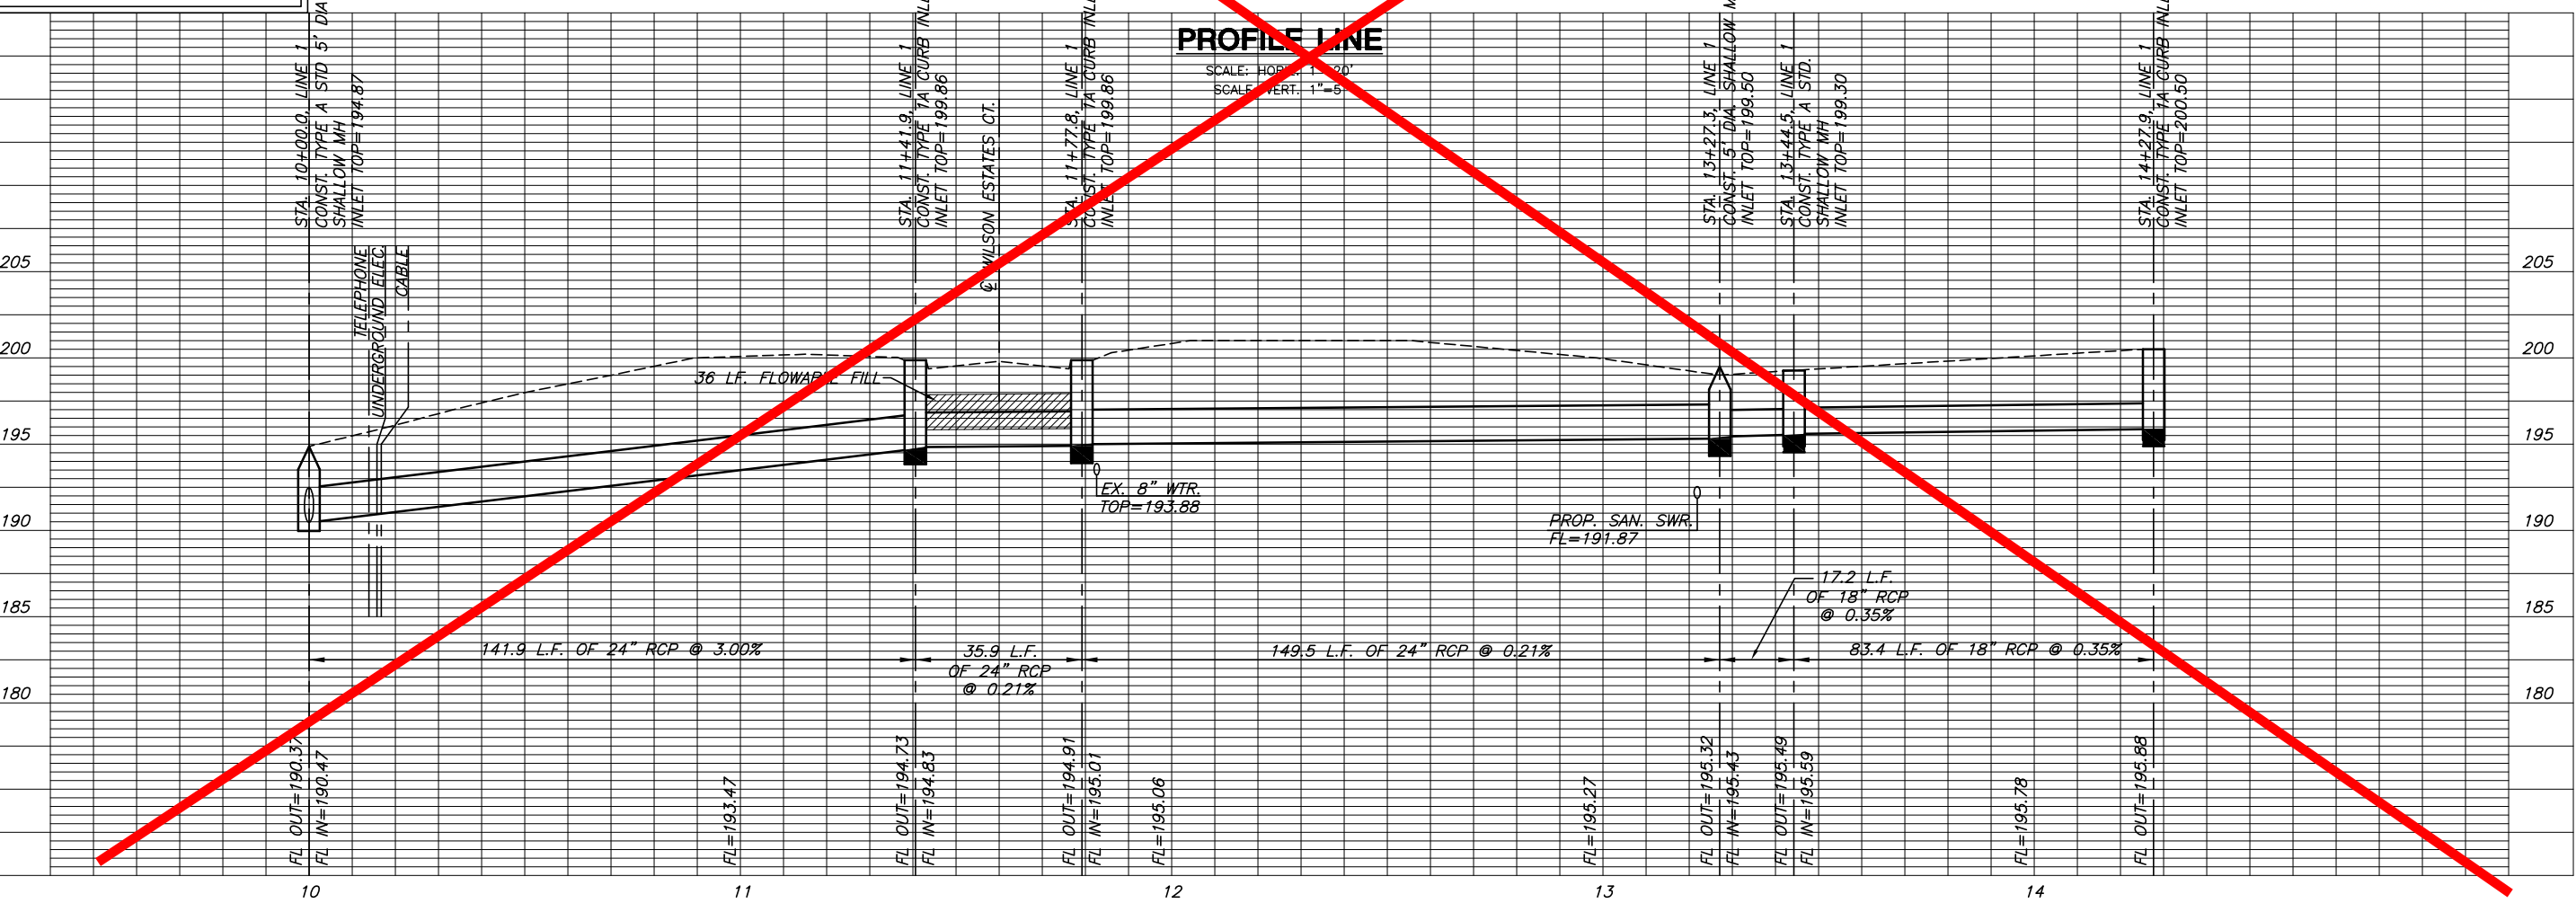

PUBLIC IMPROVEMENT PLANS FOR
LEGACY PARK
WILSON ESTATES 3RD ADD.
WICHITA, KANSAS

SWS
LINE 1
SHEET TITLE
PROJECT NUMBER
05753

DESIGN BY
SRS
DRAWN BY
KWS
CHECKED BY
GJA

ISSUED
JUNE 2006
REVISED

SHEET NO.
10 of 25